


DUNHAM & RASMUSSEN
SURVEYING & ENGINEERING
DELAVER, WISCONSIN

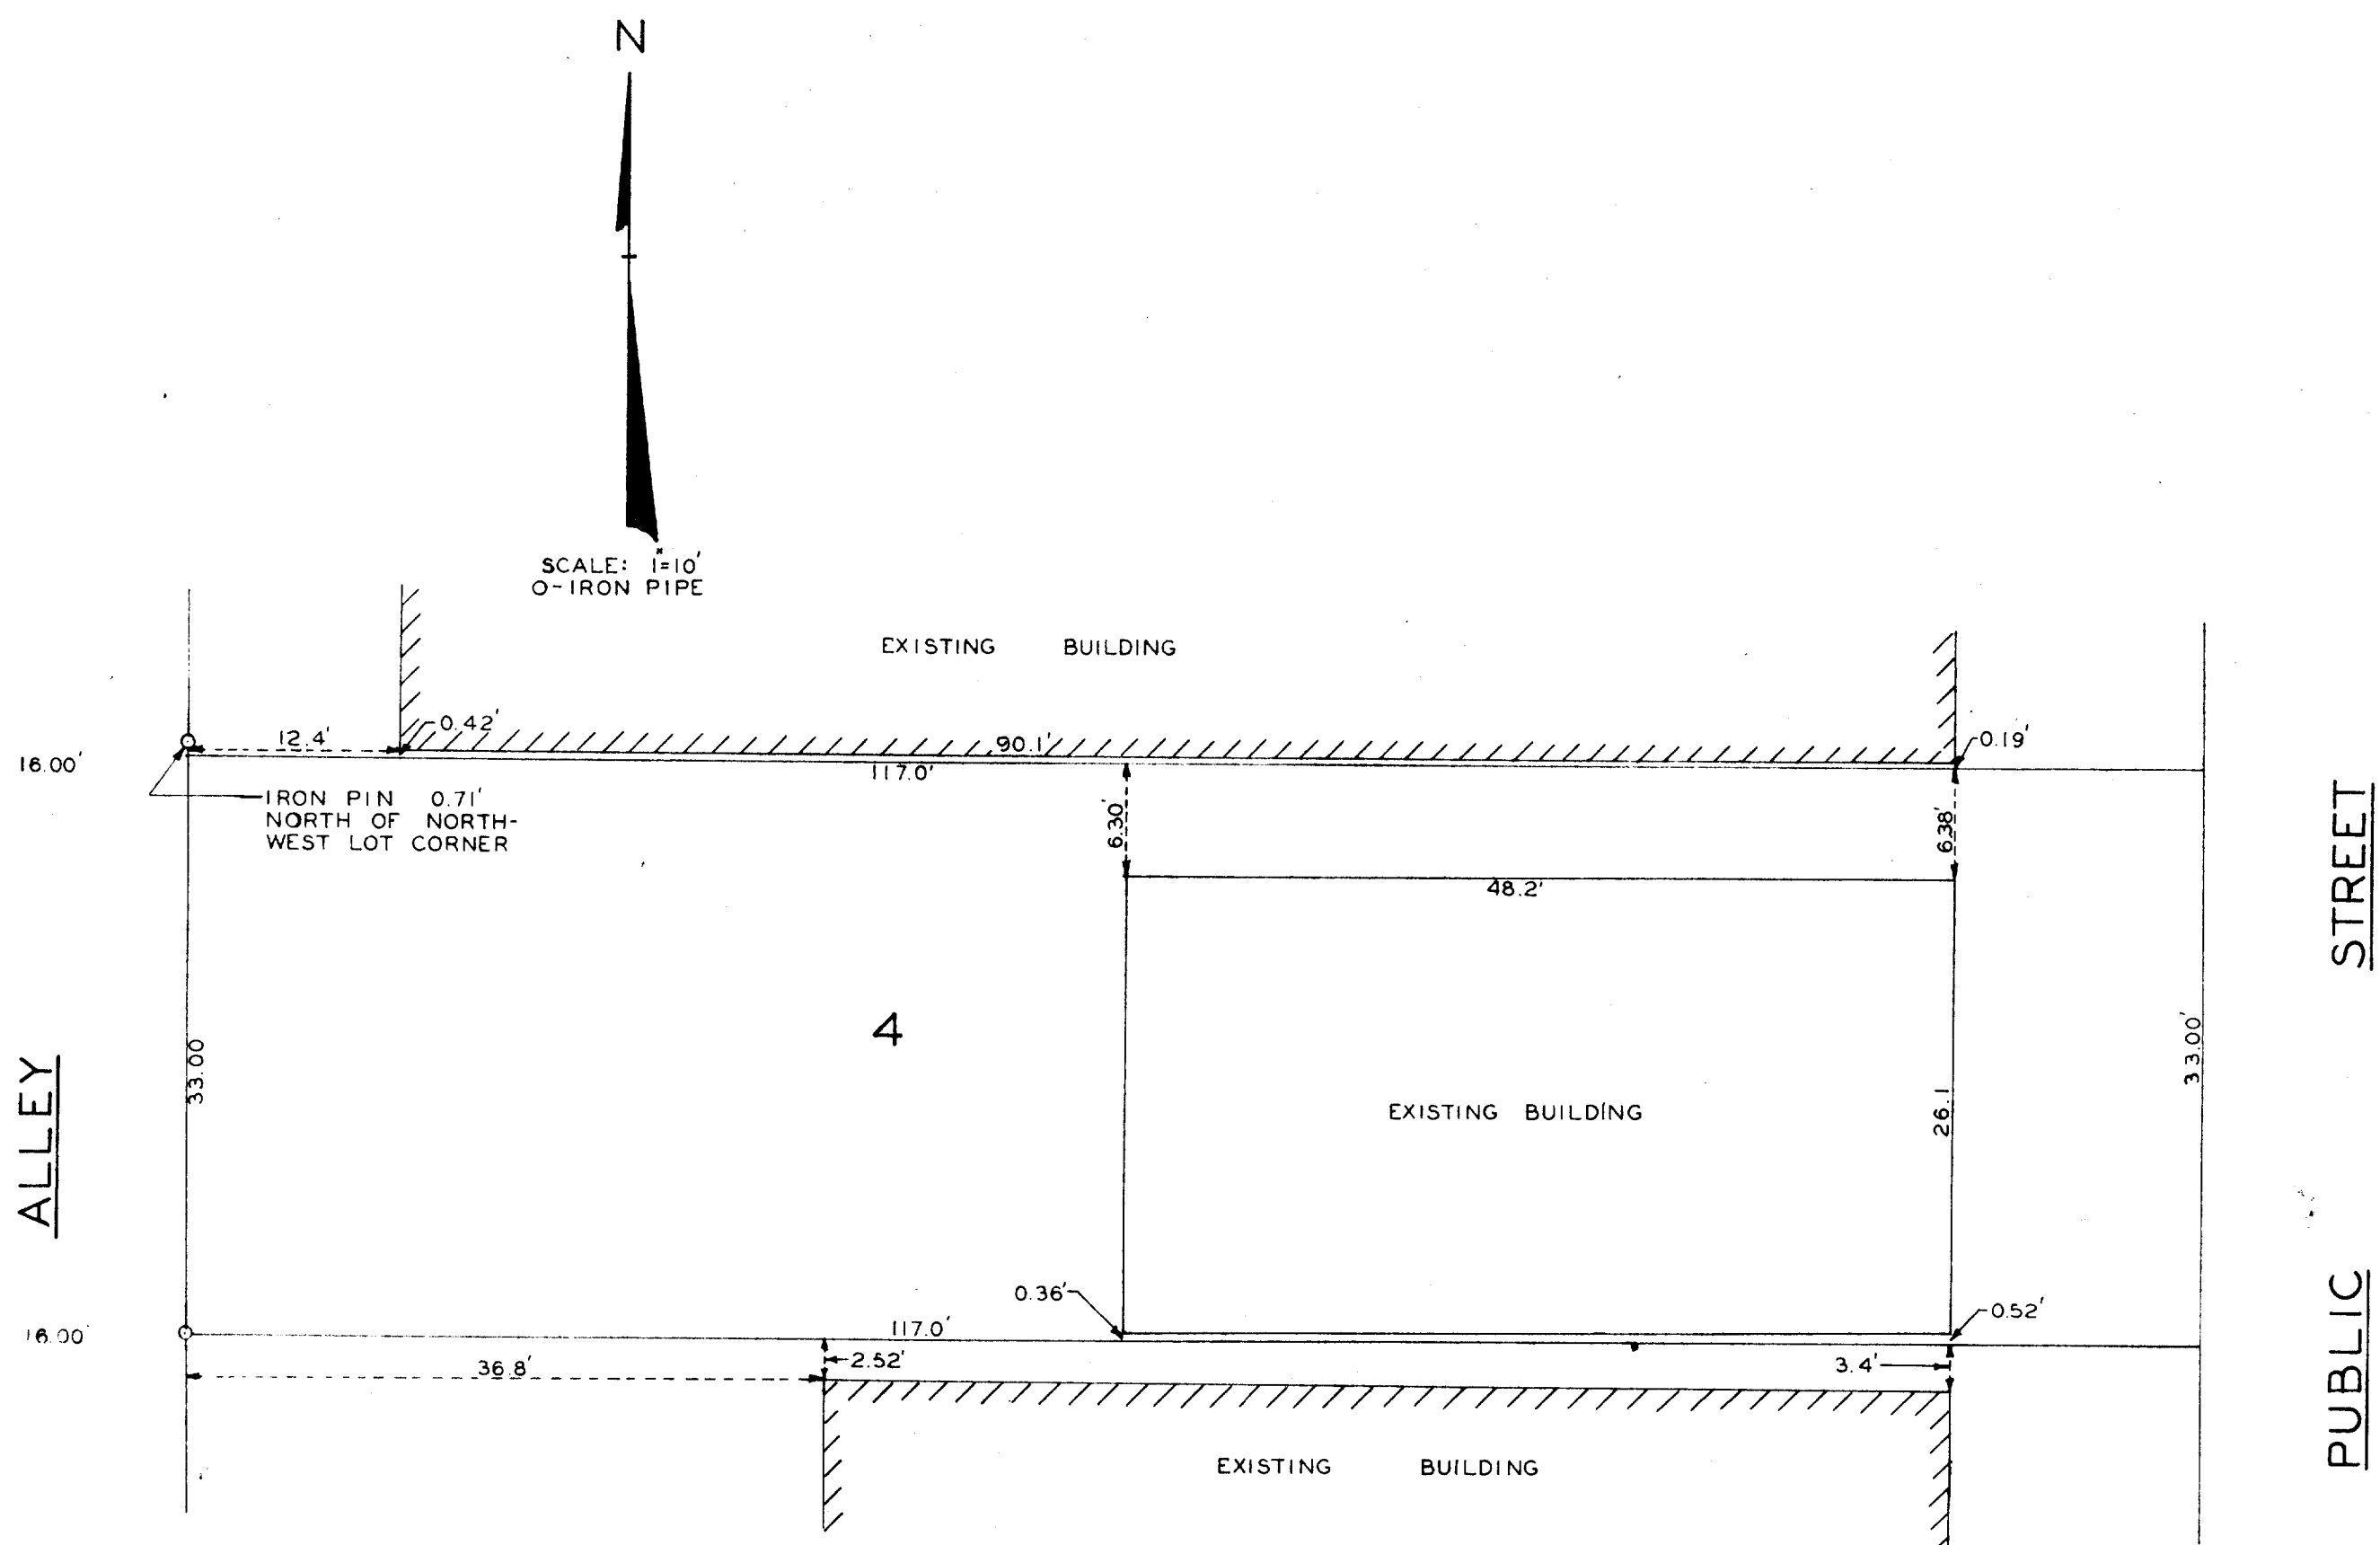

A Plat of Survey of Lot 4, Block 22, of Frey's Addition to
the Village of Darien, Walworth County, Wisconsin, and the improvements
located thereon.
November 14, 1960

George T. Dunham
George T. Dunham, Surveyor