


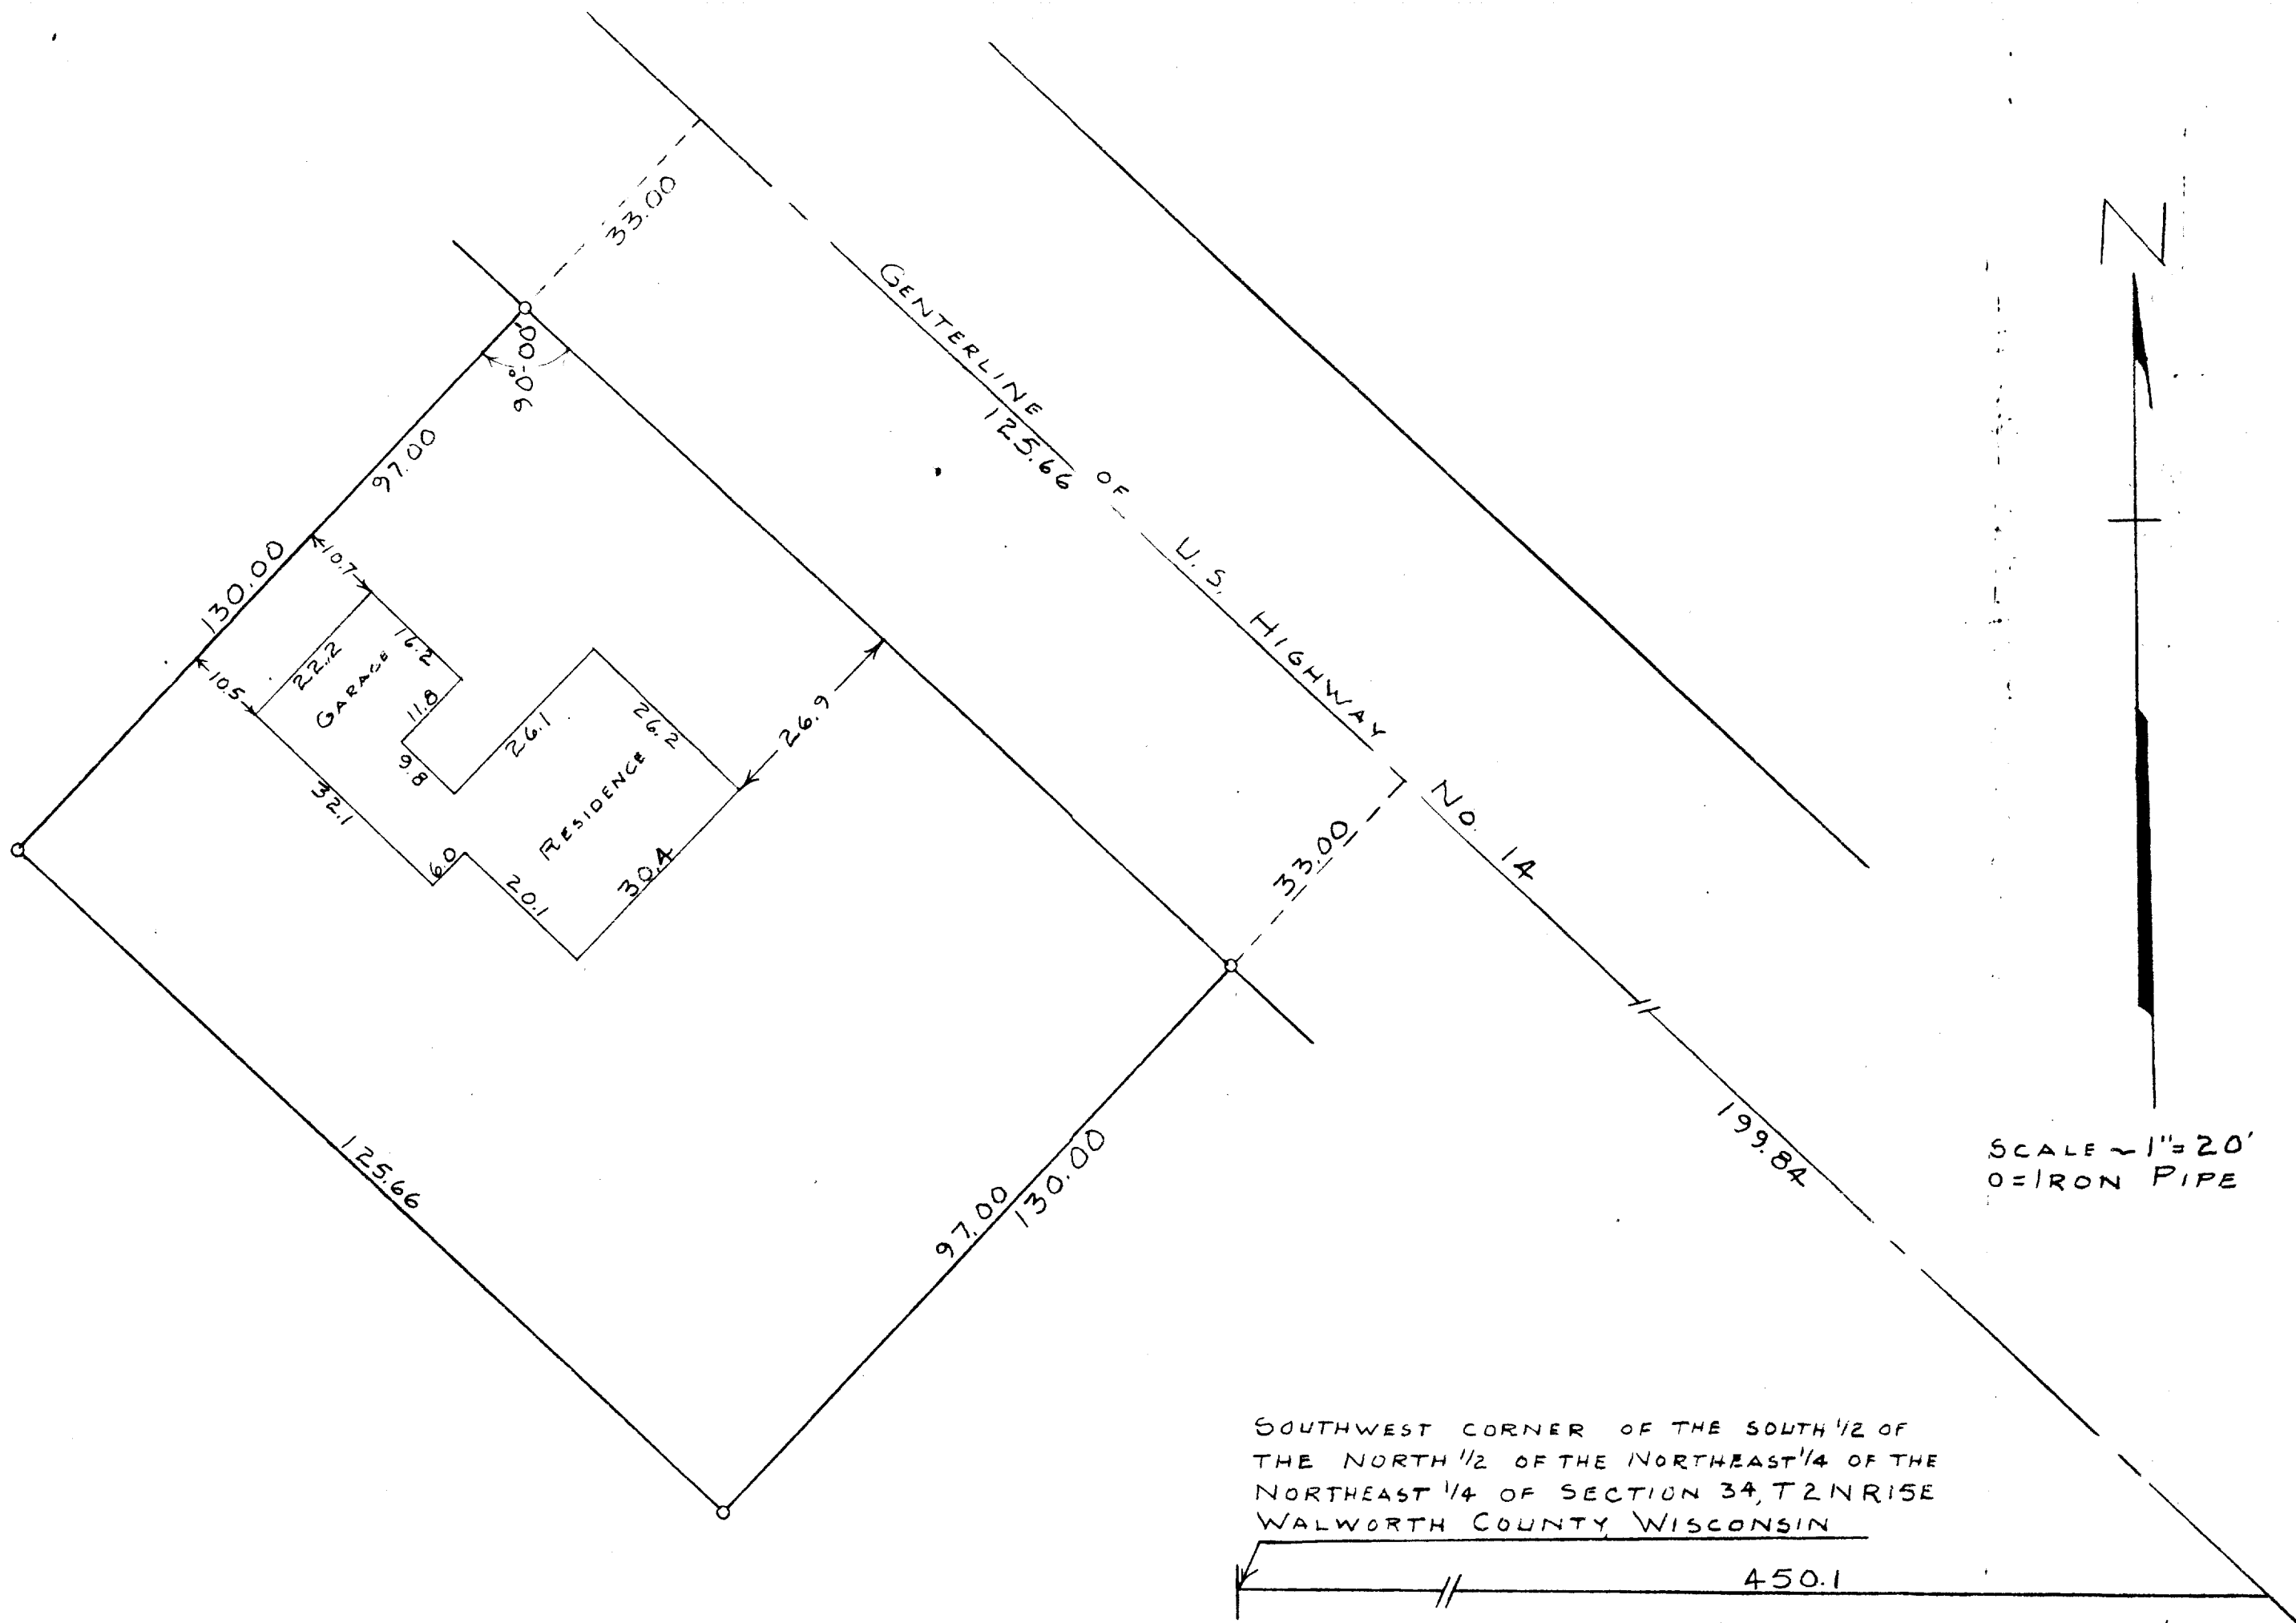

SOUTHWEST CORNER OF THE SOUTH $\frac{1}{2}$ OF
THE NORTH $\frac{1}{2}$ OF THE NORTHEAST $\frac{1}{4}$ OF THE
NORTHEAST $\frac{1}{4}$ OF SECTION 34, T2N R15E
WALWORTH COUNTY, WISCONSIN

STATE OF WISCONSIN)
WALWORTH COUNTY) ss

I, GEORGE T. DUNHAM, DO HEREBY CERTIFY THAT I HAVE SURVEYED THE PROPERTY DESCRIBED AS FOLLOWS:

A PARCEL OF LAND LOCATED IN THE S $\frac{1}{2}$ OF THE N $\frac{1}{2}$ OF THE NE $\frac{1}{4}$ OF THE NE $\frac{1}{4}$ OF SECTION 34, T2N R15E OF WALWORTH COUNTY, WISCONSIN, DESCRIBED AS FOLLOWS, TO-WIT: COMMENCING AT THE SW CORNER OF SAID S $\frac{1}{2}$; THENCE EAST ALONG THE S. LINE OF SAID S $\frac{1}{2}$, 450.1 FEET TO THE $\angle$ OF U.S. HIGHWAY NO. 14; THENCE NW ALONG THE $\angle$ OF SAID HIGHWAY 199.84 FEET TO THE PLACE OF BEGINNING; THENCE SW AT RIGHT ANGLES TO SAID $\angle$ 130.00 FEET; THENCE NW PARALLEL TO SAID $\angle$ 125.66 FEET; THENCE NE 130.00 FEET TO SAID $\angle$; THENCE SE ALONG SAID $\angle$ 125.66 FEET TO THE PLACE OF BEGINNING.

AND THAT THE PLAT SHOWN ABOVE IS A CORRECT REPRESENTATION OF THE PROPERTY LINES AND OF THE IMPROVEMENTS LOCATED THEREON
SEPT. 1959

George T. Dunham
GEORGE T. DUNHAM, SURVEYOR
DELAWARE, WISC.

1-117

VD-133