

PLAT OF SURVEY


Two parcels of land located in part of the N¹/₄ and part of the S¹/₄ of Sec. 27
Town 2 North, Range 18 East, described as follows:

Beginning at a concrete monument described as the SW Cor of the S¹/₄ of the N¹/₄
Section 27, T2N, R18E; thence N45°04'E, 56.60 feet; thence S30°55'E, 203.35 feet to a
point described on the centerline of Beloit Street; thence along said described
centerline S58°47'48"W, 168.24 feet; thence N0°10'E, 221.64 feet to the point of
beginning.

Parcel contains .49 AC+ with road R/W.
Also:

Commencing at a concrete monument described as the SW Cor of the S¹/₄ of the N¹/₄
Section 27, T2N, R18E; thence N45°04'E, 56.60 feet to the point of beginning; thence
continuing N45°04'E, 278.00 feet; thence S30°55'E, 203.35 feet to a point described on
the centerline of Beloit Street; thence along said described centerline S58°47'48"W,
269.77 feet; thence N30°55'E, 203.35 feet to the point of beginning.

Parcel contains 1.46 AC+ with road R/W.

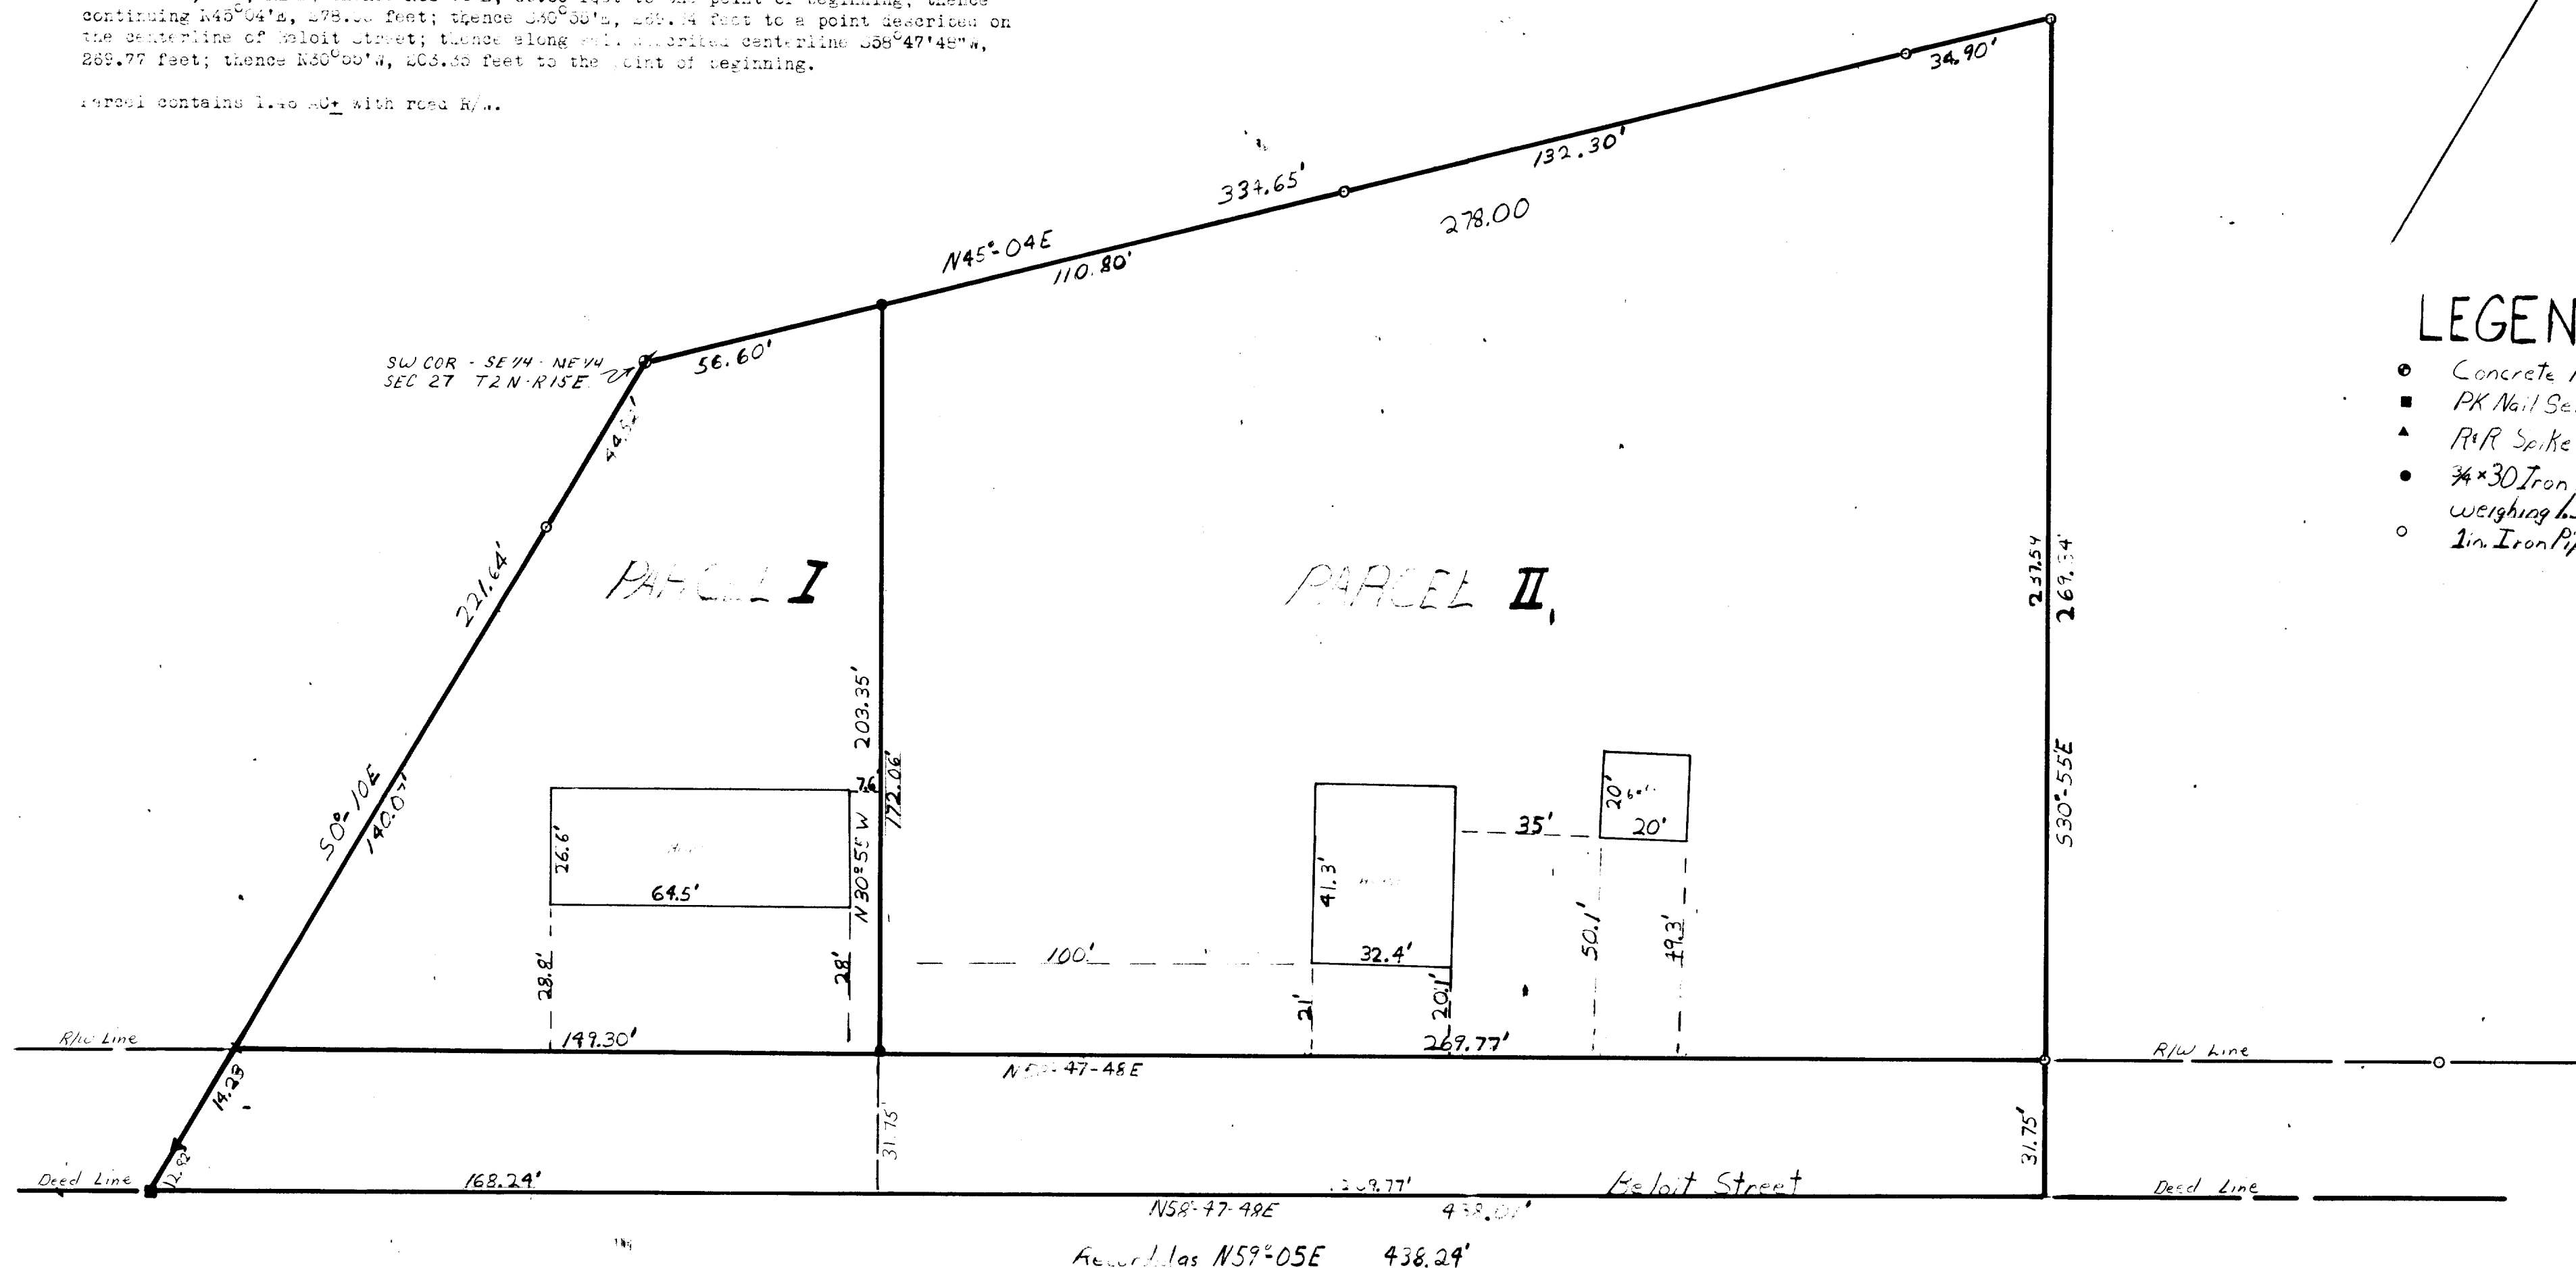

Surveyors Certificate

I, William L. Johnson, Registered Land Surveyor, do hereby certify that the plat shown herein is a true and accurate survey and a true representation thereof and the exterior boundary lines and all divisions of said property have been surveyed under my direction and to the best of my knowledge and belief.

Witness my hand and seal this 21st day of April, 1978.
William L. Johnson
Registered Land Surveyor

JENSEN & JOHNSON


ENGINEERS AND SURVEYORS

PO BOX 290, ELKHORN, WISCONSIN

414-723-3204

A Division of

Donohue & Associates, Inc.

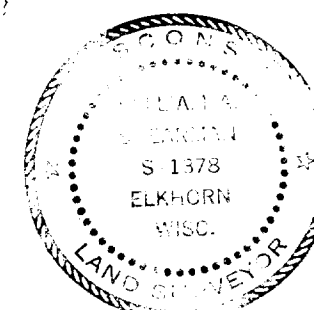

Date

3/11/78

Scale

1" = 30'

Drawn By

D. H.

Surveyed For
Morton Kaehlen
Dennis Karcher

Checked By

D. C.

Project No.

1658.285
1658.284