


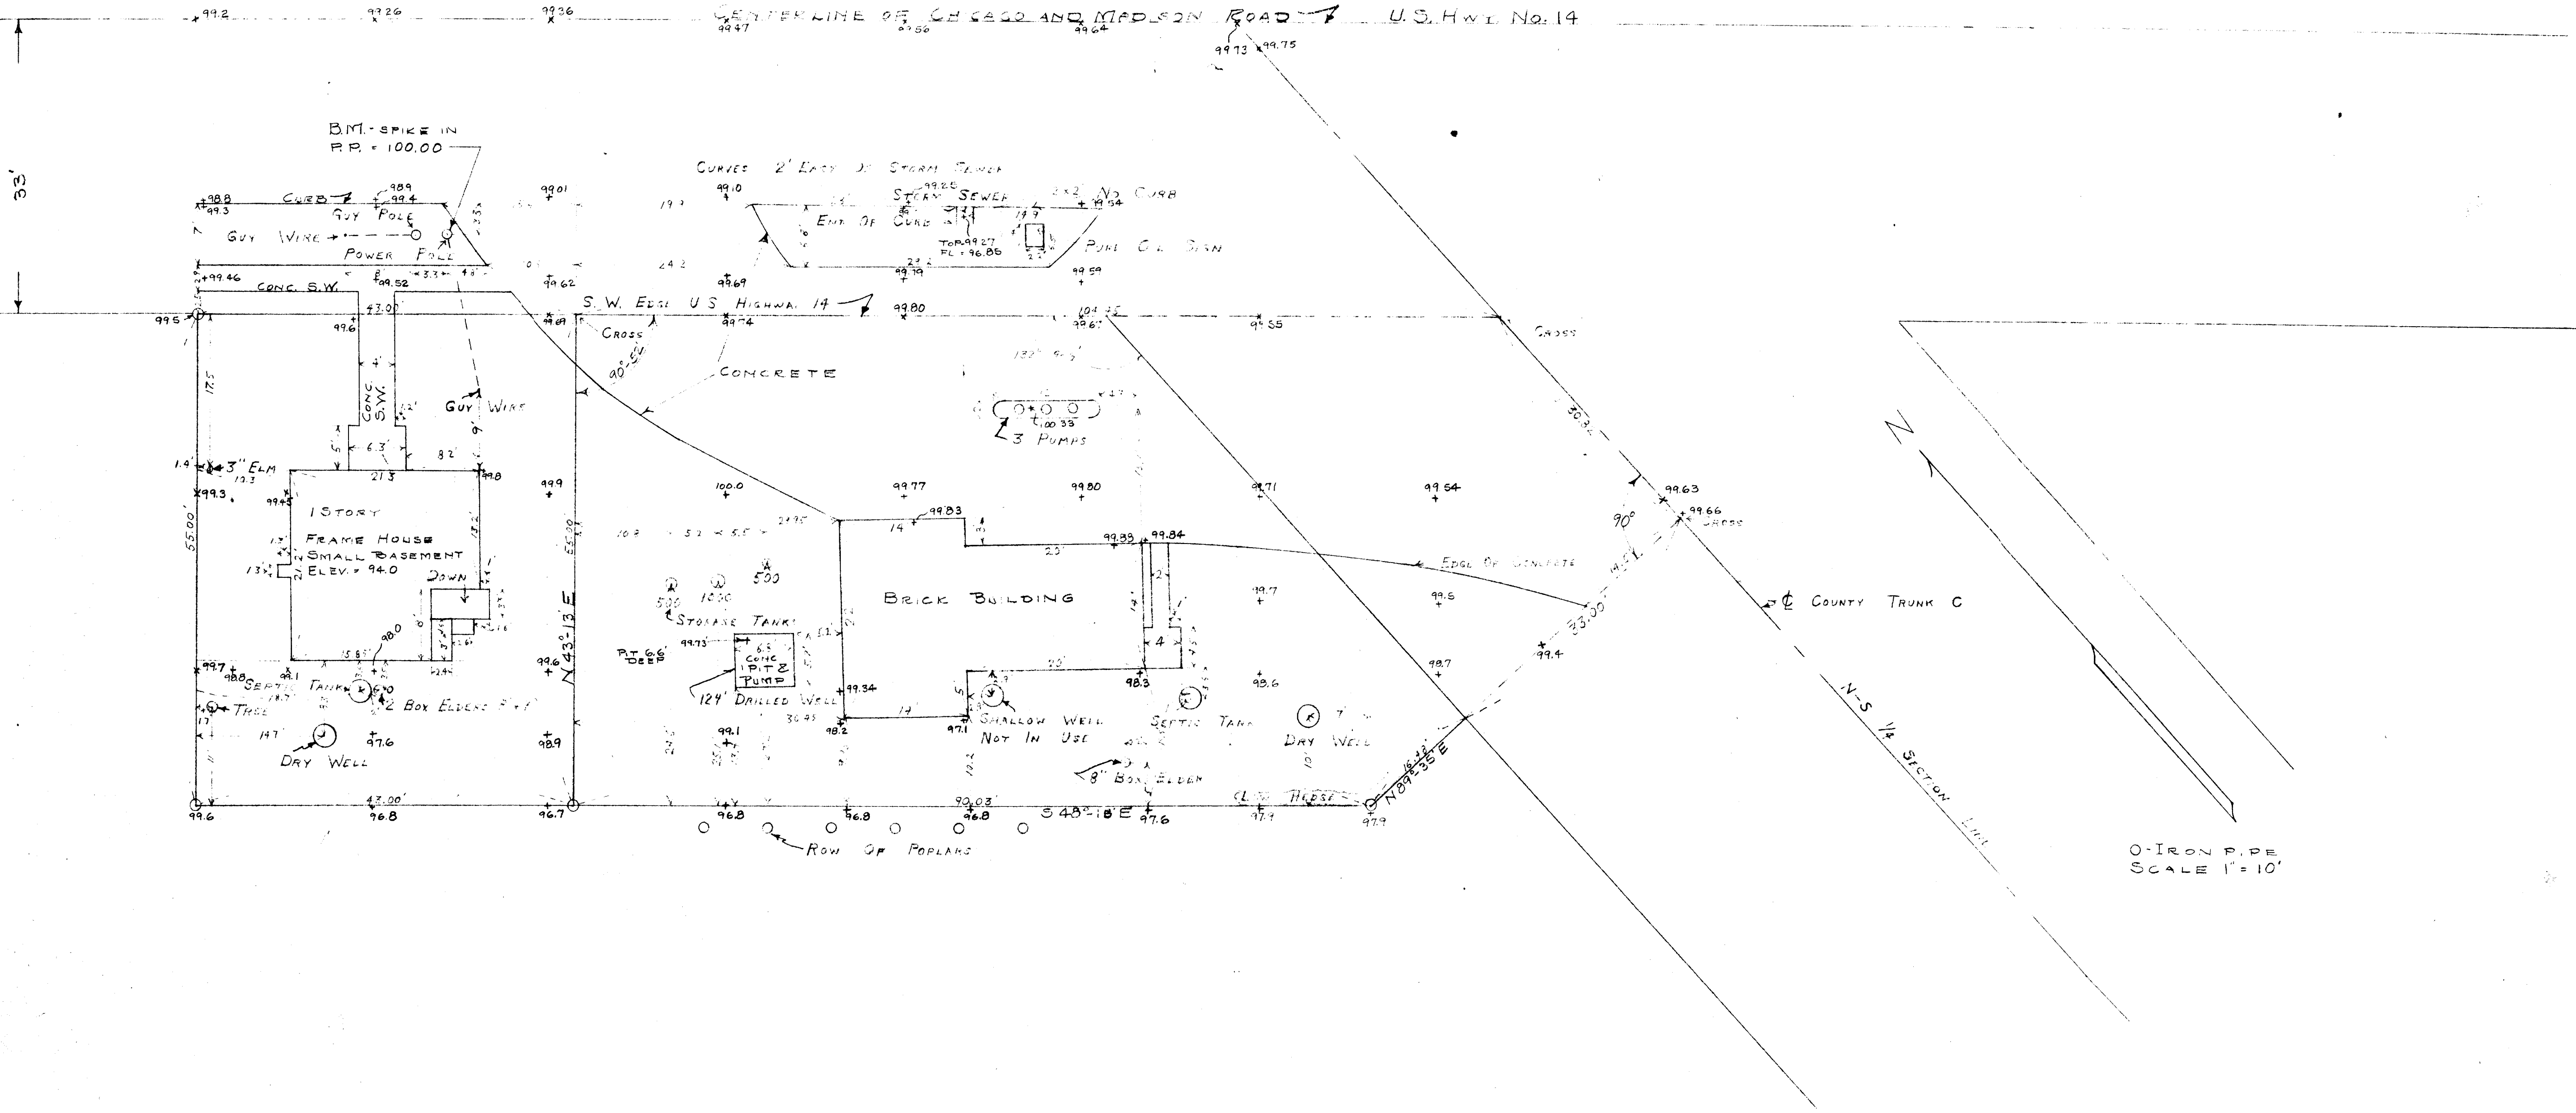

PLAT OF SURVEY OF PURE OIL COMPANY PROPERTY
 IN THE VILLAGE OF DARIEN, WALWORTH COUNTY,
 WISCONSIN.

JUNE 1951

[Signature]
 WALWORTH COUNTY SURVEYOR