


DUNHAM SURVEYING, S.C.
SURVEYING & SUBDIVISION
DELAVER, WISCONSIN 53115

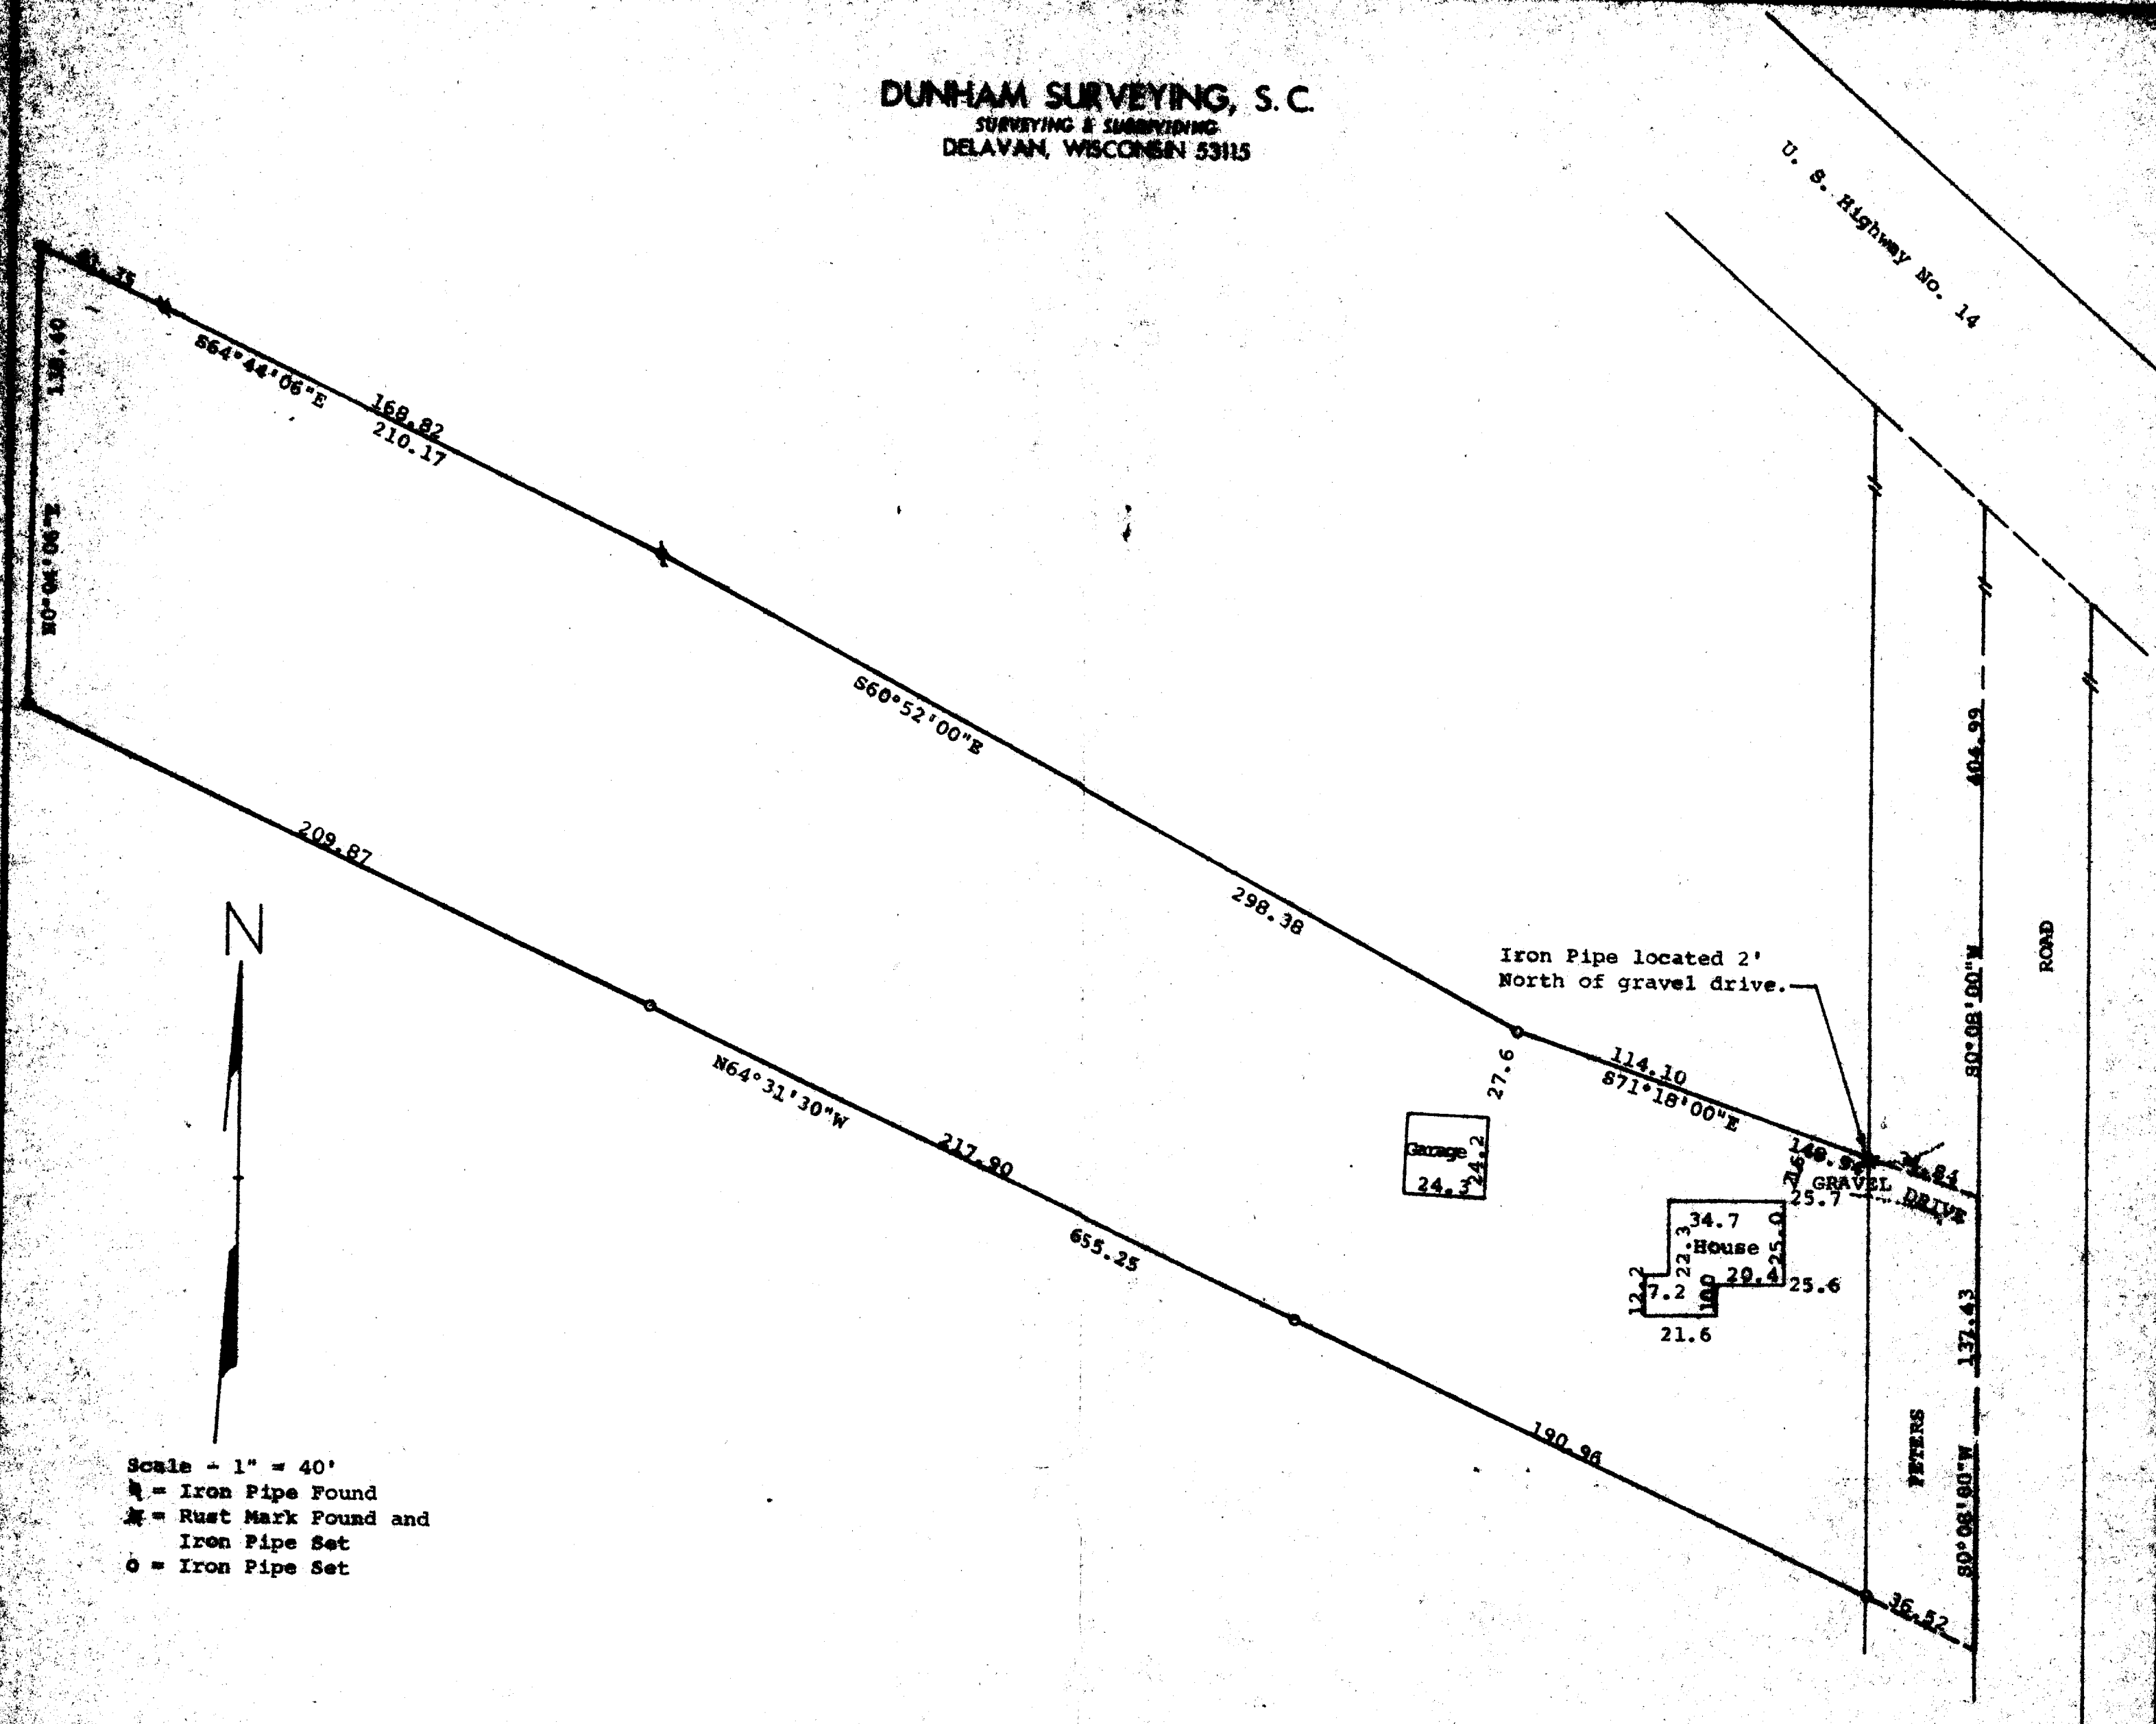

STATE OF WISCONSIN)
COUNTY OF WALWORTH) SS

I, George T. Dunham, Surveyor certify that I have surveyed the property described as follows:

A parcel of land located in the Southwest $\frac{1}{4}$ of Section 27, T2N, R15E, Village of Darien, Walworth County, Wisconsin, described as follows: Commencing at the intersection of the Southwesterly line of U. S. Highway No. 14 with the centerline of Peters Road, thence $80^{\circ}08'00''$ W along said centerline, 404.99 feet to the place of beginning; thence continue $80^{\circ}08'00''$ W along said centerline 137.43 feet; thence $864^{\circ}31'30''$ W, 655.25 feet; thence $80^{\circ}08'00''$ W, 137.43 feet; thence $864^{\circ}44'06''$ E, 210.17 feet; thence $860^{\circ}52'00''$ E, 298.38 feet; thence $871^{\circ}18'00''$ E, 148.94 feet to the place of beginning.

and that the above map is a true representation thereof and shows the size and location of the property, its exterior boundaries, the location of all visible structures and dimensions of all principal buildings thereon, boundary fences, apparent easements, roadways and visible encroachments, if any. This survey is made for the use of the present owners of the property, and also those who purchase, mortgage, or guarantee the title thereto within one (1) year from date hereof.

December 18, 1979

George T. Dunham
George T. Dunham, Surveyor

