


FARRIS, HANSEN & COOPER, INC.

ENGINEERING, SURVEYING AND LAND PLANNING
715 W. WALWORTH ST. - P.O. BOX 487 - ELKHORN, WI 53121

**BELLA VISTA DR.
("A" STREET)**

NOTE: The Easterly line of Lot 3 assumed to bear N 0°16'00" W as recorded.

0 10 20 30
SCALE IN FEET
1"=30'

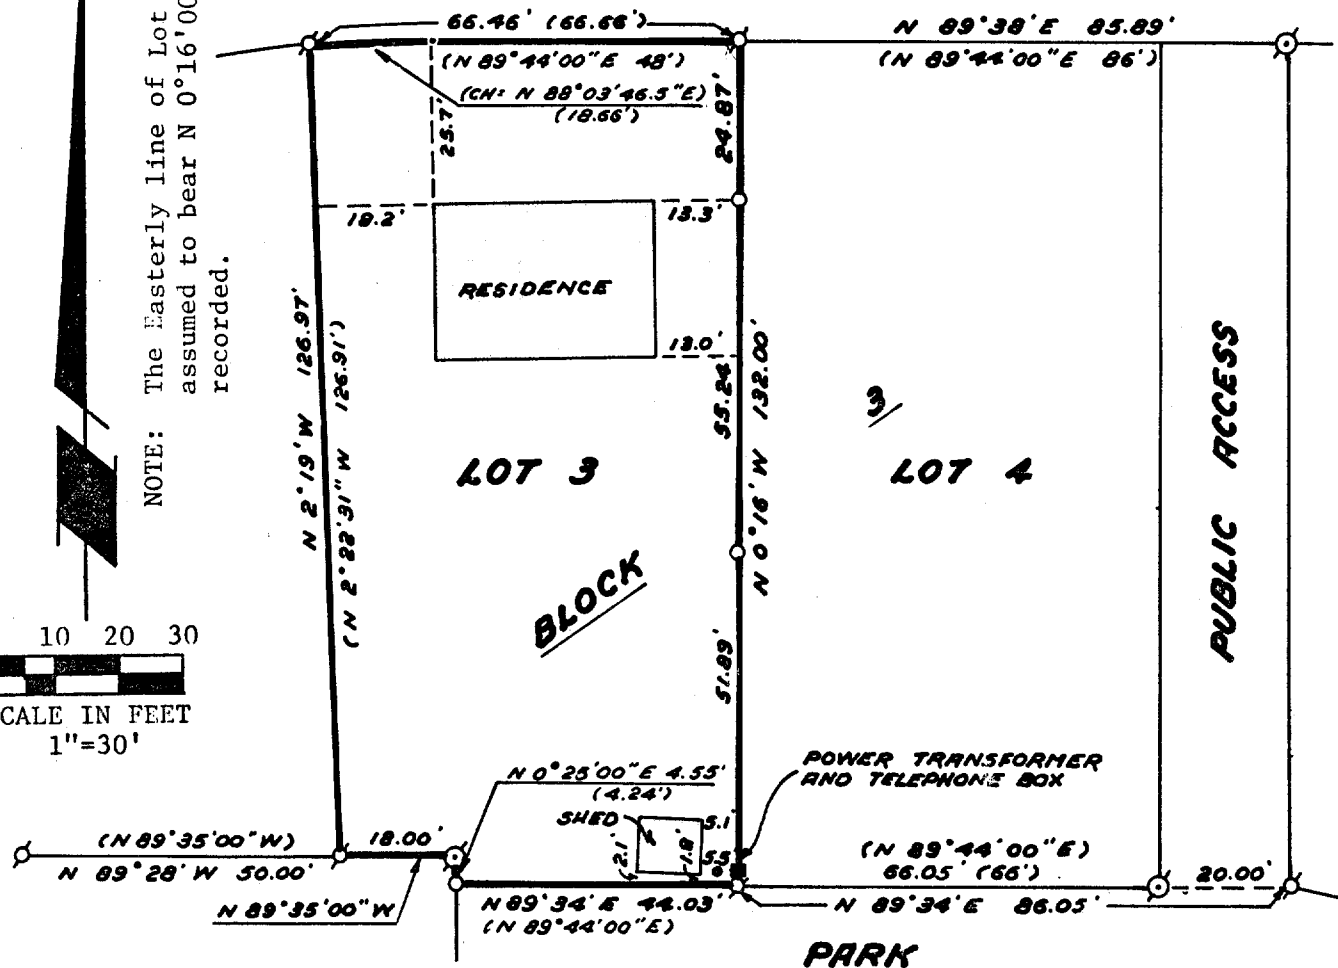

ORDERED BY:
PHYLIS WAGNER

PLAT OF SURVEY

LOT 3, BLOCK 3, BELLA VISTA SUBDIVISION, LOCATED IN THE NORTH-WEST 1/4 OF SECTION 27, TOWN 2 NORTH, RANGE 15 EAST. VILLAGE OF DARIEN, WALWORTH COUNTY, WISCONSIN.

LEGEND

- ⊙- 2" Dia. Iron Pipe Found
- ⊙- 1" Dia. Iron Pipe Found
- 1" Dia. X 24" Iron Pipe Set
- ()- Record Dimension



I HEREBY CERTIFY that I have surveyed the property described hereon and that this Plat of Survey is a true and accurate representation of the lot lines, and the buildings thereon, to the best of my professional knowledge and belief.

Daniel D. Cooper
Daniel D. Cooper, RLS No. 1464

Dated this 24 day of July, 1980.

PROJECT NO. 1727