


DUNHAM SURVEYING, S.C.
SURVEYING & SUBDIVISION
DELAVER, WISCONSIN 53115

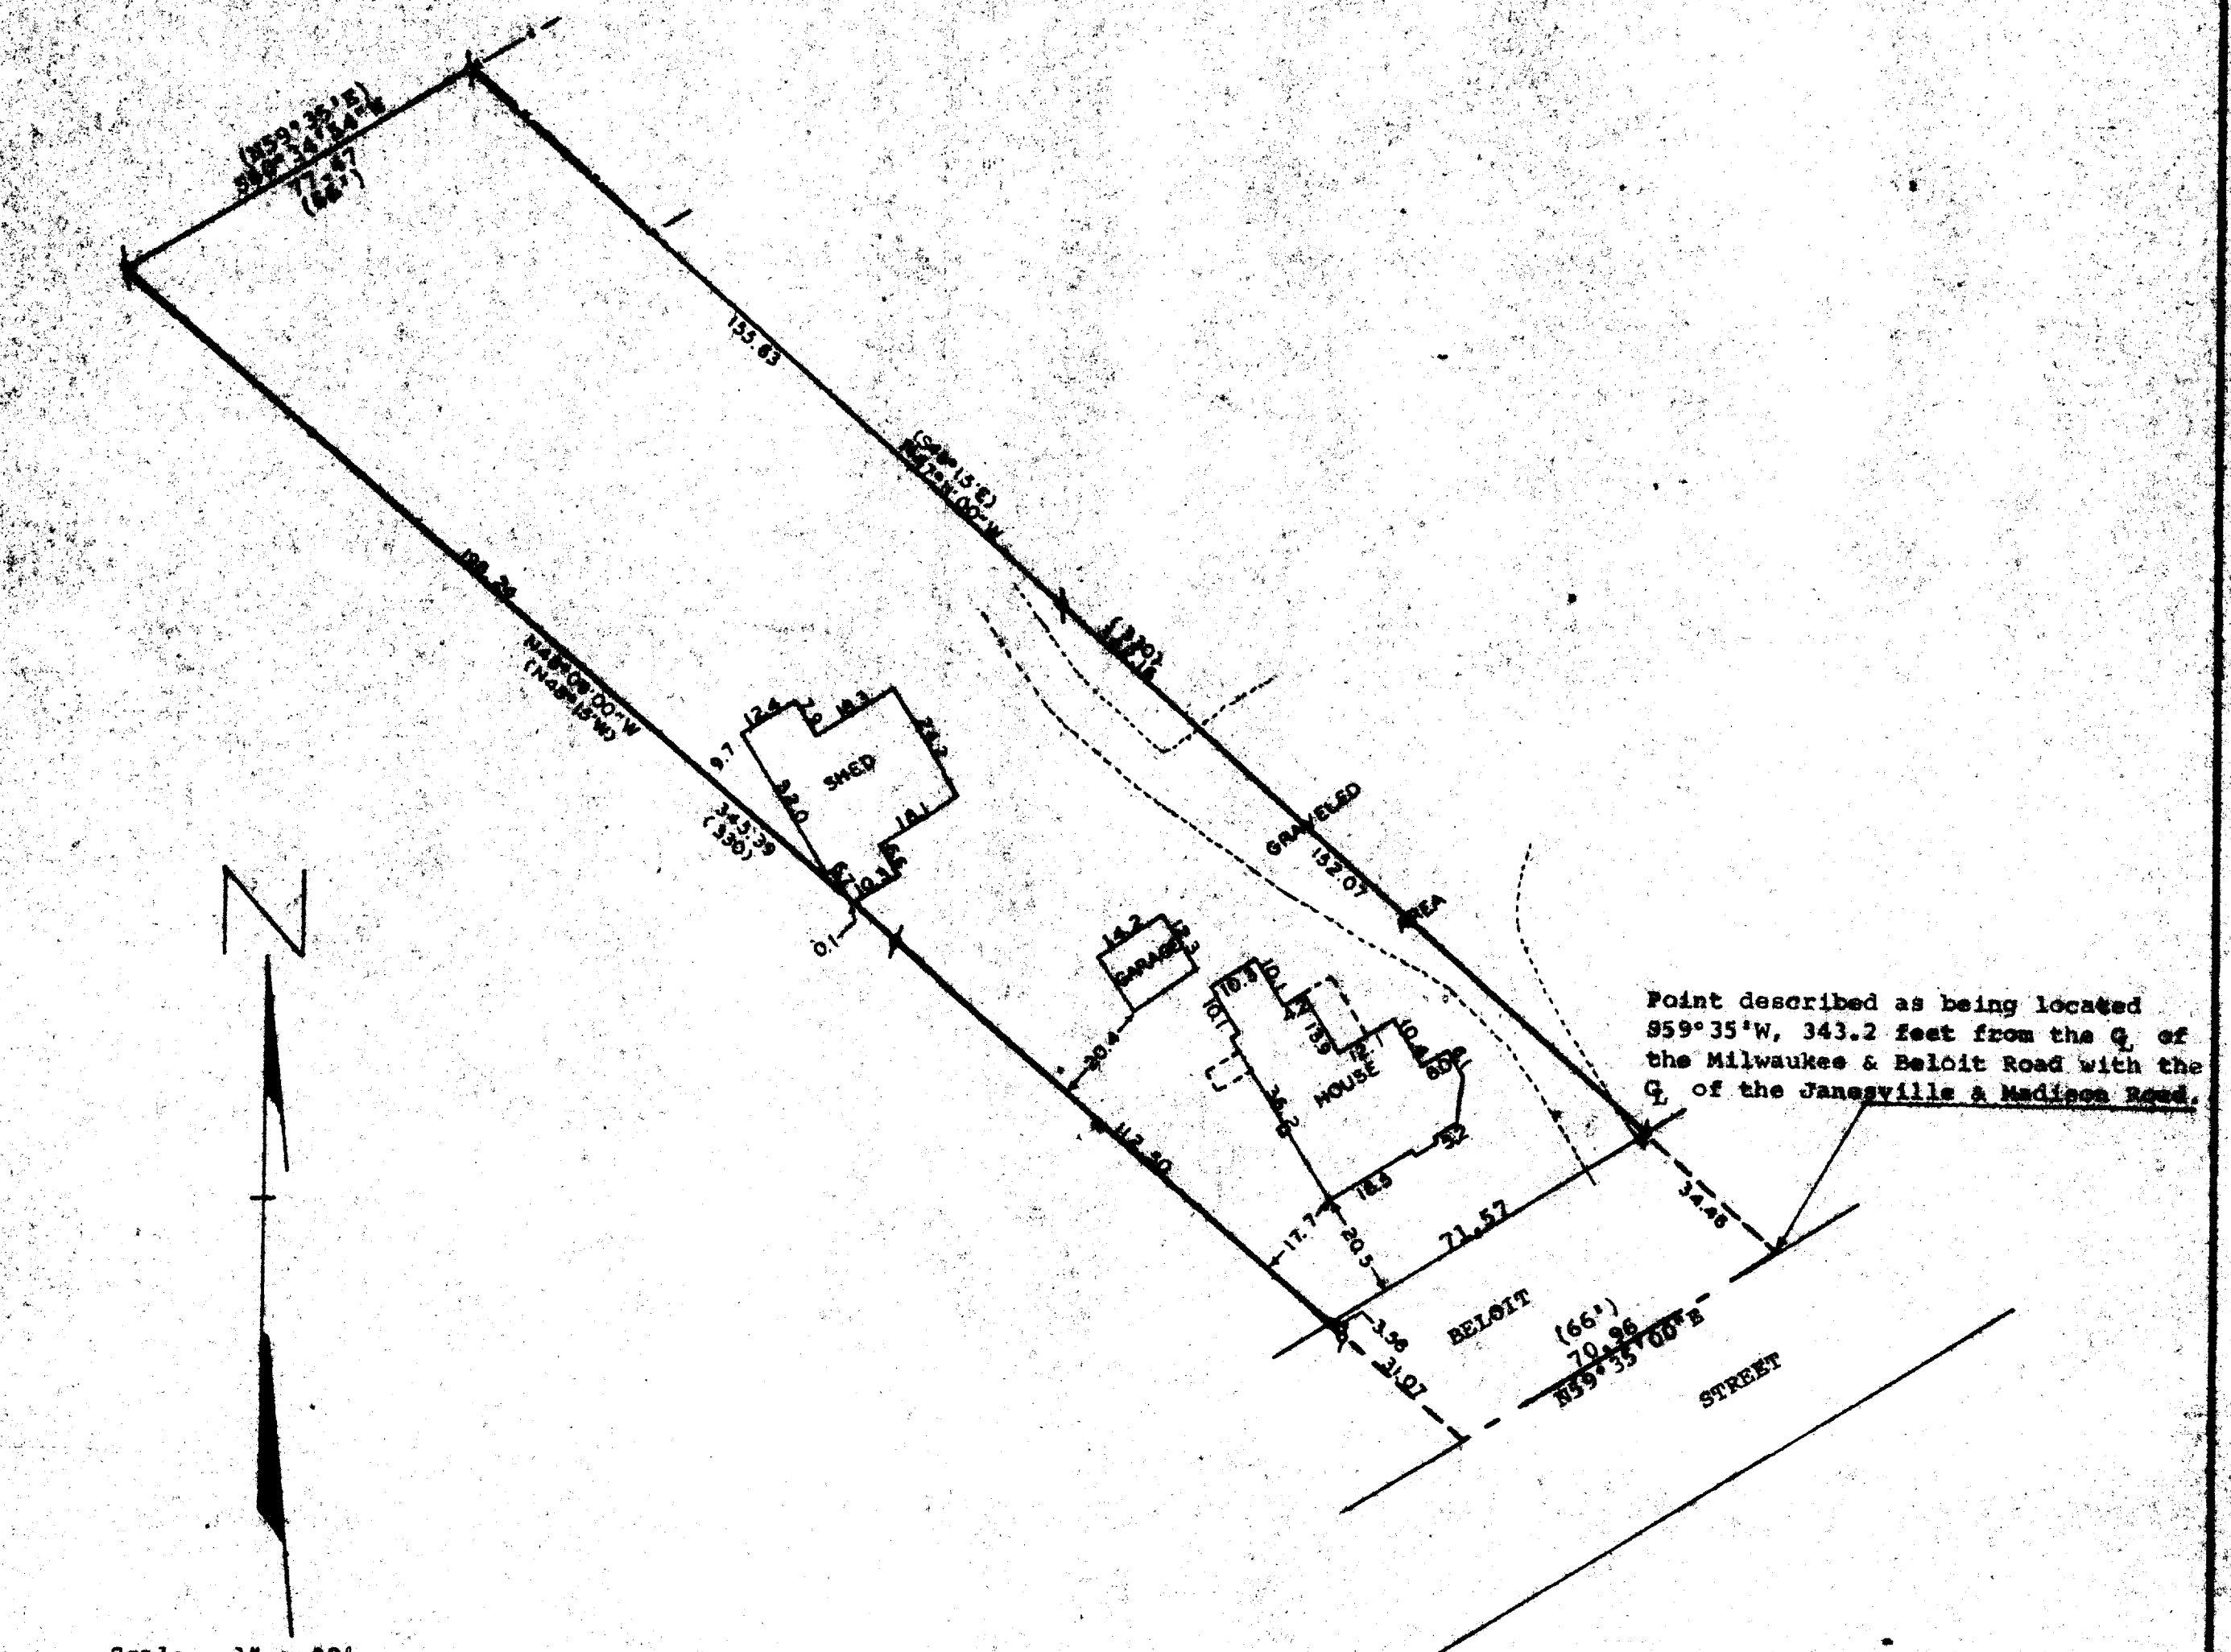

Scale - 1" = 30'
 / = 1" Dia. Iron Pipe Found
 / = 3/4" Dia. Iron Pipe Found
 o = 1/4" Dia. Iron Pipe Set
 --- = Fence Line
 (xxx) = Recorded Data

Bearings are referenced to the center line of Beloit Street.
 Bearing of N59°35'E is taken from records.

Ordered by: Ken Danielson
 Realtor
 Darien, Wisconsin 53114

STATE OF WISCONSIN)
 COUNTY OF WALWORTH)


I, George T. Dunham, Surveyor, certify that I have surveyed the
 property described as follows.

A parcel of land located in the East 1/4 of the Southwest 1/4 of Section
 27, T 2 N, R 13 E, Village of Darien, Walworth County, Wisconsin,
 described as follows: Beginning at a point located S59°35'W,
 343.20 feet from the intersection of the centerline of U.S. Highway
 No. 14 and the centerline of Beloit Street in said Village of Darien;
 thence continue S59°35'00"W along the centerline of said Beloit
 Street 70.96 feet (described as 66'); thence N48°08'00"W, 345.33 feet
 (described as N48°15'W 330'); thence N60°34'54"E 77.47 feet, (described
 as N59°35'E 66'); thence S47°11'00"E 342.16 feet, (described as
 S48°15'E 330') to the place of beginning.

and that the above map is a true representation thereof and shows the size and
 location of the property, its exterior boundaries, the location of all visible
 structures and dimensions of all principal buildings thereon, boundary fences,
 apparent easements, roadways and visible encroachments, if any, and that I have
 surveyed the property herein described according to the official records, to the
 best of my knowledge and belief.

March 14, 1983

George T. Dunham
 George T. Dunham, Surveyor

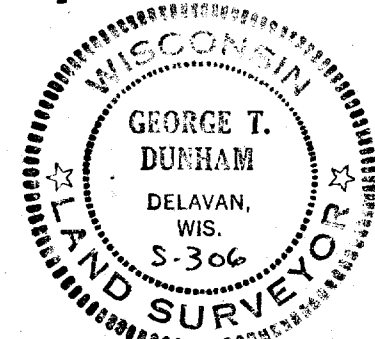

Q-VD-54