


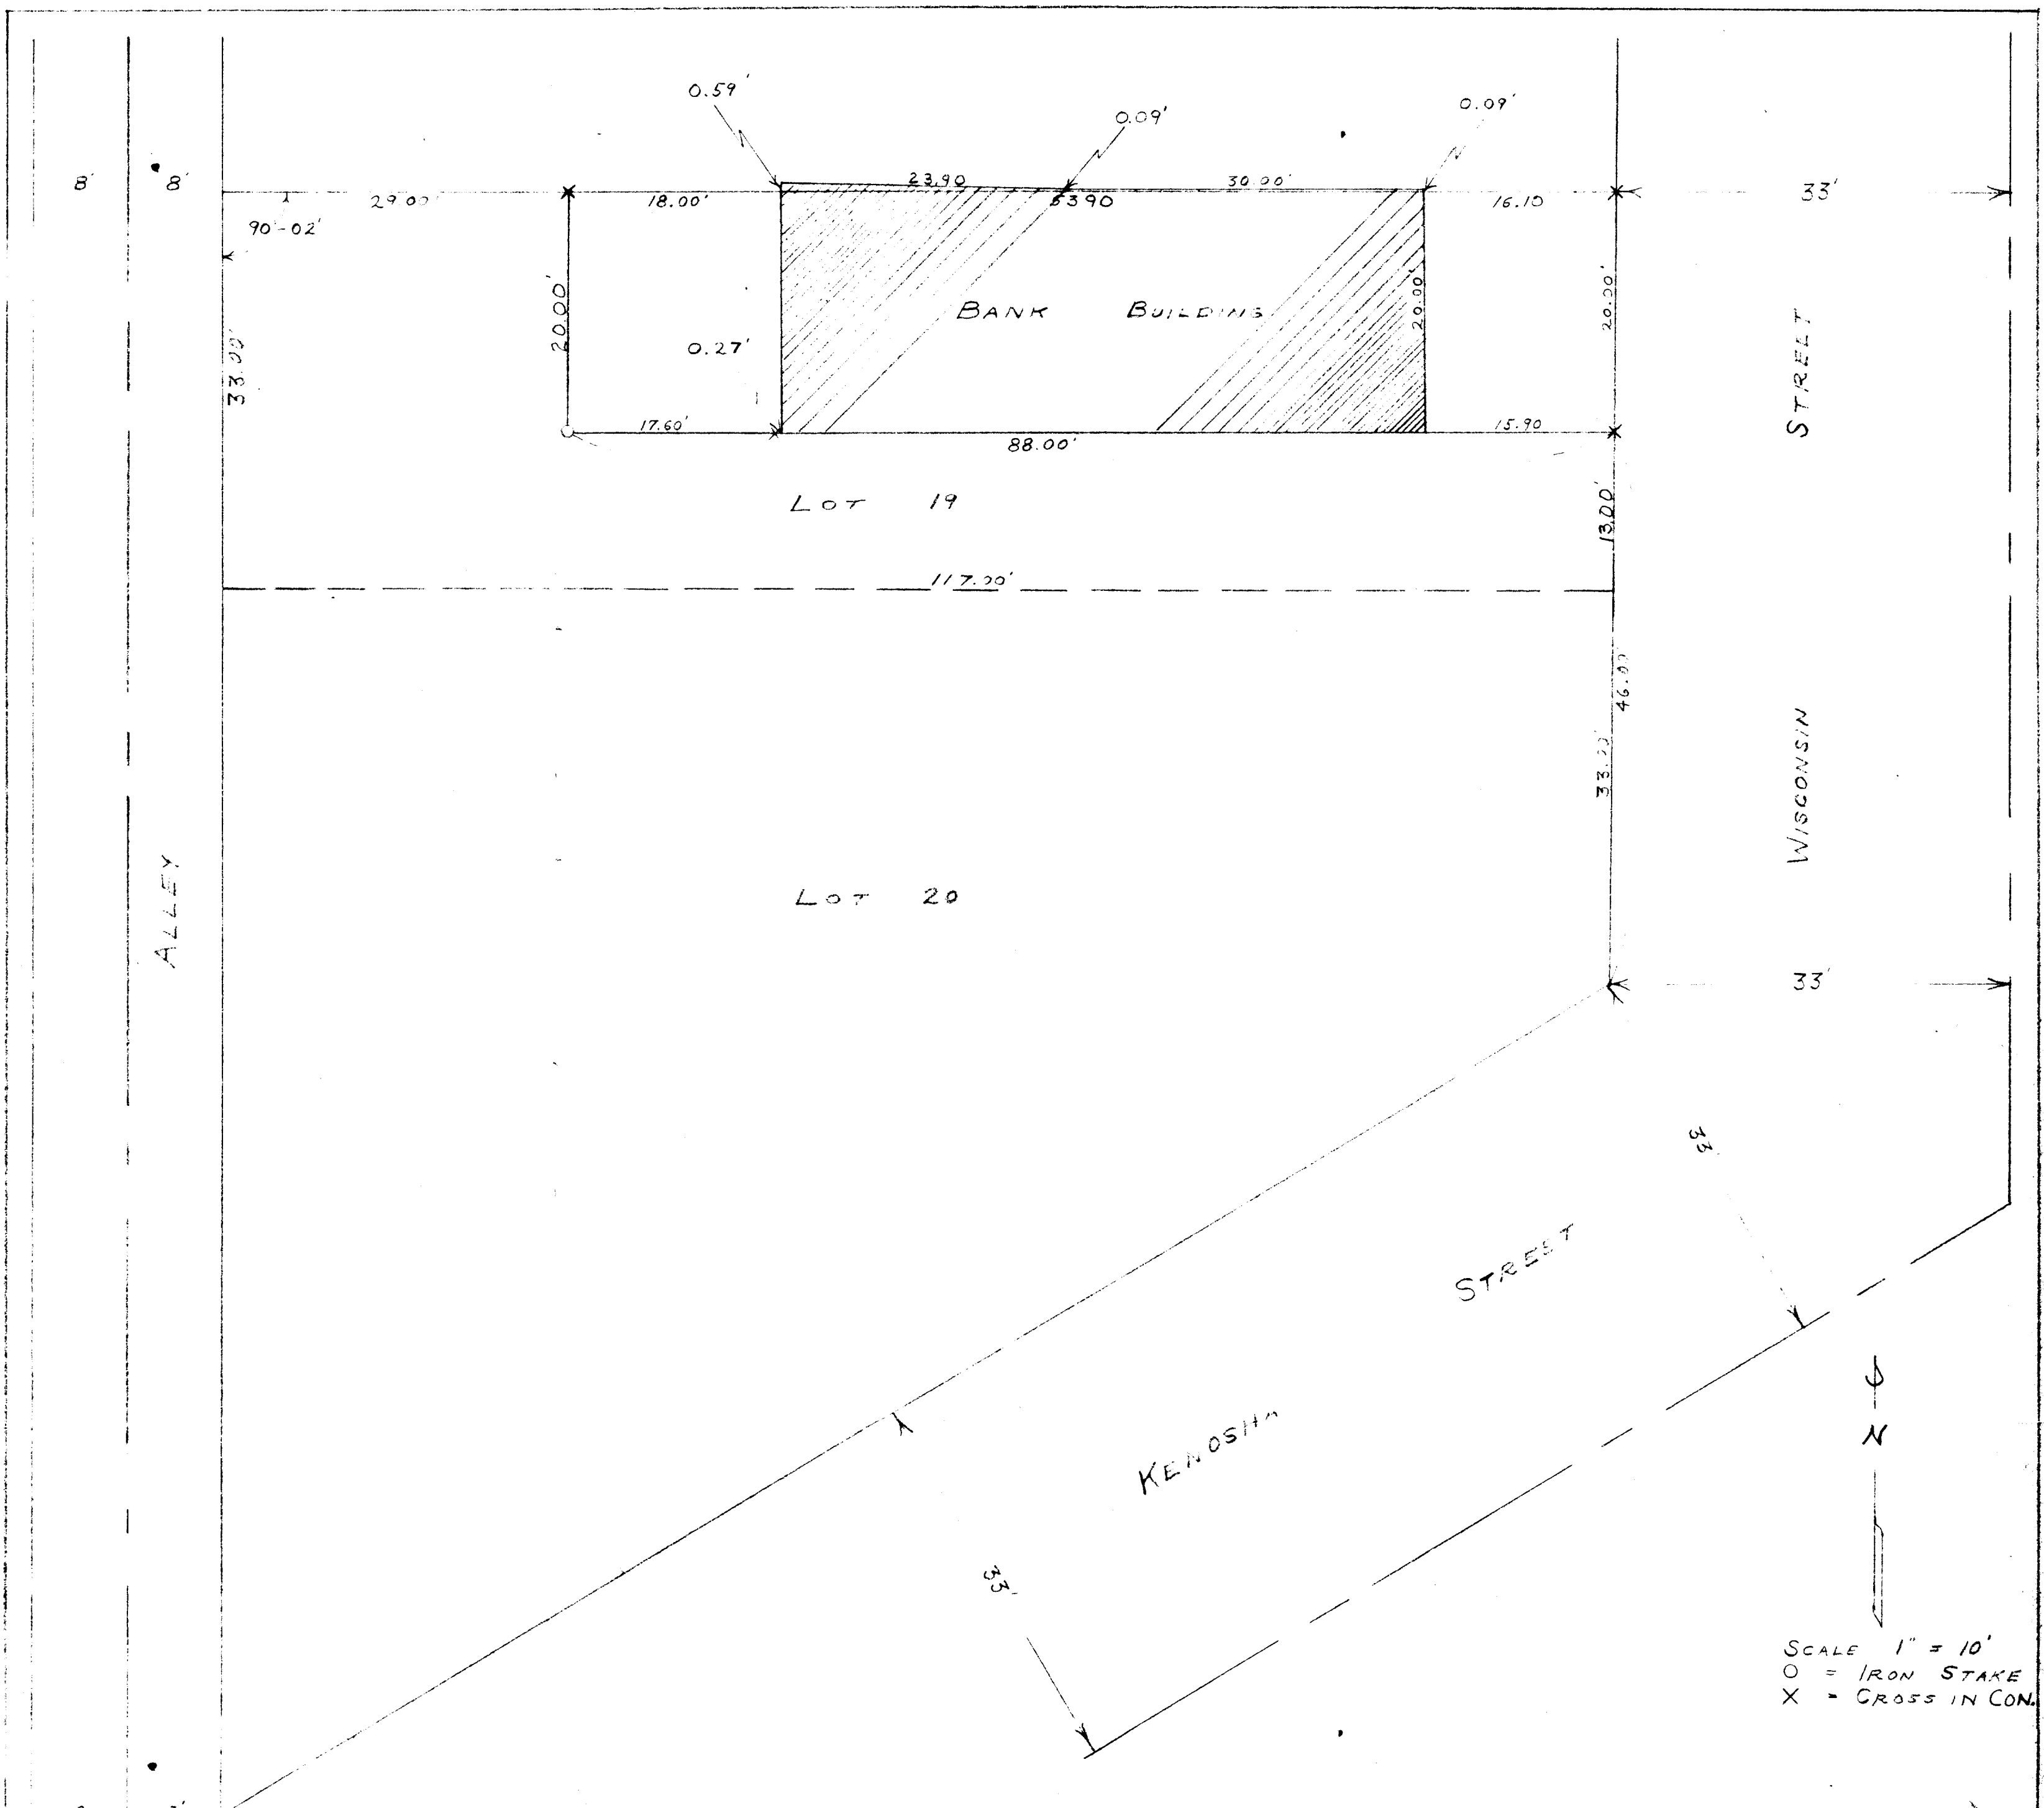

PLAT OF A SURVEY OF THE FARMER'S
 STATE BANK PROPERTY LOCATED ON LOT
 19 BLOCK 22 IN FREY'S ADDITION TO
 THE VILLAGE OF DARIN WALWORTH COUNTY,
 WISCONSIN.
 MARCH 31, 1952

Lloyd L. Jensen
 COUNTY SURVEYOR

SCALE 1" = 10'
 O = IRON STAKE
 X = CROSS IN CON.