


DUNHAM SURVEYING, S.C.
SURVEYING & SUBDIVIDING
DELAVER, WISCONSIN 53115

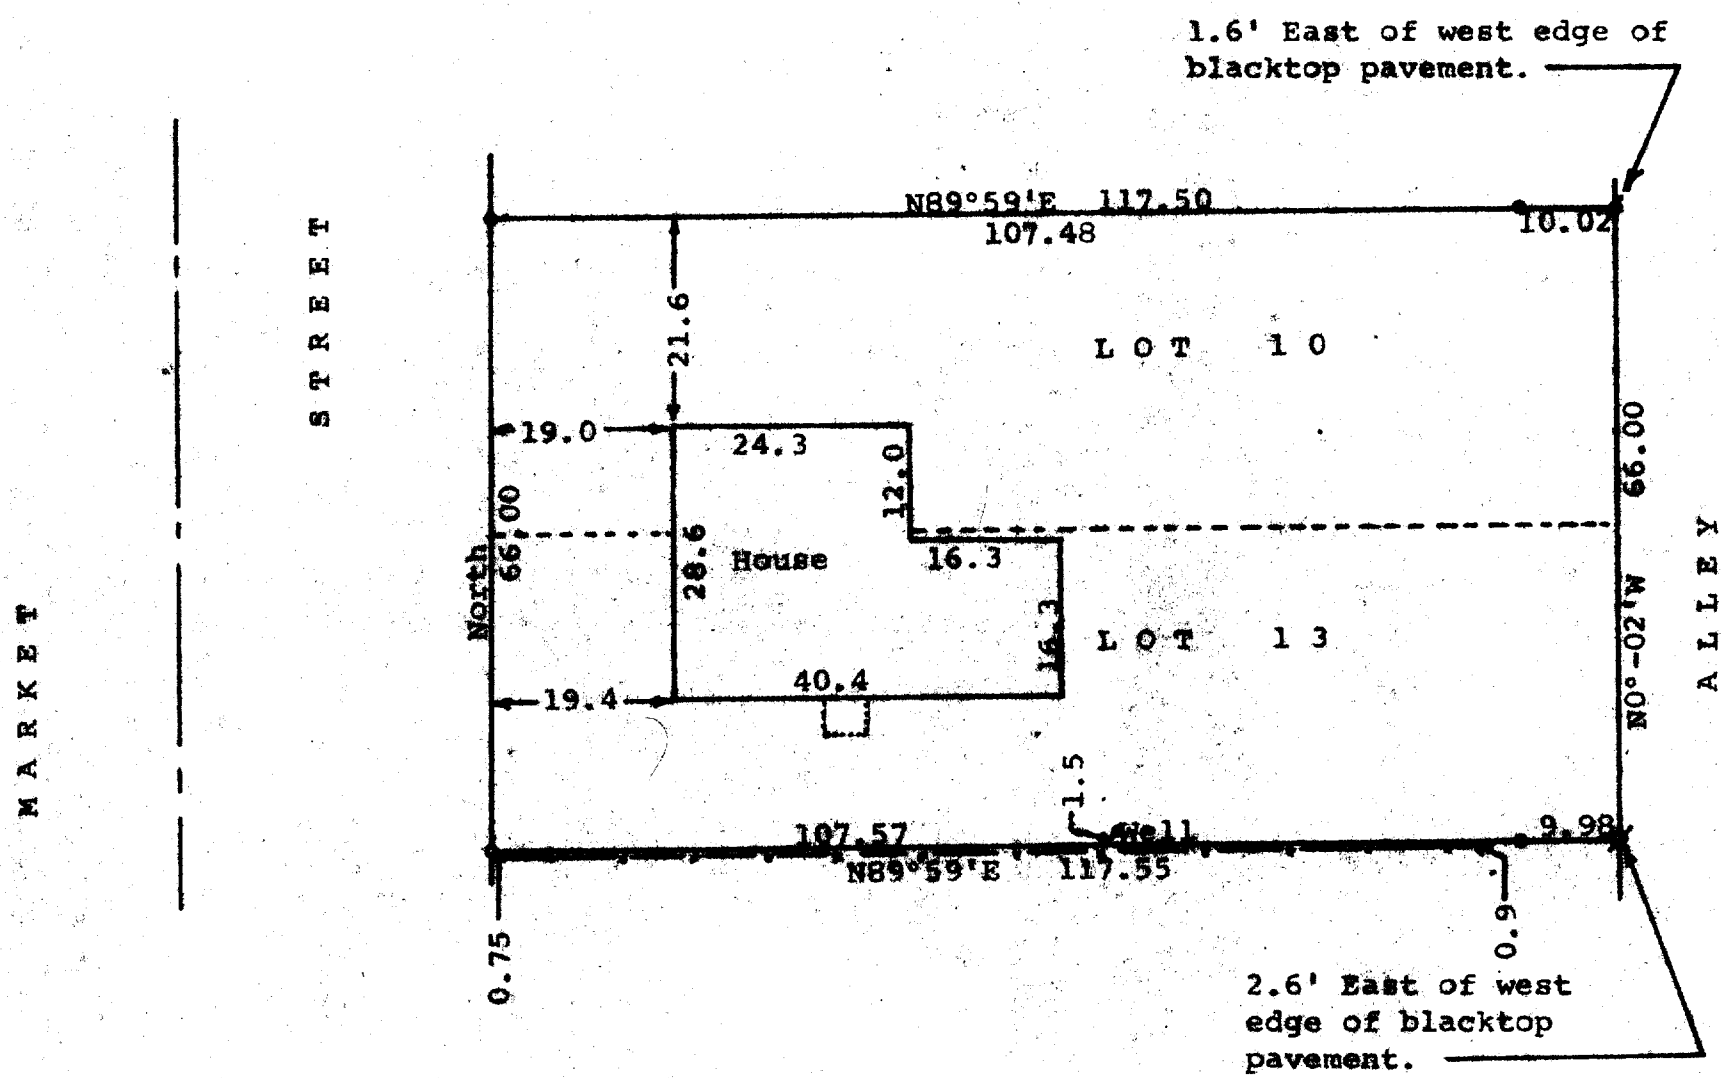

Scale - 1" = 20'
● = 1 1/4" Iron Pipe Found
● = 1" Iron Pipe Found
● = 1/2" Iron Pipe Found
--- = Fence Line
Bearings referenced to the east line of
Market Street with the assumed bearing
of North
Survey ordered by: Carmin Realtors
537 Laurel Heights
Delavan, WI 53115

STATE OF WISCONSIN)
COUNTY OF WALWORTH)

I, George T. Dunham, Surveyor, certify that I have surveyed
the property described as follows:

Lot 10 and Lot 13 in Block 22 of Frey's Addition to the
Village of Daris, Walworth County, Wisconsin,
and that the above map is a true representation thereof and shows
the size and location of the property, its exterior boundaries,
the location of all visible structures and dimensions of all principal
buildings thereon, boundary fences, apparent easements, roadways and
visible encroachments, if any, and that I have surveyed the property
hereon described according to the official records to the best of my
knowledge and belief.
February 20, 1986

George T. Dunham
George T. Dunham, Surveyor

