


**SURVEYING & SUBDIVIDING
DEHAVAN, WISCONSIN 53115**

Scale - 1" = 20'

• = 3/4" Iron Pipe Found

Survey ordered by:
Robert Boniface
1st Bank Southeast of
Lake Geneva WA
6 North Wisconsin
Darien, WI 53114

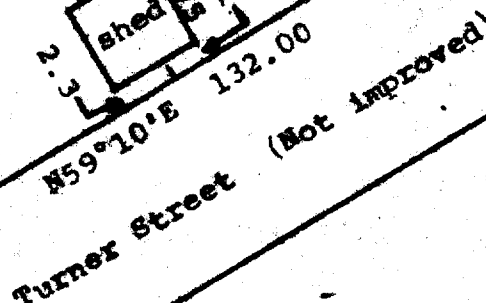

I, George T. Dunham, Surveyor, certify that I have surveyed the property described as follows:

lots 31 to 42, both inclusive, of the West Side Addition to the Village of Paris, Winnebago County, Wisconsin, and that the map shown hereon is a correct representation thereof and shows the size and location of the property, its exterior boundaries, the location of all visible structures and dimensions of all principal buildings thereon, boundary fences, apparent easements, roadways and visible encroachments, if any, and that I have surveyed the property hereon described, according to the official records, to the best of my knowledge and belief.

August 5, 1987

