


ABELL
SURVEYING & MAPPING
DELAVER, WISCONSIN 53115
414-728-6737

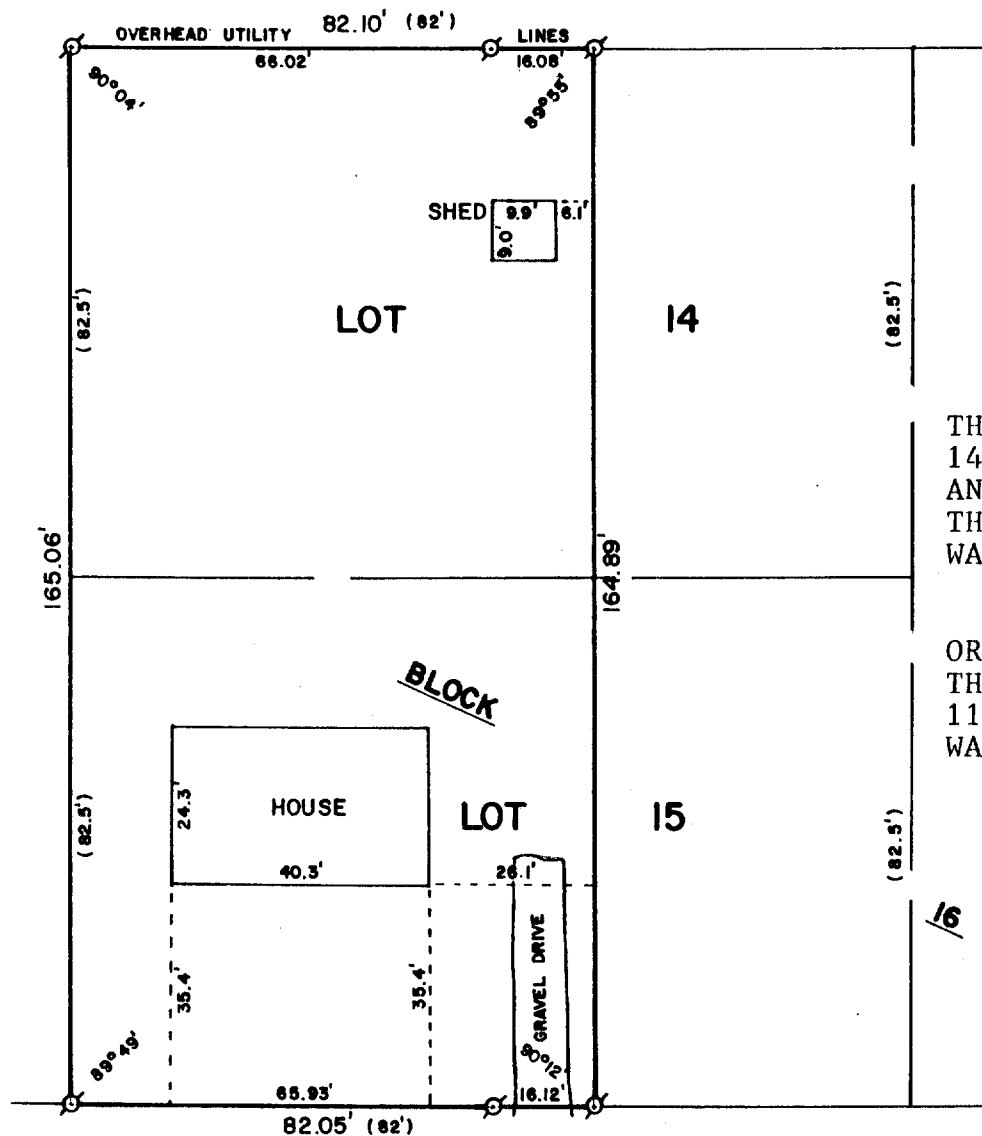


PLAT OF SURVEY OF

THE WEST 82 FEET OF LOTS
14 AND 15, BLOCK 16, STONE
AND TOPPING ADDITION TO
THE VILLAGE OF DARIEN,
WALWORTH COUNTY, WISCONSIN

ORDERED BY:
THE RAULAND AGENCY
118 KENOSHA ST.
WALWORTH, WI. 53184

JEFFERSON STREET

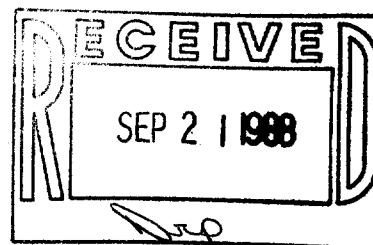

I HEREBY CERTIFY THAT I HAVE SURVEYED THE
ABOVE DESCRIBED PROPERTY AND THAT THE ABOVE
MAP IS A TRUE REPRESENTATION THEREOF AND
SHOWS THE SIZE AND LOCATION OF THE PROPERTY,
ITS EXTERIOR BOUNDARIES, THE LOCATION OF ALL
VISIBLE STRUCTURES AND DIMENSIONS OF ALL
PRINCIPAL BUILDINGS THEREON, BOUNDARY FENCES,
APPARENT EASEMENTS, ROADWAYS AND VISIBLE
ENCROACHMENTS, IF ANY, TO THE BEST OF MY
KNOWLEDGE AND BELIEF.

THIS SURVEY IS MADE FOR THE USE OF THE PRESENT
OWNERS OF THE PROPERTY, AND ALSO THOSE WHO
PURCHASE, MORTGAGE, OR GUARANTEE THE TITLE
THERETO WITHIN ONE (1) YEAR FROM DATE HEREOF.

David F. Abell

DAVID F. ABELL
WISCONSIN REGISTERED LAND SURVEYOR, S-1596

August 6, 1988

DATE JOB NUMBER -88174

NOTE: THIS IS NOT A CERTIFIED COPY UNLESS SEALED. 1-211

SCALE - 1"=30'



LEGEND

⊙ - IRON PIPE FOUND
() - RECORDED AS