



**ABELL
SURVEYING & MAPPING
DELAVAN, WISCONSIN 53115
414-728-6757**

PLAT OF SURVEY OF

LOTS 13 AND 14, BLOCK 10 OF THE ORIGINAL
PLAT, VILLAGE OF DARIEN, WALWORTH COUNTY,
WISCONSIN.

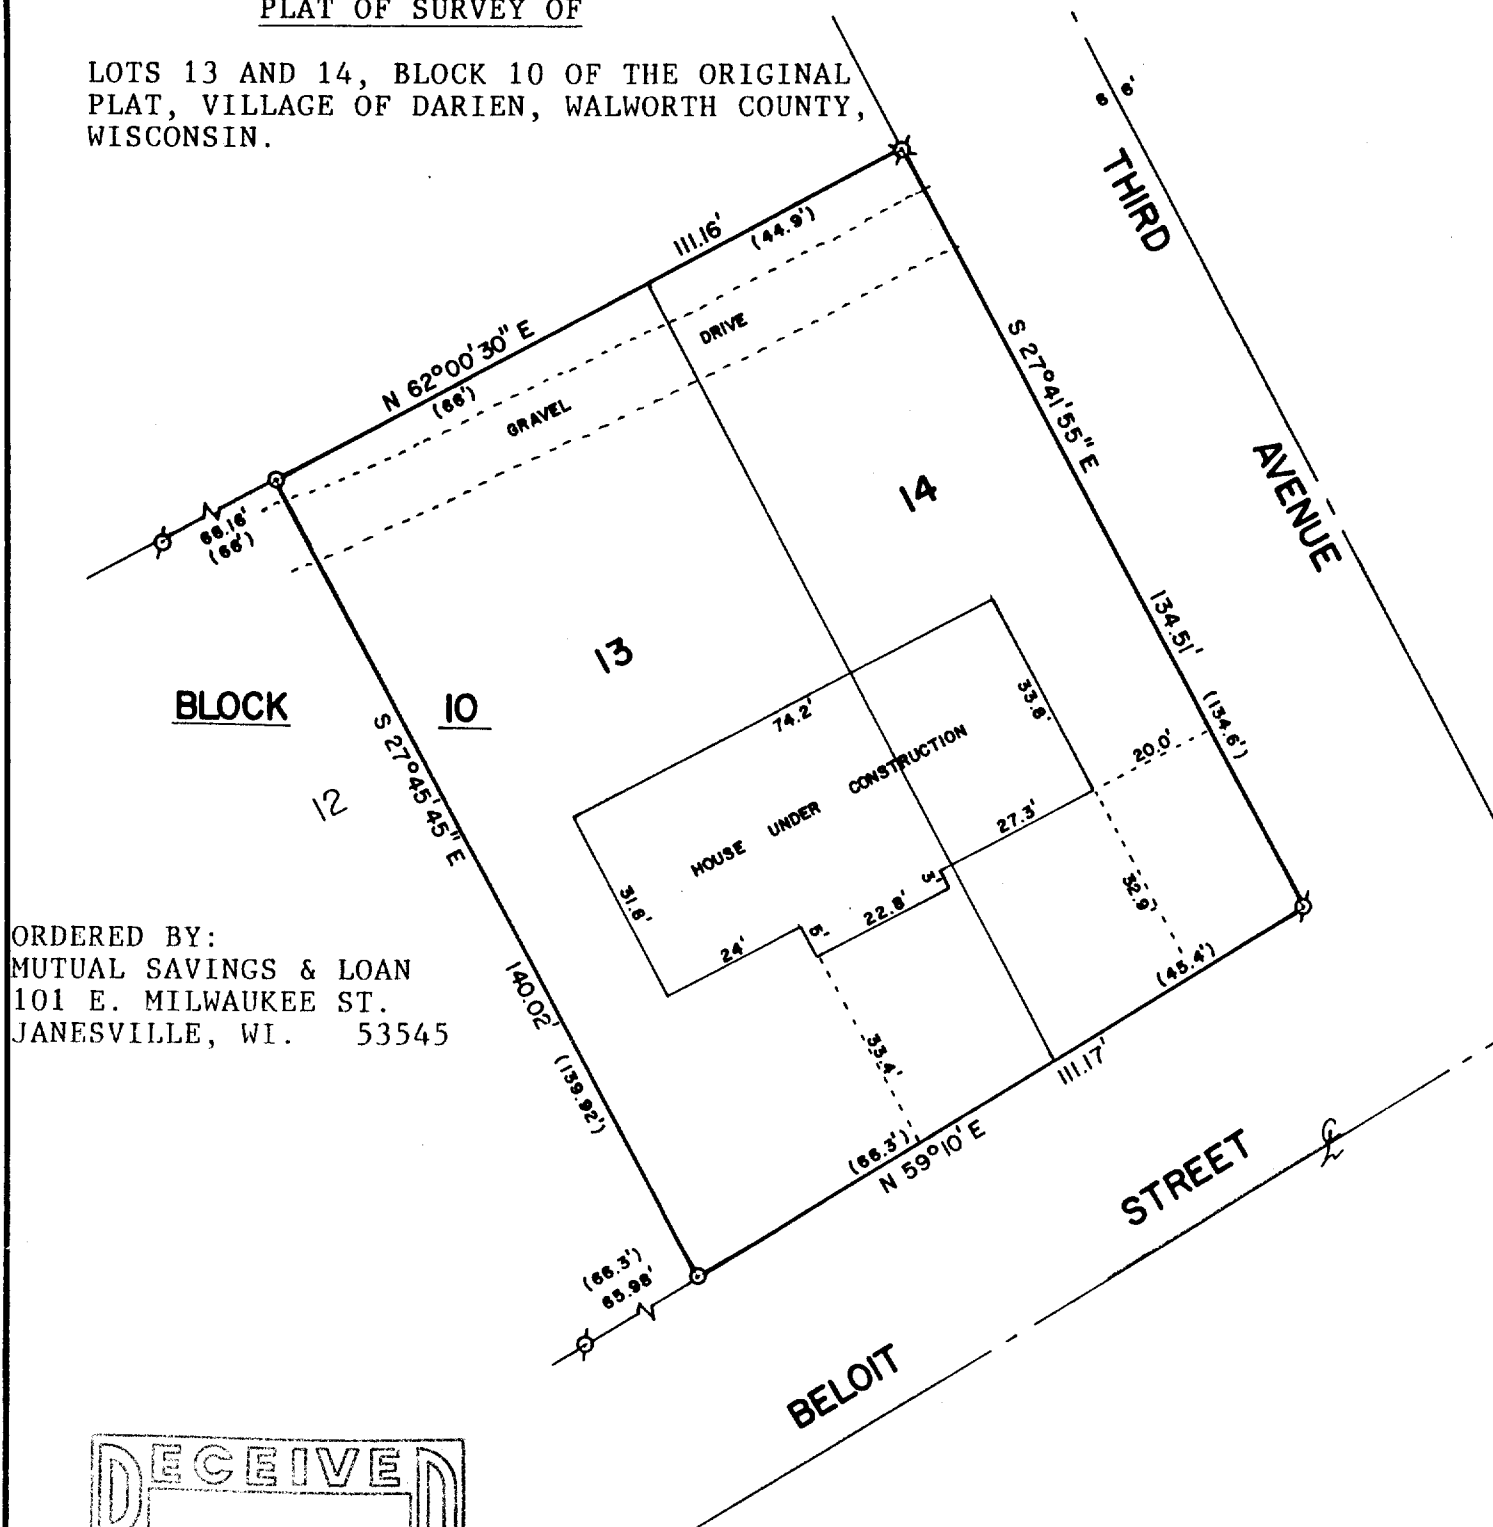

ORDERED BY:
MUTUAL SAVINGS & LOAN
101 E. MILWAUKEE ST.
JANESVILLE, WI. 53545

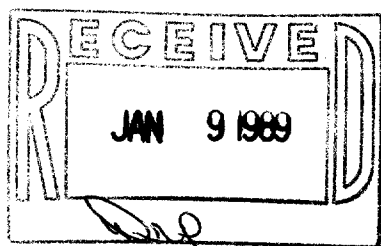

SCALE - 1"=30'

LEGEND

- ⊗ - IRON PIPE FOUND
- - IRON PIPE SET
- () - RECORDED AS
- ⊗ - IRON PIPE FOUND BENT,
IT WAS STRAIGHTEN AND
NEW IRON PIPE SET.

I HEREBY CERTIFY THAT I HAVE SURVEYED THE
ABOVE DESCRIBED PROPERTY AND THAT THE ABOVE
MAP IS A TRUE REPRESENTATION THEREOF AND
SHOWS THE SIZE AND LOCATION OF THE PROPERTY,
ITS EXTERIOR BOUNDARIES, THE LOCATION OF ALL
VISIBLE STRUCTURES AND DIMENSIONS OF ALL
PRINCIPAL BUILDINGS THEREON, BOUNDARY FENCES,
APPARENT EASEMENTS, ROADWAYS AND VISIBLE
ENCROACHMENTS, IF ANY, TO THE BEST OF MY
KNOWLEDGE AND BELIEF.

THIS SURVEY IS MADE FOR THE USE OF THE PRESENT
OWNERS OF THE PROPERTY, AND ALSO THOSE WHO
PURCHASE, MORTGAGE, OR GUARANTEE THE TITLE
THERETO WITHIN ONE (1) YEAR FROM DATE HEREOF.

David F. Abell
DAVID F. ABELL
WISCONSIN REGISTERED LAND SURVEYOR, S-1596

November 2, 1988
DATE JOB NUMBER - 88251

NOTE: THIS IS NOT A CERTIFIED COPY UNLESS SEALED.