


Reduced

WASHINGTON STREET

N *Deperre* 

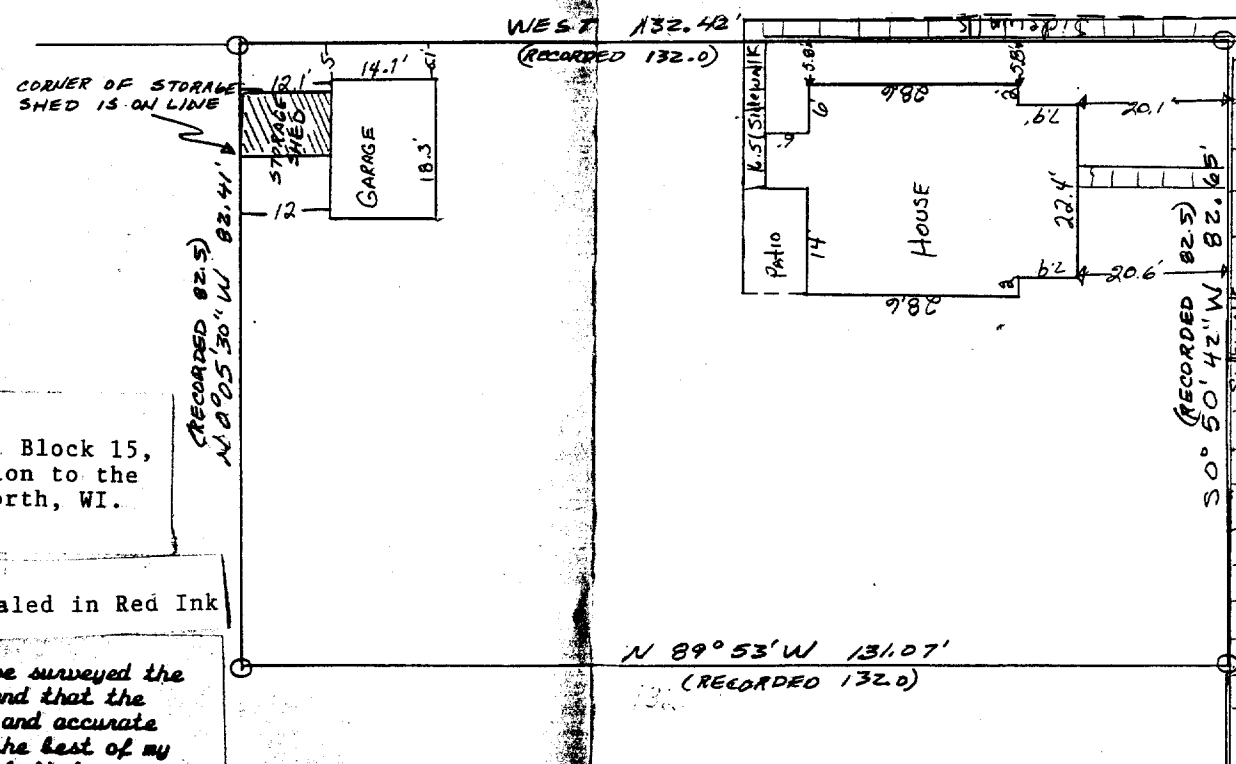

Original Copy Only if Sealed in Red Ink

Dated this 9th day of AUGUST, 1990

SURVEY ORDERED BY: Kenneth Wilson.

TAX KEY # QS ET 00009

1-227

