


DUNHAM SURVEYING, S.C.
SURVEYING & SUBDIVIDING
DELAVAL, WISCONSIN 53115

N

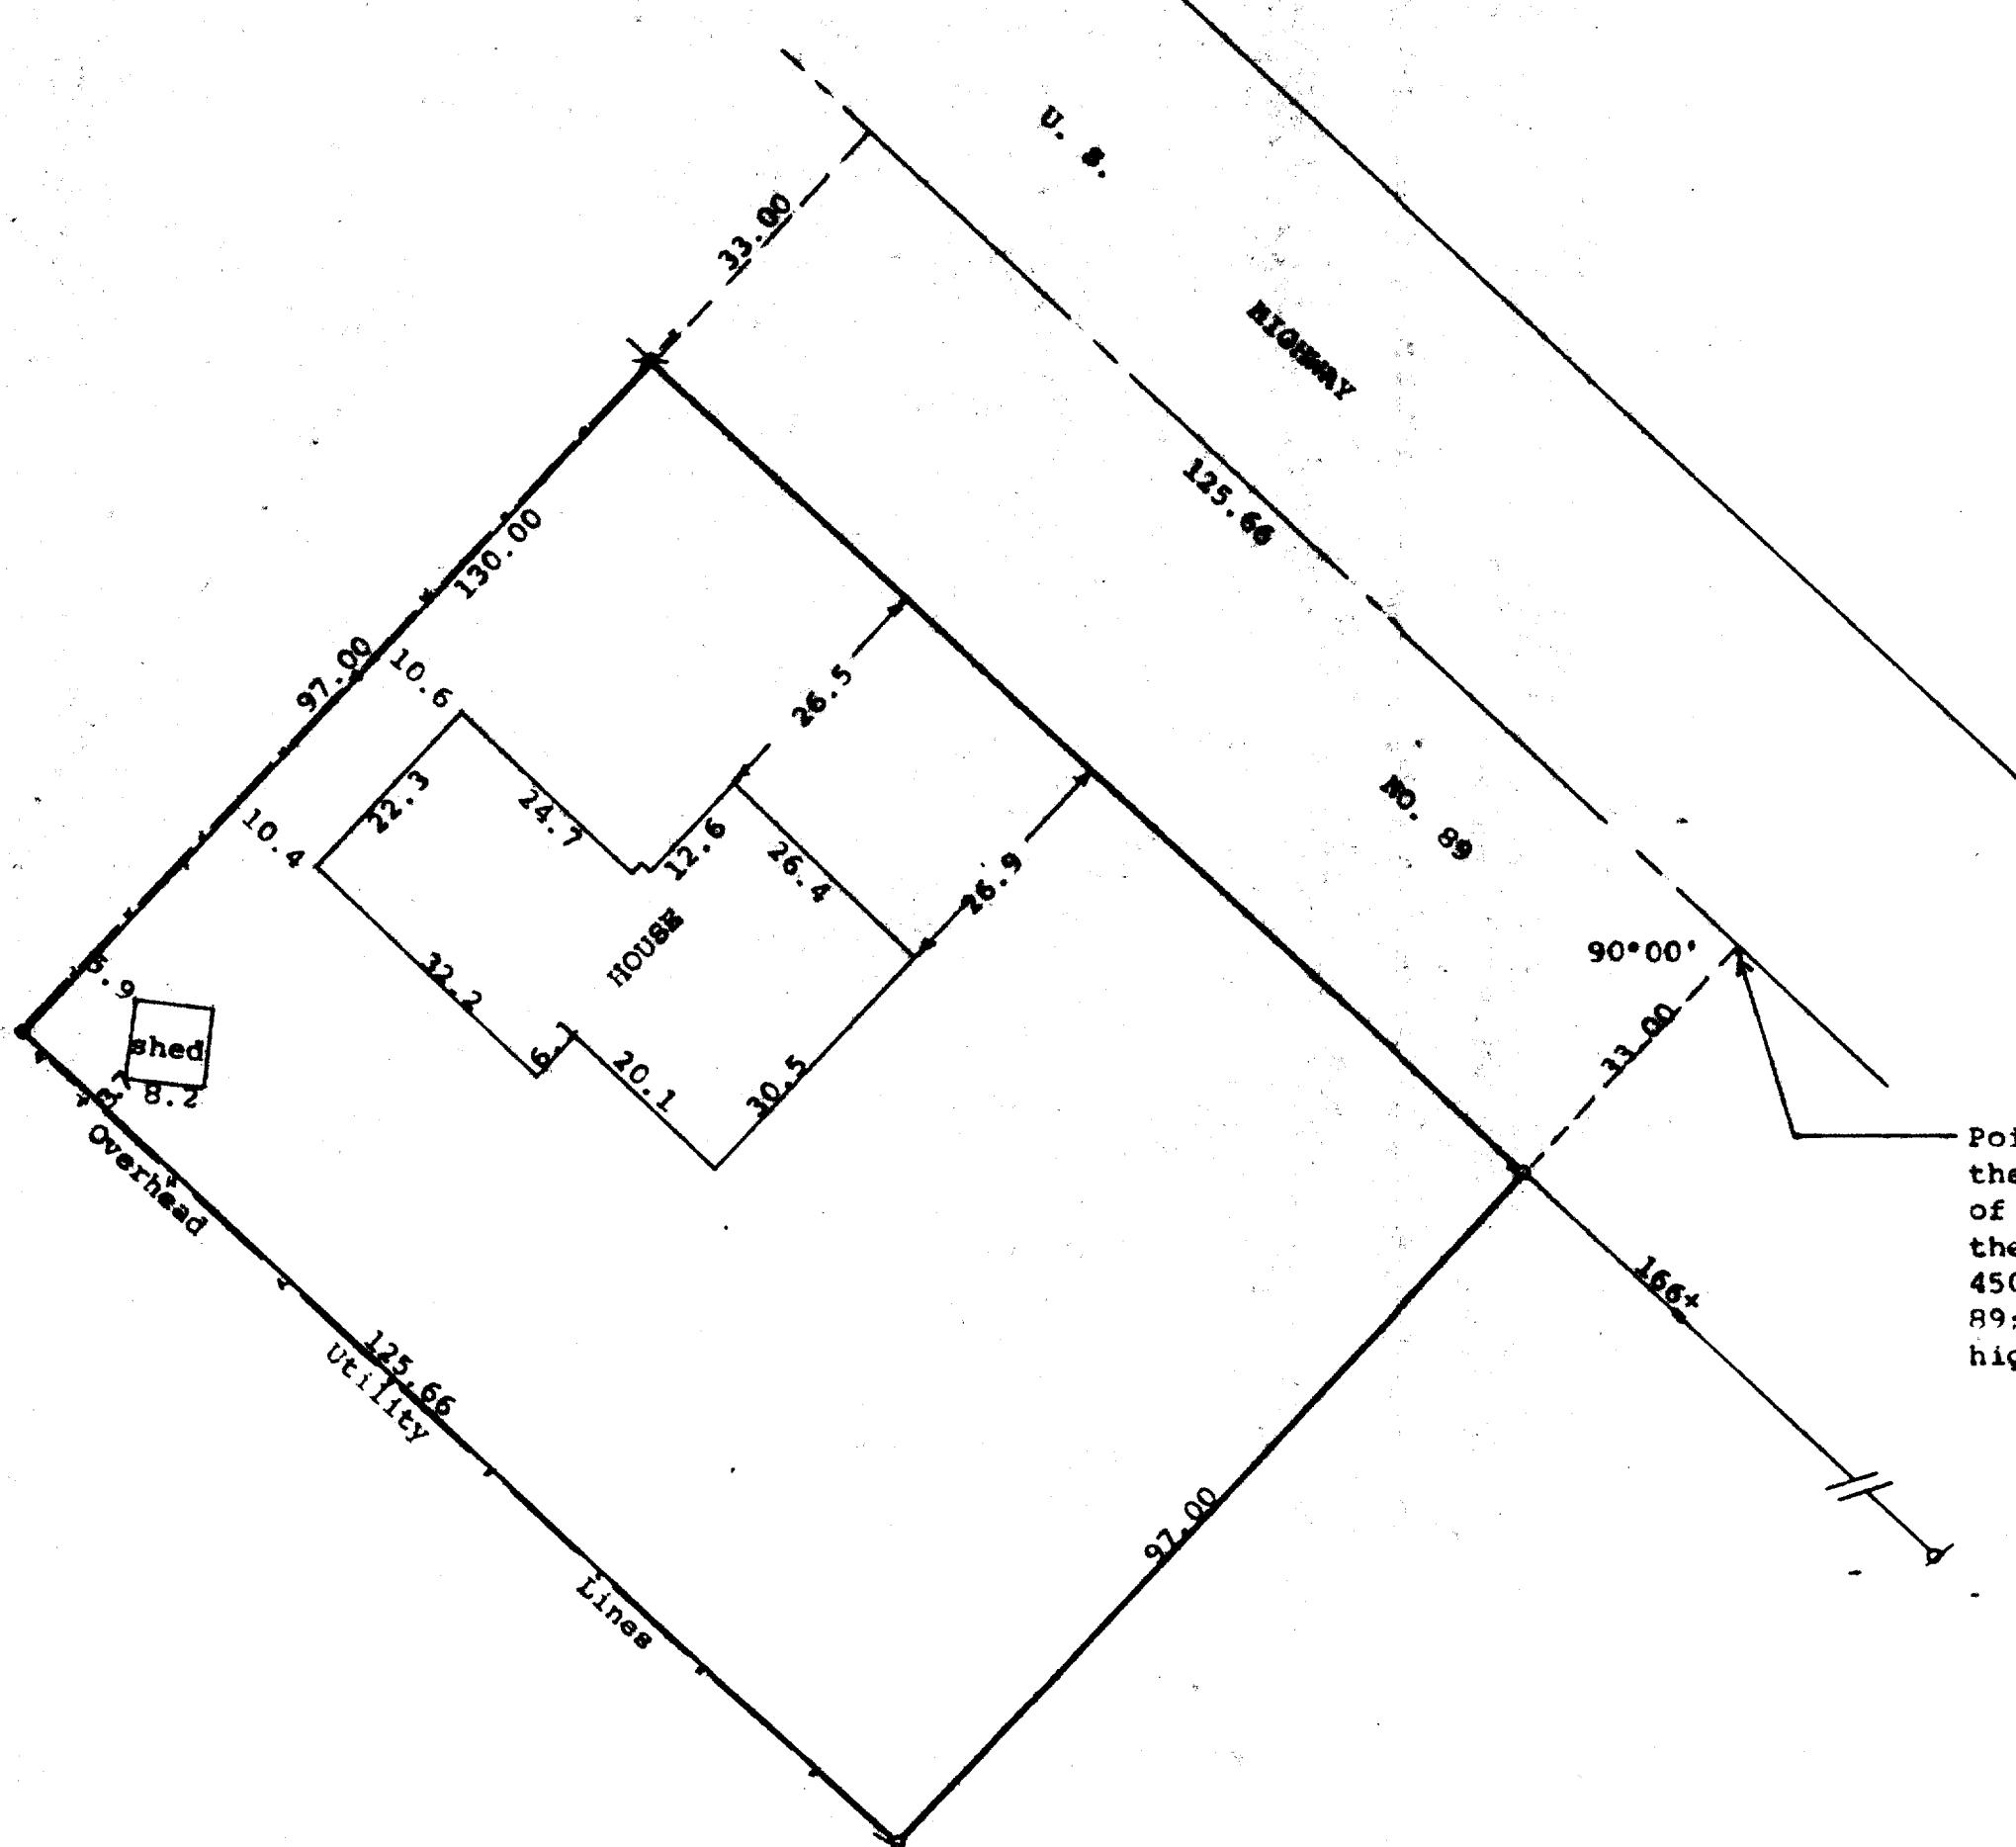

Scale - 1" = 20'
 - - - = 1 1/4" Iron Pipe Found
 - - = 3/4" Iron Pipe Found
 - - - - = 1 1/4" X 24" Iron Pipe Set
 - - = 3/4" Iron Pipe Found 0.76'
 southeast of correct corner.
 Pulled and set at correct point
 - - - - - = fence line
 Survey ordered by: The Rauland Agency
 Walworth, WI 53184

Point described as being located by commencing at the southwest corner of the South $\frac{1}{4}$ of the North $\frac{1}{4}$ of the NE $\frac{1}{4}$ of the NE $\frac{1}{4}$ of Section 34, T 2 N, R 15 E; thence East along the south line of said South $\frac{1}{4}$, 450.1 feet to the centerline of S. T. Highway No. 89; thence northwest along the centerline of said highway 199.84 feet to the place of beginning

STATE OF WISCONSIN) ss
COUNTY OF WALWORTH)

I, George T. Dunham, Surveyor, certify that I have surveyed the property described as follows:

A parcel of land located in the South $\frac{1}{4}$ of the North $\frac{1}{4}$ of the Northeast $\frac{1}{4}$ of the Northeast $\frac{1}{4}$ of Section 34, T 2 N, R 15 E, Village of Darien, Walworth County, Wisconsin, described as follows: Commencing at the southwest corner of said South $\frac{1}{4}$; thence East along the south line of said South $\frac{1}{4}$, 450.1 feet to the centerline of State Trunk Highway No. 89; thence northwest along the centerline of said highway 199.84 feet to the place of beginning; thence southwest at right angles to said centerline 130.00 feet; thence northwest parallel to said centerline 125.66 feet; thence northeast 130.00 feet to said centerline; thence southeast along said centerline 125.66 feet to the place of beginning

and that the plat shown hereon is a correct representation thereof and shows the size and location of the property, its exterior boundaries, the location of all visible structures and dimensions of all principal buildings thereon, boundary fences, apparent easements, roadways and visible encroachments, if any, and that I have surveyed the property hereon described, according to the official records, to the best of my knowledge and belief.

March 23, 1990

George T. Dunham
George T. Dunham, Surveyor

