


GEORGE T. DUNHAM
SURVEYING & SUBDIVIDING
DELAVER, WISCONSIN

N

Scale - 1" = 20'

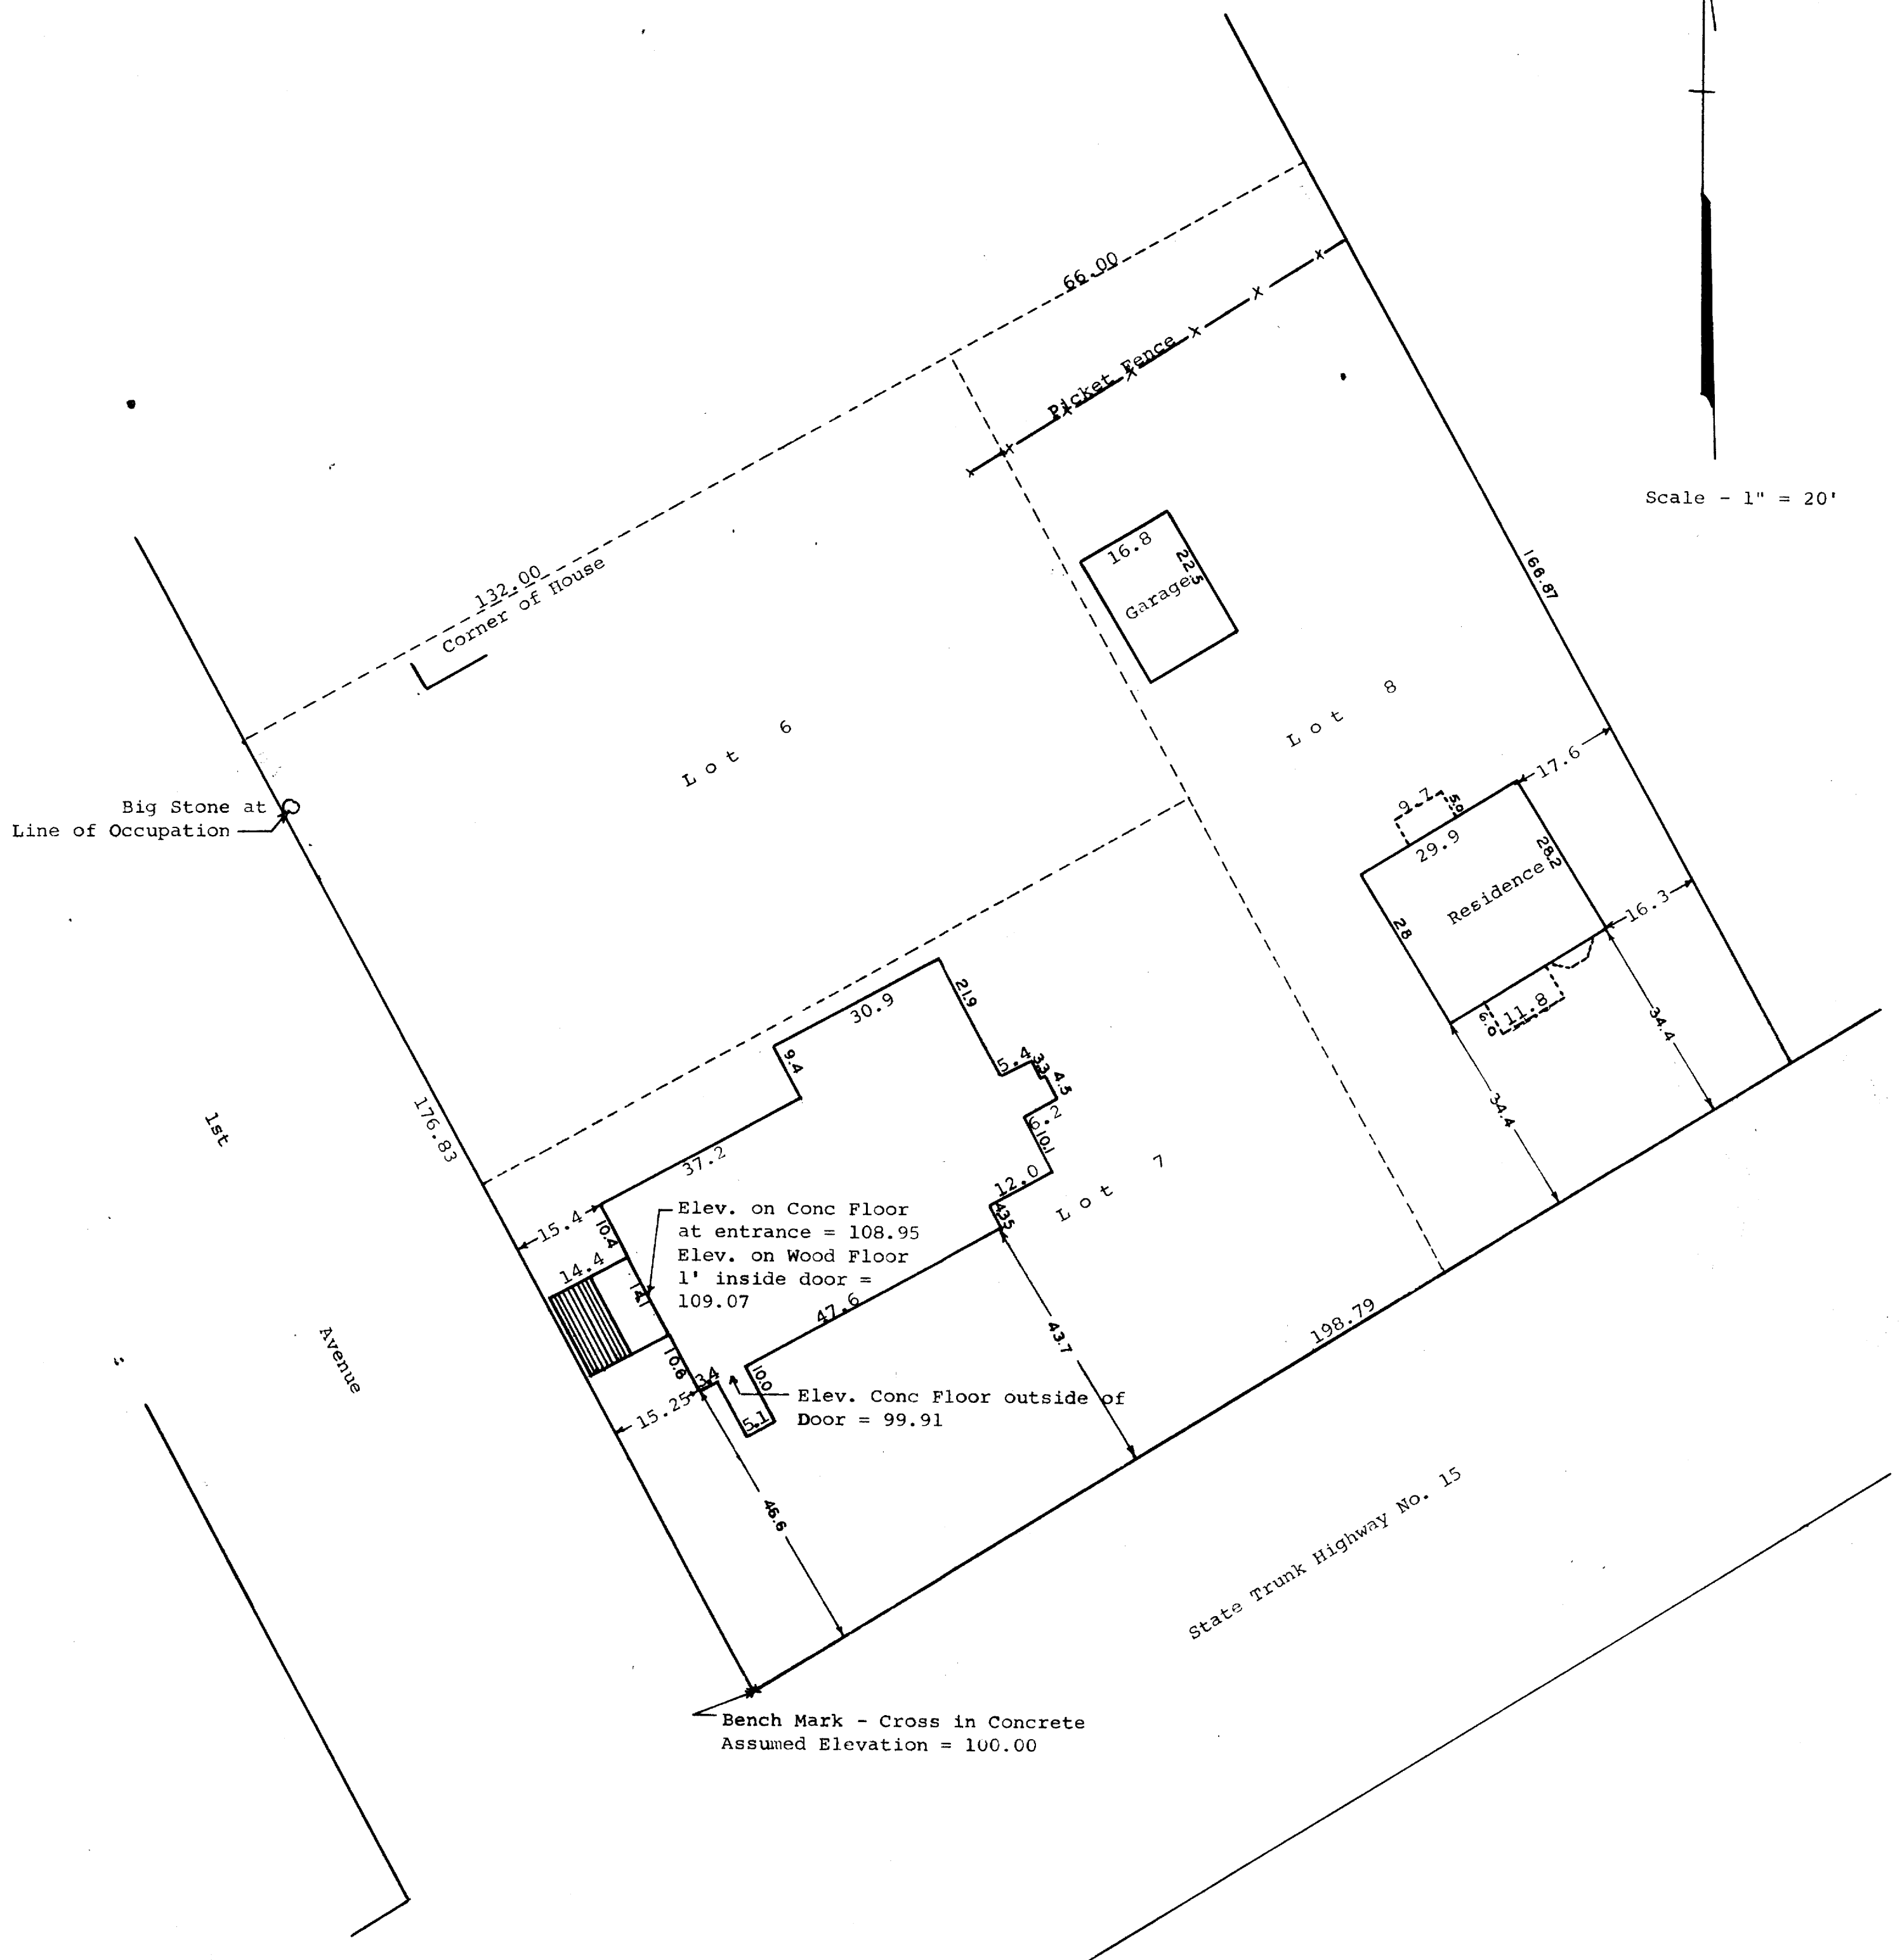

Plat of survey of Lots 6, 7, & 8, in Block 9 of the
Original Plat of the Village of Darien, Walworth
County, Wisconsin
May, 1965

George T. Dunham
George T. Dunham, Surveyor