


**ABELL
SURVEYING & MAPPING
DEHAVAN, WISCONSIN 53115
414-728-6757**


NOTE: THE BEARINGS ARE REFERENCED TO THE NORTH LINE
OF LOT 7 AS SHOWN ON THE SUBDIVISION PLAT.

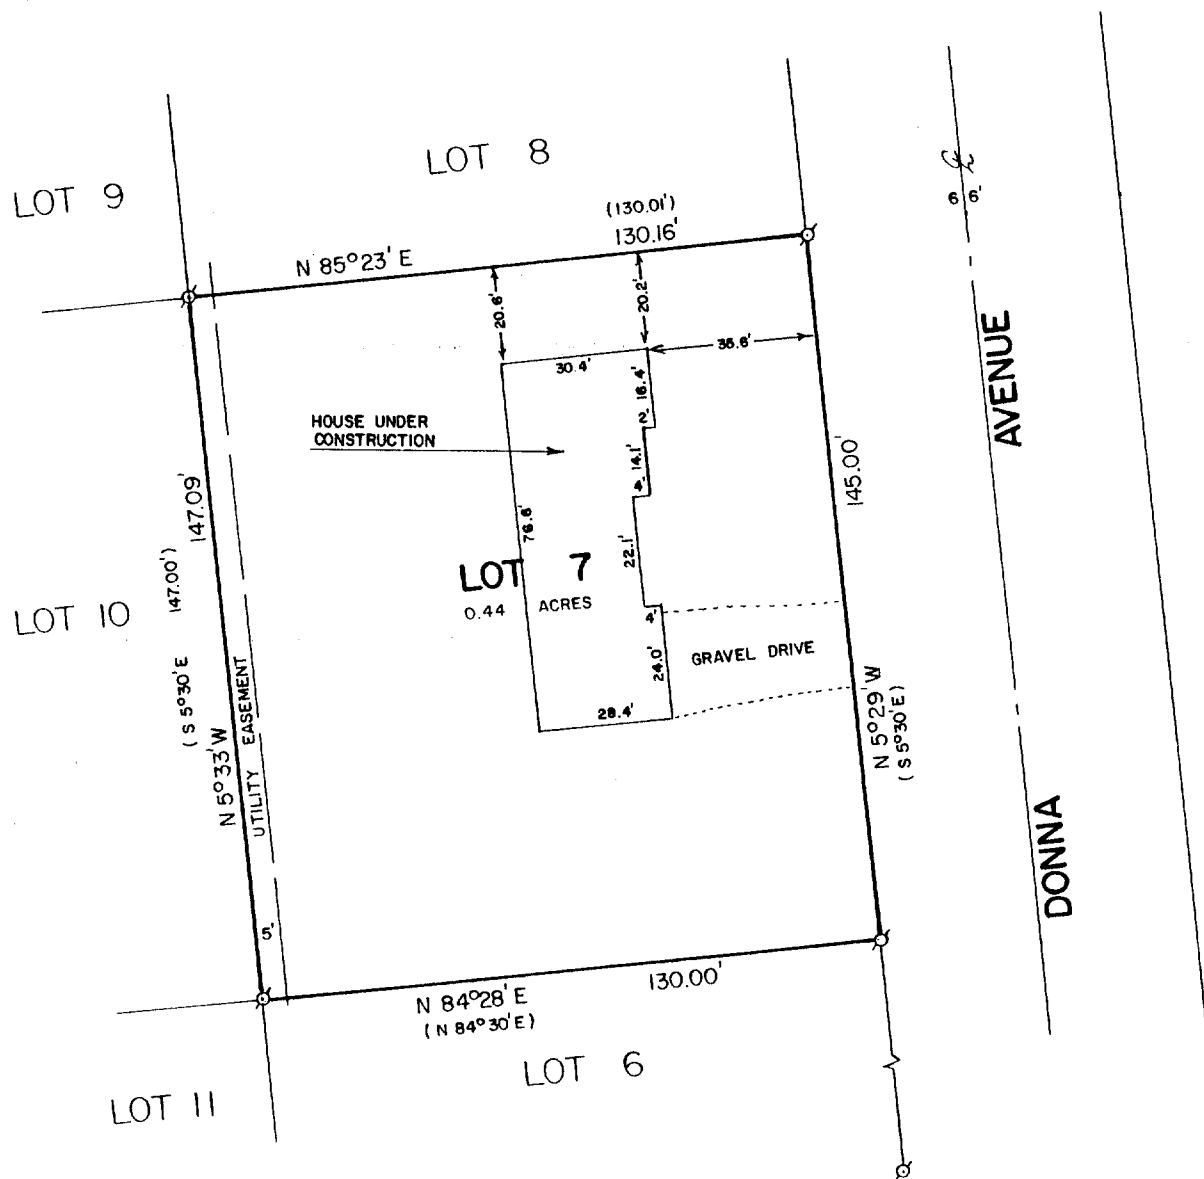

PLAT OF SURVEY OF

LOT 7 OF OLESTON'S SUBDIVISION, LOCATED IN THE VILLAGE
OF DARIEN, WALWORTH COUNTY, WISCONSIN.

ORDERED BY: CENTURY 21 - SKANDIA REALTY
312 S. 7th STREET
DEHAVAN, WI. 53115

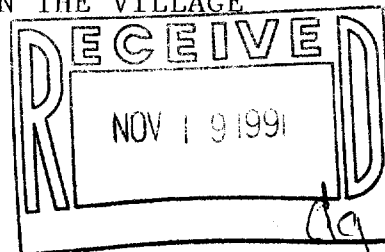

REVISED: JULY 2, 1991
ORDERED BY: ANCHOR SAVINGS & LOAN
DEHAVAN, WI. 53115



SCALE - 1"=40'

LEGEND

⊗ - IRON PIPE FOUND
() - RECORDED AS

I HEREBY CERTIFY THAT I HAVE SURVEYED THE ABOVE DESCRIBED PROPERTY AND THAT THE
ABOVE MAP IS A TRUE REPRESENTATION THEREOF AND SHOWS THE SIZE AND LOCATION OF
THE PROPERTY, ITS EXTERIOR BOUNDARIES, THE LOCATION OF ALL VISIBLE STRUCTURES
AND DIMENSIONS OF ALL PRINCIPAL BUILDINGS THEREON, BOUNDARY FENCES, APPARENT
EASEMENTS, ROADWAYS AND VISIBLE ENCROACHMENTS, IF ANY, TO THE BEST OF MY
KNOWLEDGE AND BELIEF.

THIS SURVEY IS MADE FOR THE USE OF THE PRESENT OWNERS OF THE PROPERTY, AND ALSO
THOSE WHO PURCHASE, MORTGAGE, OR GUARANTEE THE TITLE THERETO WITHIN ONE (1) YEAR
FROM DATE HEREOF.

David F. Abell

DAVID F. ABELL
WISCONSIN REGISTERED LAND SURVEYOR, S-1596

April 4, 1990

DATE *April 4, 1990* JOB NUMBER - 90056
NOTE: THIS IS NOT A CERTIFIED COPY UNLESS SEALED.

001-260

QO-7