


DUNHAM SURVEYING, S.C.
SURVEYING & SUBDIVIDING
DELAVER, WISCONSIN 53115

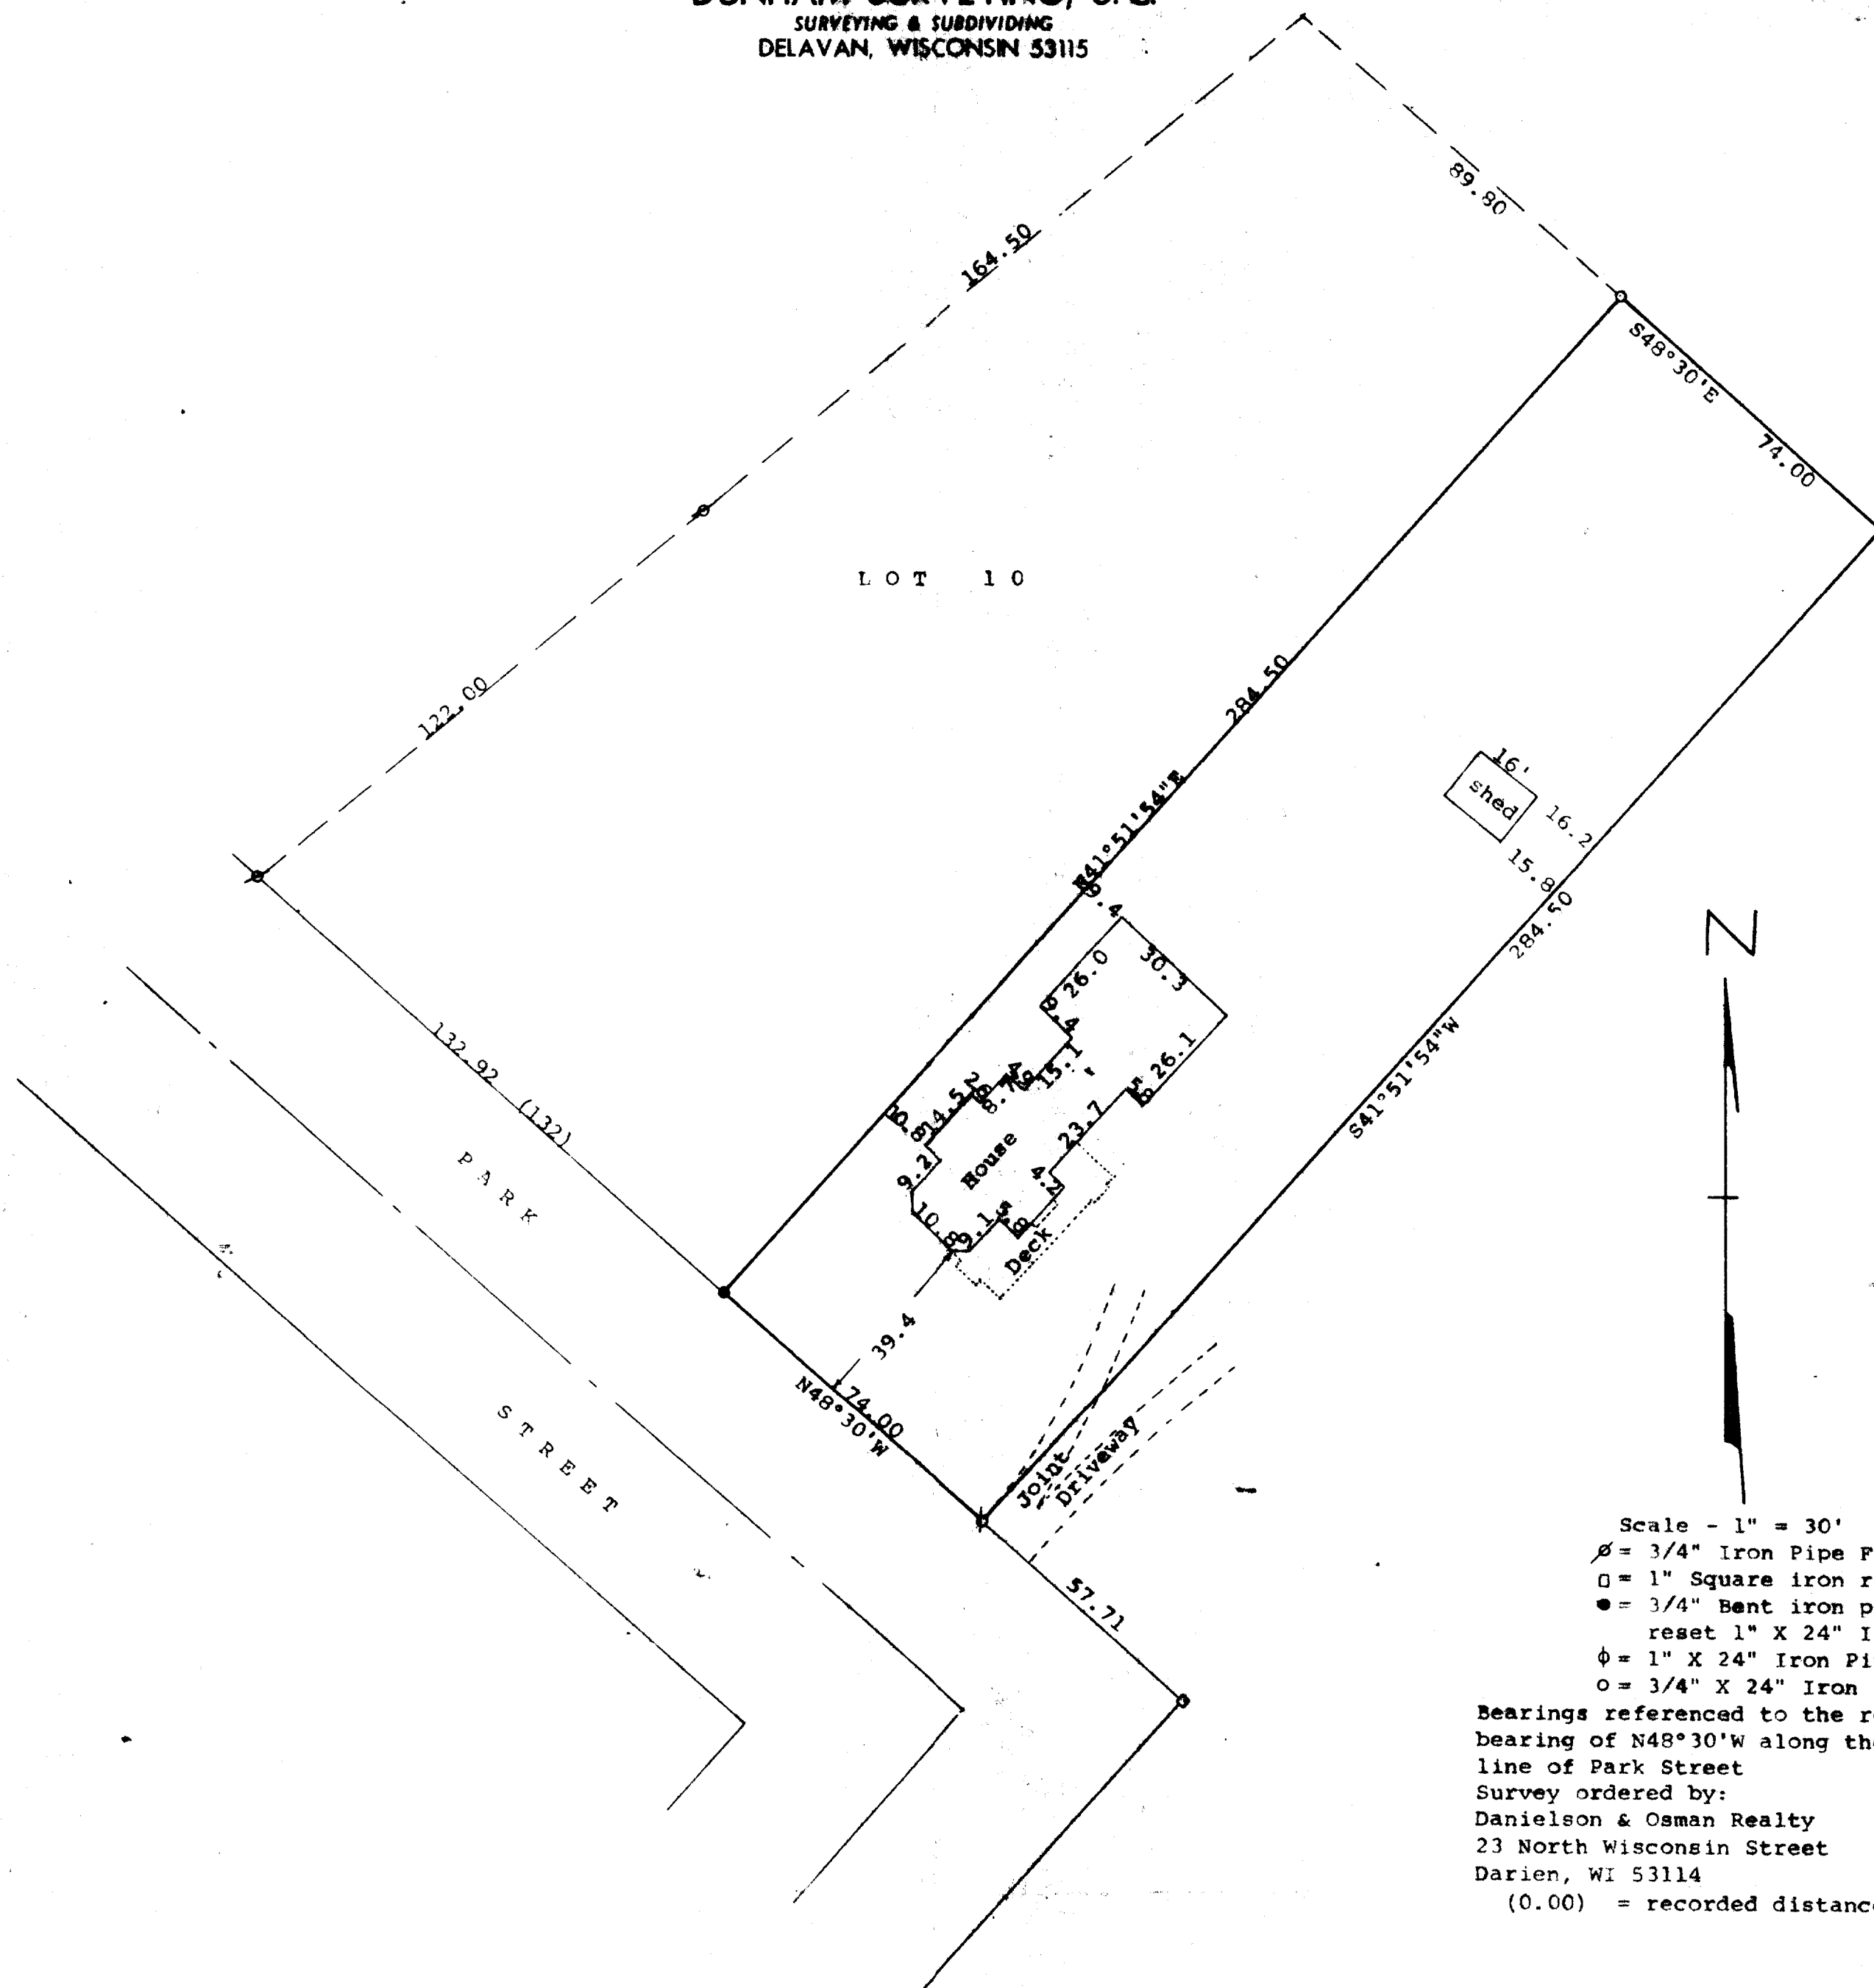

Scale - 1" = 30'

Ø = 3/4" Iron Pipe Found

□ = 1" Square iron rod found

● = 3/4" Bent iron pipe found and reset 1" X 24" Iron Pipe

φ = 1" X 24" Iron Pipe Set

○ = 3/4" X 24" Iron Pipe Set

Bearings referenced to the recorded bearing of N48°30'W along the northeasterly line of Park Street

Survey ordered by:

Danielson & Osman Realty

23 North Wisconsin Street

Darien, WI 53114

(0.00) = recorded distance

STATE OF WISCONSIN)ss
COUNTY OF WALWORTH)

I, George T. Dunham, Surveyor, certify that I have surveyed the property described as follows:

A parcel of land located in the Southeast 1/4 of Section 27, T 2 N, R 15 E, Village of Darien, Walworth County, Wisconsin, described as follows: Beginning at the most southerly corner of Lot 10 in Block 26 of the Fourth Addition to the Village of Darien; thence N41°51'54"E along the southeasterly line of said Lot 10, 284.50 feet to the northeast corner of said Lot 10; thence S48°30'E parallel to the northeasterly line of Park Street, 74.00 feet; thence S41°51'54"W parallel with the southeasterly line of said Lot 10, 284.50 feet to the northeasterly line of said Park Street; thence N48°30'W along said northeasterly line 74.00 feet to the place of beginning, subject to easements of record,

and that the plat shown hereon is a correct representation thereof and shows the size and location of the property, its exterior boundaries, the location of all visible structures and dimensions of all principal buildings thereon, boundary fences, apparent easements, roadways and visible encroachments, if any, and that I have surveyed the property hereon described, according to the official records, to the best of my knowledge and belief.

March 14, 1991

George T. Dunham
George T. Dunham, Surveyor

