


DUNHAM SURVEYING, S.C.
SURVEYING & MAPPING
DARIEN, WISCONSIN 53114

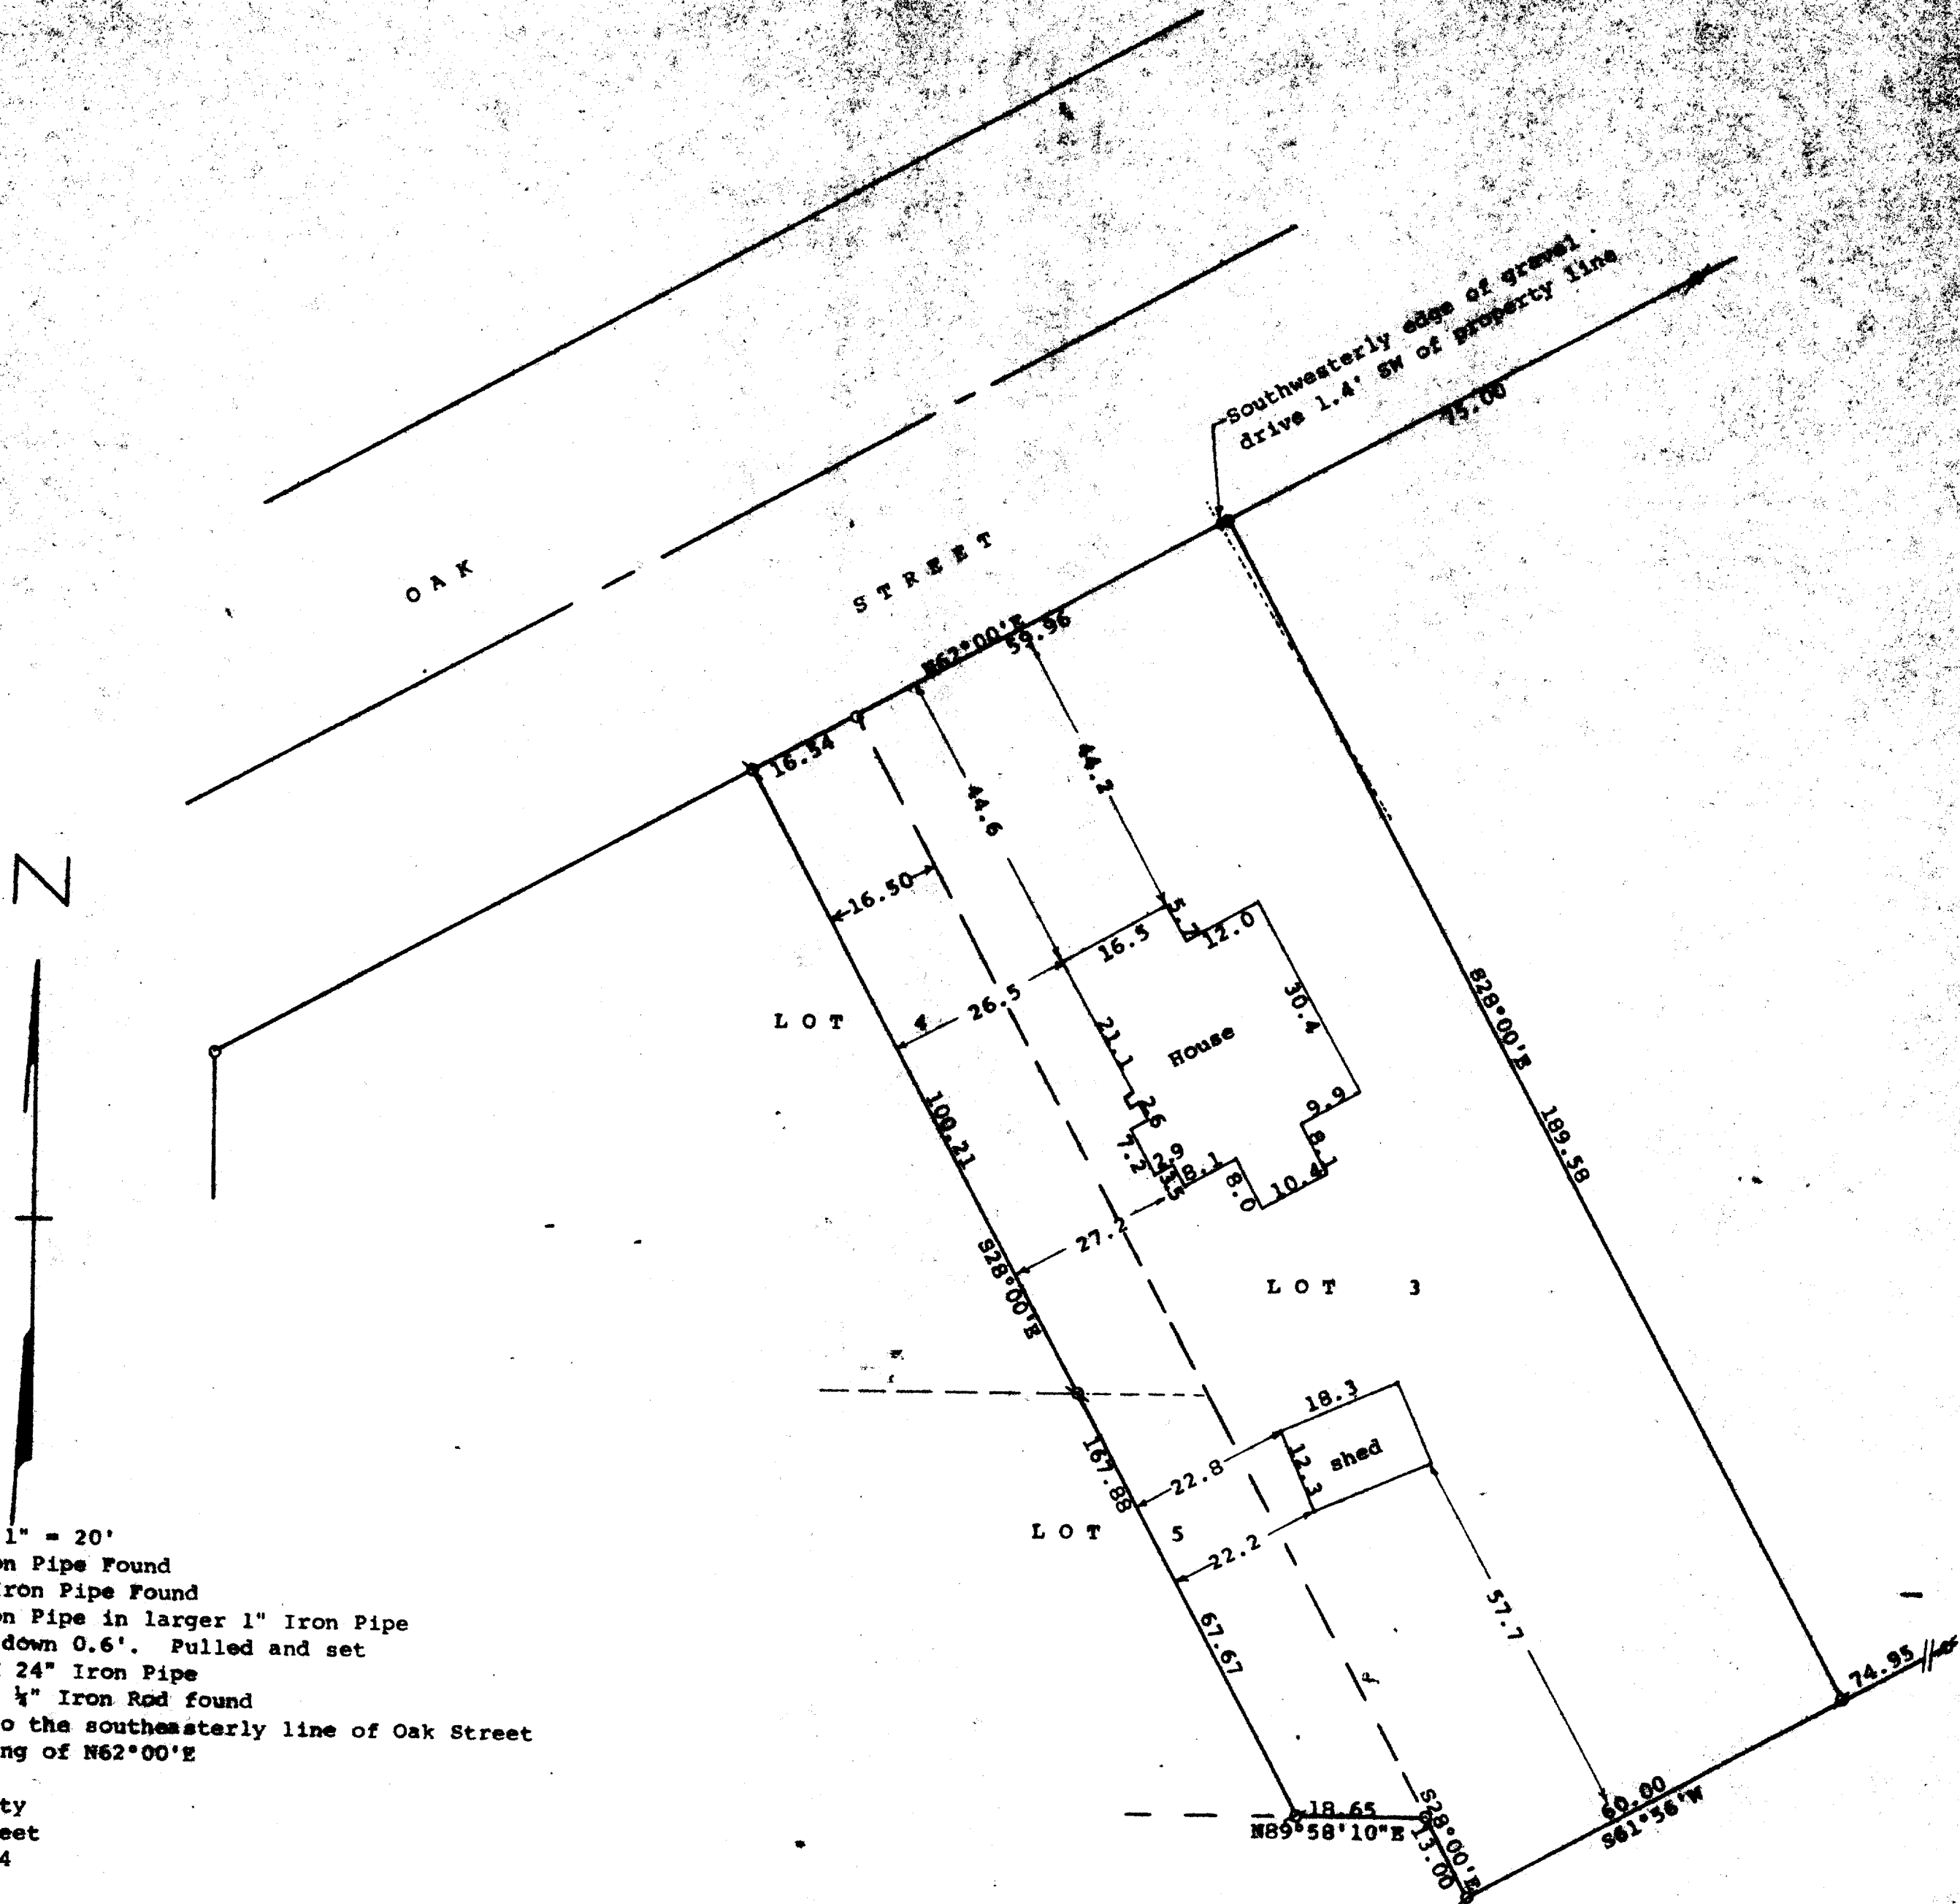

Scale - 1" = 20'

1" = 1" Iron Pipe Found
3/4" = 3/4" Iron Pipe Found
1/2" = 1/2" Iron Pipe in larger 1" Iron Pipe
found down 0.6'. Pulled and set
3/4" X 24" Iron Pipe
O = nut on 1/4" Iron Rod found

Bearings referenced to the southeasterly line of Oak Street
with the assumed bearing of N62°00'E

Survey ordered by:
Danielson & Osman Realty
23 North Wisconsin Street
Darien, Wisconsin 53114

STATE OF WISCONSIN) ss
COUNTY OF WALWORTH)

I, George T. Dunham, Surveyor, certify that I have surveyed the
property described as follows:

Lot 3, Block 3 and the northeasterly 16.50 feet of Lots 4 and 5,
Brigham and Sawyer Subdivision, Village of Darien, Walworth
County, Wisconsin

and that the plat shown hereon is a correct representation thereof and shows
the size and location of the property, its exterior boundaries, the location
of all visible structures and dimensions of all principal buildings thereon,
boundary fences, apparent easements, roadways and visible encroachments, if
any, and that I have surveyed the property hereon described, according to the
official records, to the best of my knowledge and belief.
July 23, 1992

George T. Dunham
George T. Dunham, Surveyor

