



**ABELL
SURVEYING & MAPPING**
DELAVAN, WISCONSIN 53115
414-728-6737

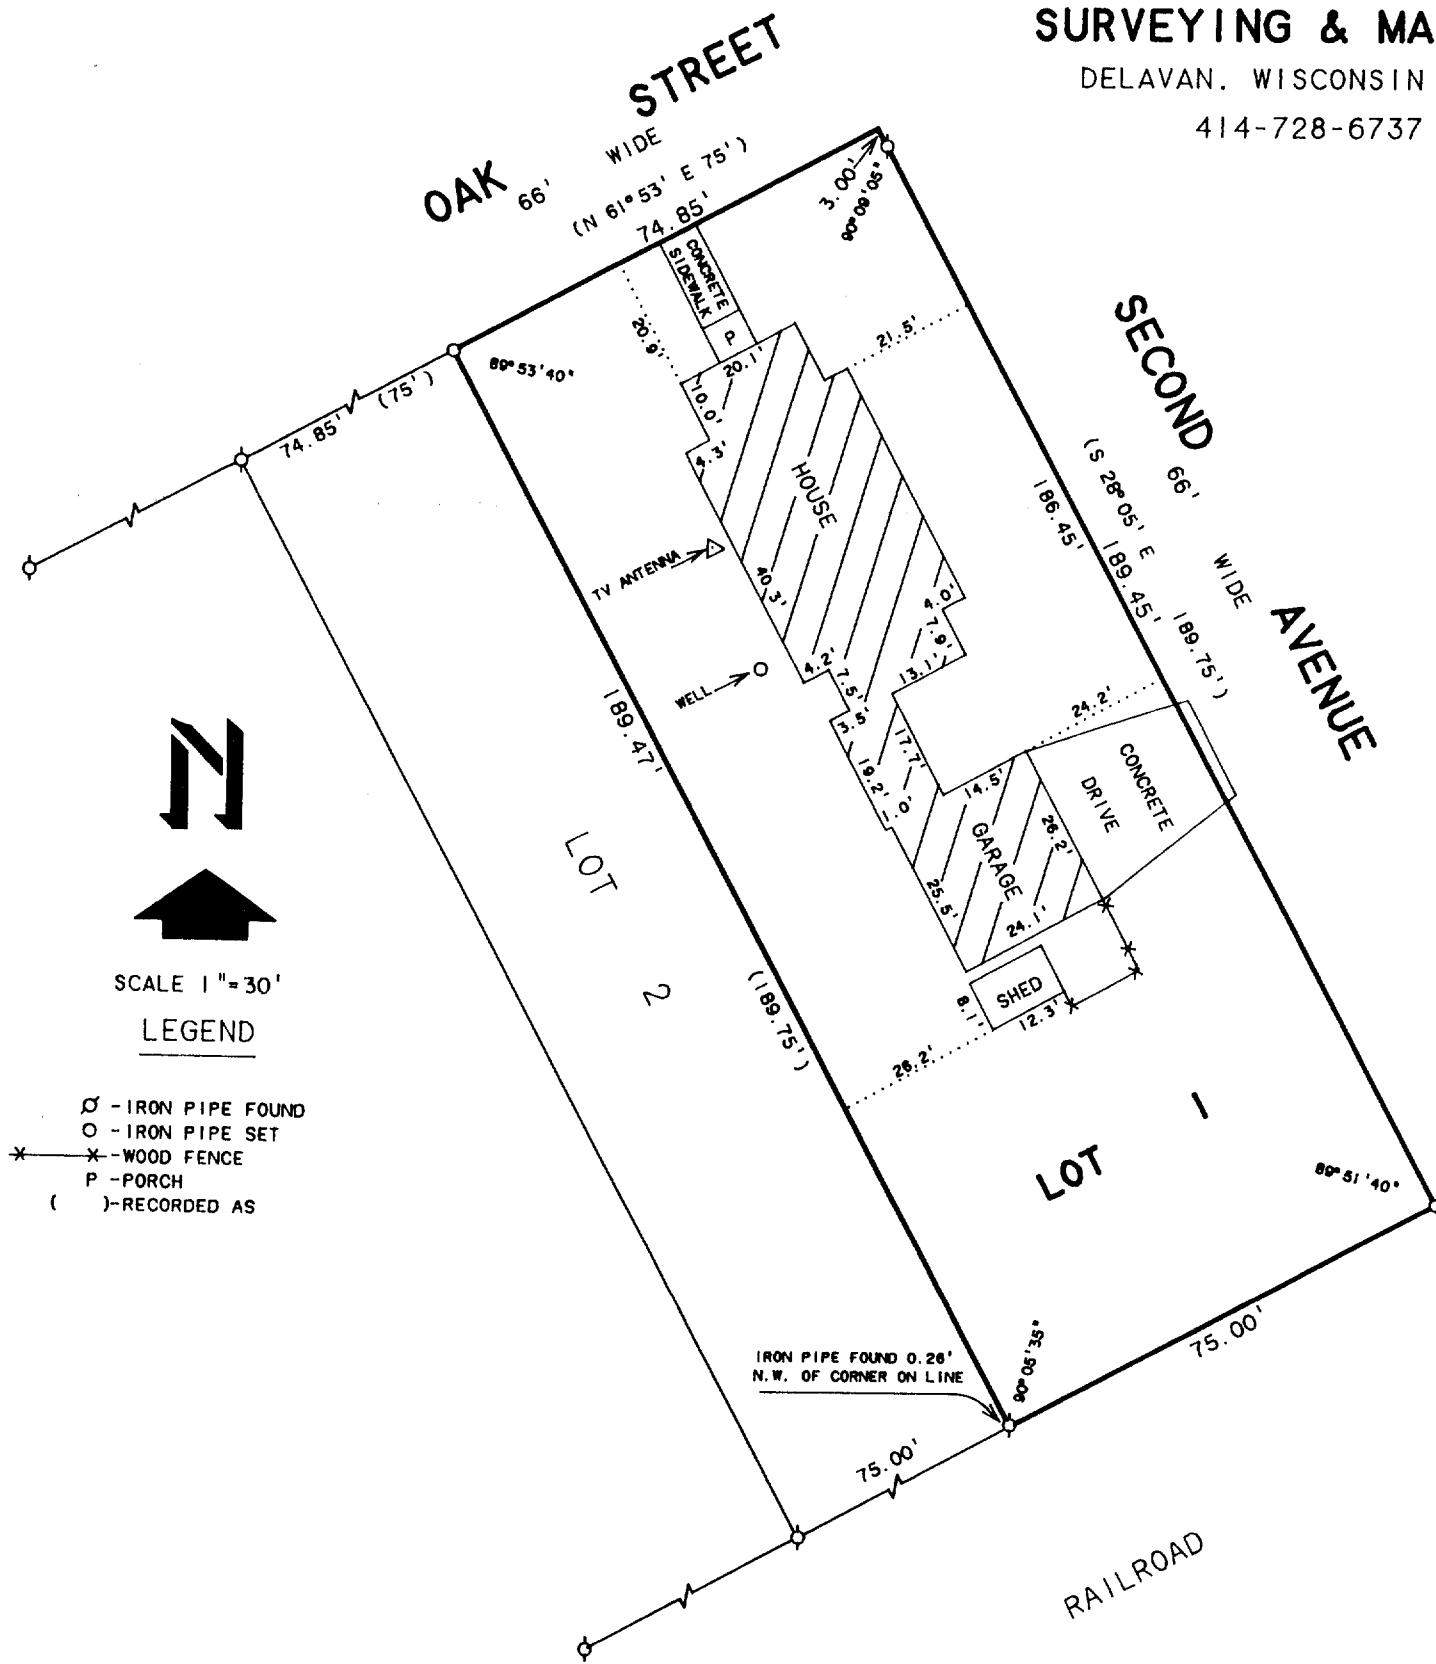

PLAT OF SURVEY OF

Lot 1 of Brigham and Sawyer Subdivision, Village of Darien, Walworth County, Wisconsin, said premises also being known as Beginning at the NE'ly corner of Block 3 of the Village of Darien, according to the original plat of said Village as the point of beginning, thence W'ly 75 feet on the N'ly line of said Block 3 to a point; thence SE'ly on a line 189.75 feet and parallel with the W'ly boundary line of Second Avenue to a point, thence NE'ly on a line 75 feet and parallel with the N'ly line of said Block 3 to a point on the W'ly line of Second Avenue, thence NW'ly along the W'ly line of Second Avenue, 189.75 feet to the point of beginning, together with the buildings thereon and all the privileges and appurtenances to the same belonging.

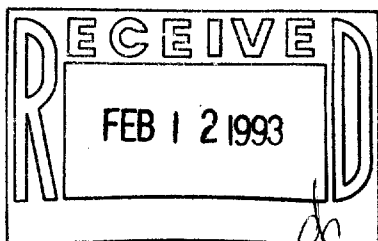

ORDERED BY: PROFESSIONAL REALTY
706 E. GENEVA ST.
DELAVAN, WI. 53115

I HEREBY CERTIFY THAT I HAVE SURVEYED THE ABOVE DESCRIBED PROPERTY AND THAT THE ABOVE MAP IS A TRUE REPRESENTATION THEREOF AND SHOWS THE SIZE AND LOCATION OF THE PROPERTY, ITS EXTERIOR BOUNDARIES, THE LOCATION OF ALL VISIBLE STRUCTURES AND DIMENSIONS OF ALL PRINCIPAL BUILDINGS THEREON, BOUNDARY FENCES, APPARENT EASEMENTS, ROADWAYS AND VISIBLE ENCROACHMENTS, IF ANY, TO THE BEST OF MY KNOWLEDGE AND BELIEF.

THIS SURVEY IS MADE FOR THE USE OF THE PRESENT OWNERS OF THE PROPERTY, AND ALSO THOSE WHO PURCHASE, MORTGAGE, OR GUARANTEE THE TITLE THERETO WITHIN ONE (1) YEAR FROM DATE HEREON.

David F. Abell

DAVID F. ABELL
WISCONSIN REGISTERED LAND SURVEYOR, S-1596

October 12, 1992

DATE: JOB NUMBER - 92230
NOTE: THIS IS NOT A CERTIFIED COPY UNLESS SEALED.

DB&S-1

001-279