


GEORGE T. DUNHAM
SURVEYING & SUBDIVIDING
DELAVER, WISCONSIN

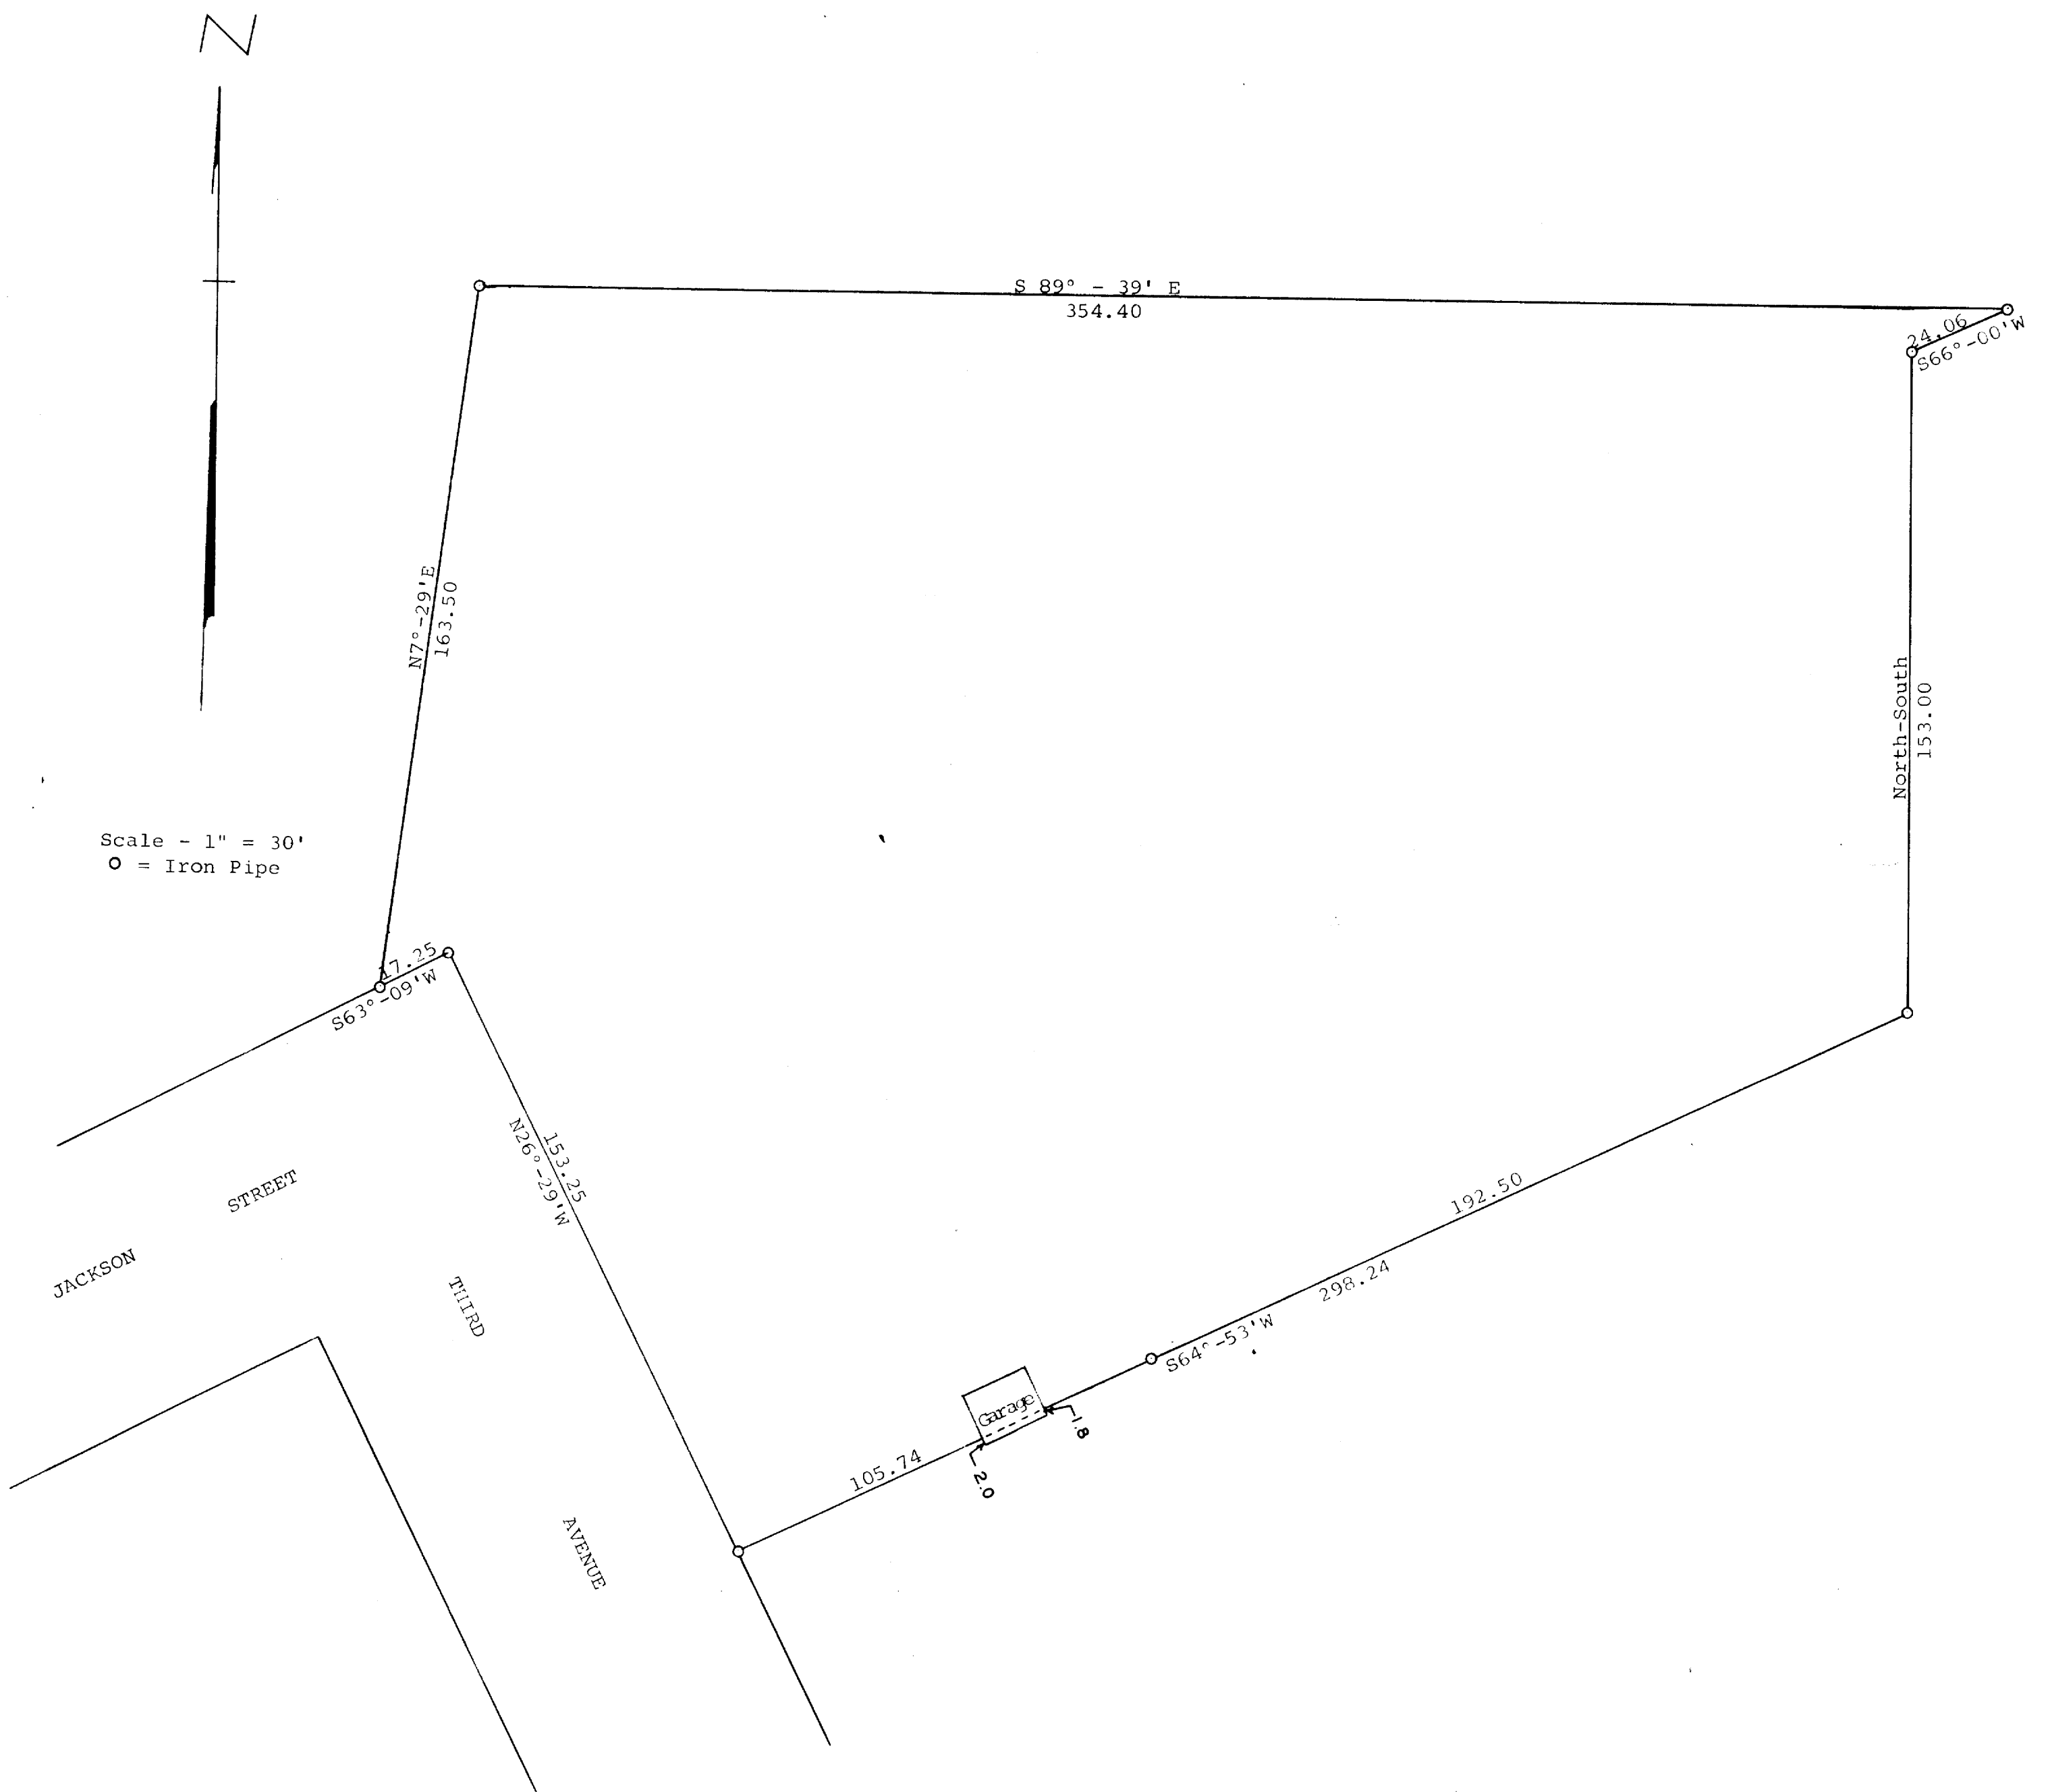

Plat of survey of the James Cooper Land located in
the Northeast $\frac{1}{4}$ of Section 27, T 2 N, R 15 E, Village
of Darien, Walworth County, Wisconsin.
January 16, 1968

George T. Dunham
George T. Dunham, Surveyor