


DUNHAM SURVEYING, S.C.
SURVEYING & SUBDIVIDING
DELAVER, WISCONSIN 53115

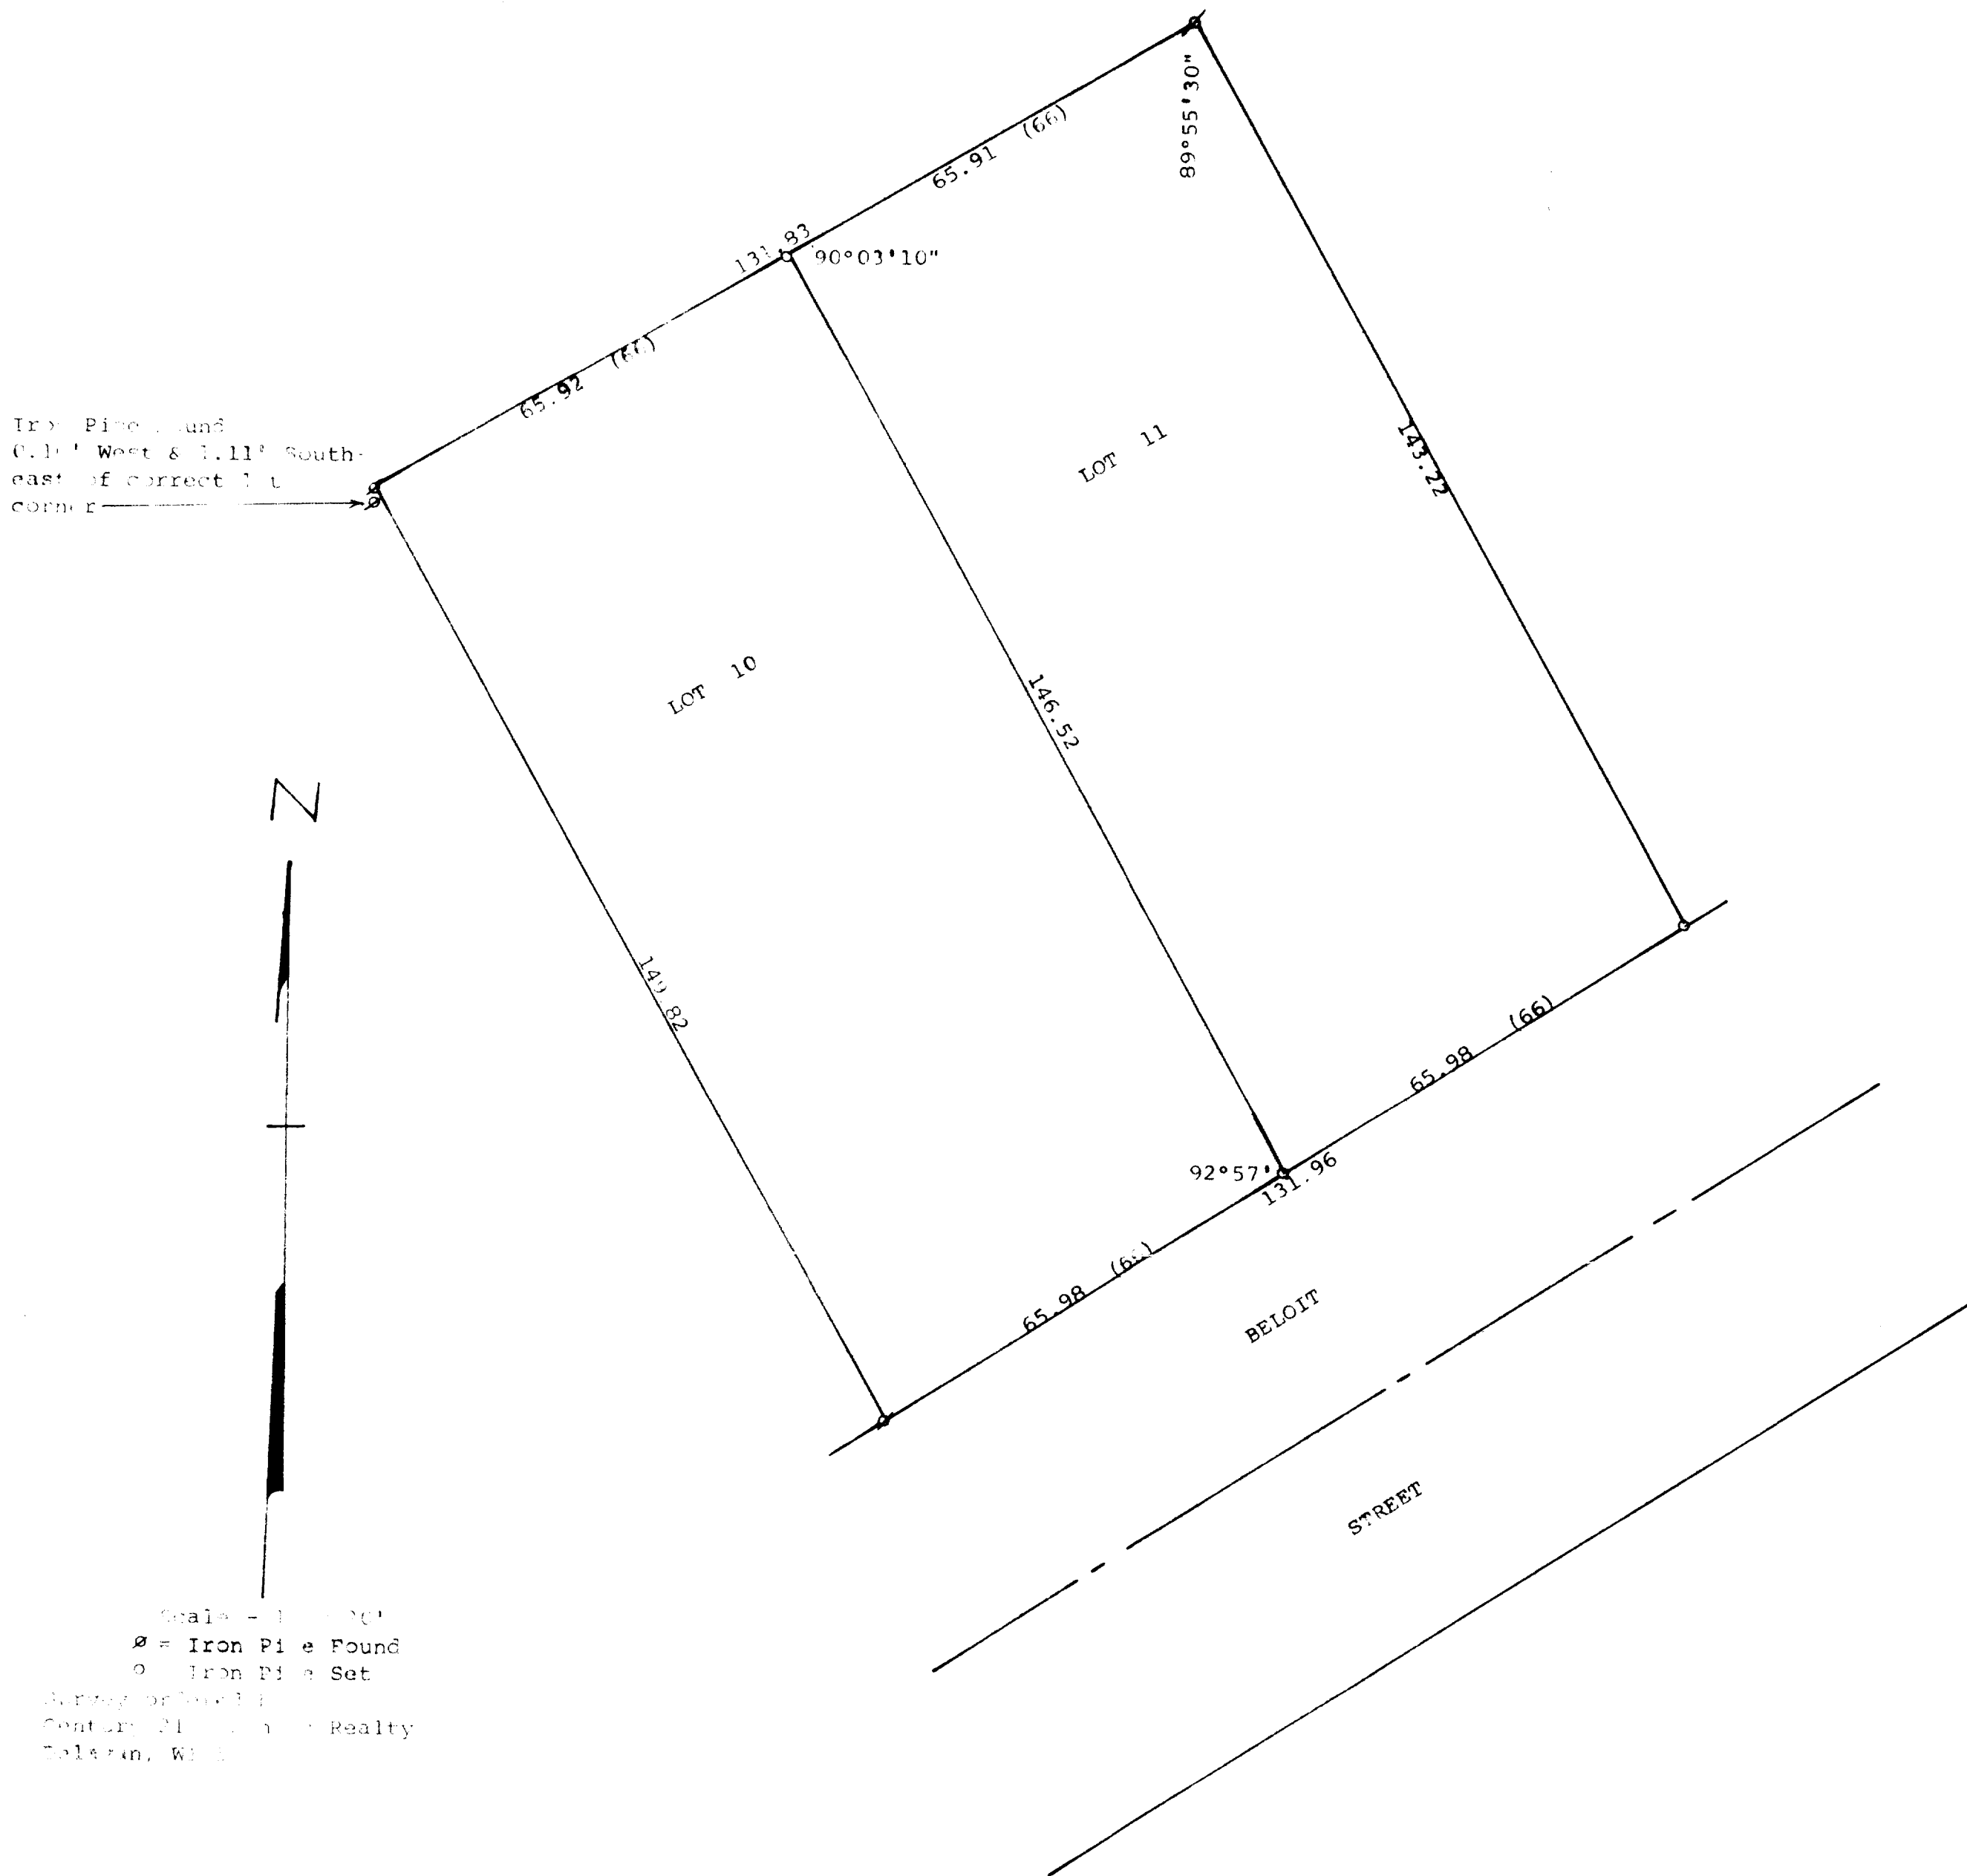

STATE OF WISCONSIN) ss
COUNTY OF WAUWATOSH)

I, George T. Dunham, Surveyor, certify that I have surveyed the property described as follows,

Lots 10 and 11 in Block 10 of the Original Plat of the Village of Darien, Wauwatosh County, Wisconsin, and that the plat shown hereon is a correct representation thereof and shows the size and location of the property, its exterior boundaries, the location of all permanent structures and dimensions of all principal buildings thereon, boundary fences, apparent easements, roadways and visible encroachments, if any, and that I have surveyed the property hereon described, according to the official records, to the best of my knowledge and belief.

November 12, 1999

George T. Dunham
George T. Dunham, Surveyor

