


ABELL
SURVEYING & MAPPING


1140 SEQUOIA STREET • DELAVAN, WISCONSIN 53115

262-728-6737

ORDERED BY: KEEFE REAL ESTATE
1155 E. GENEVA STREET
DELAVAL, WI 53115

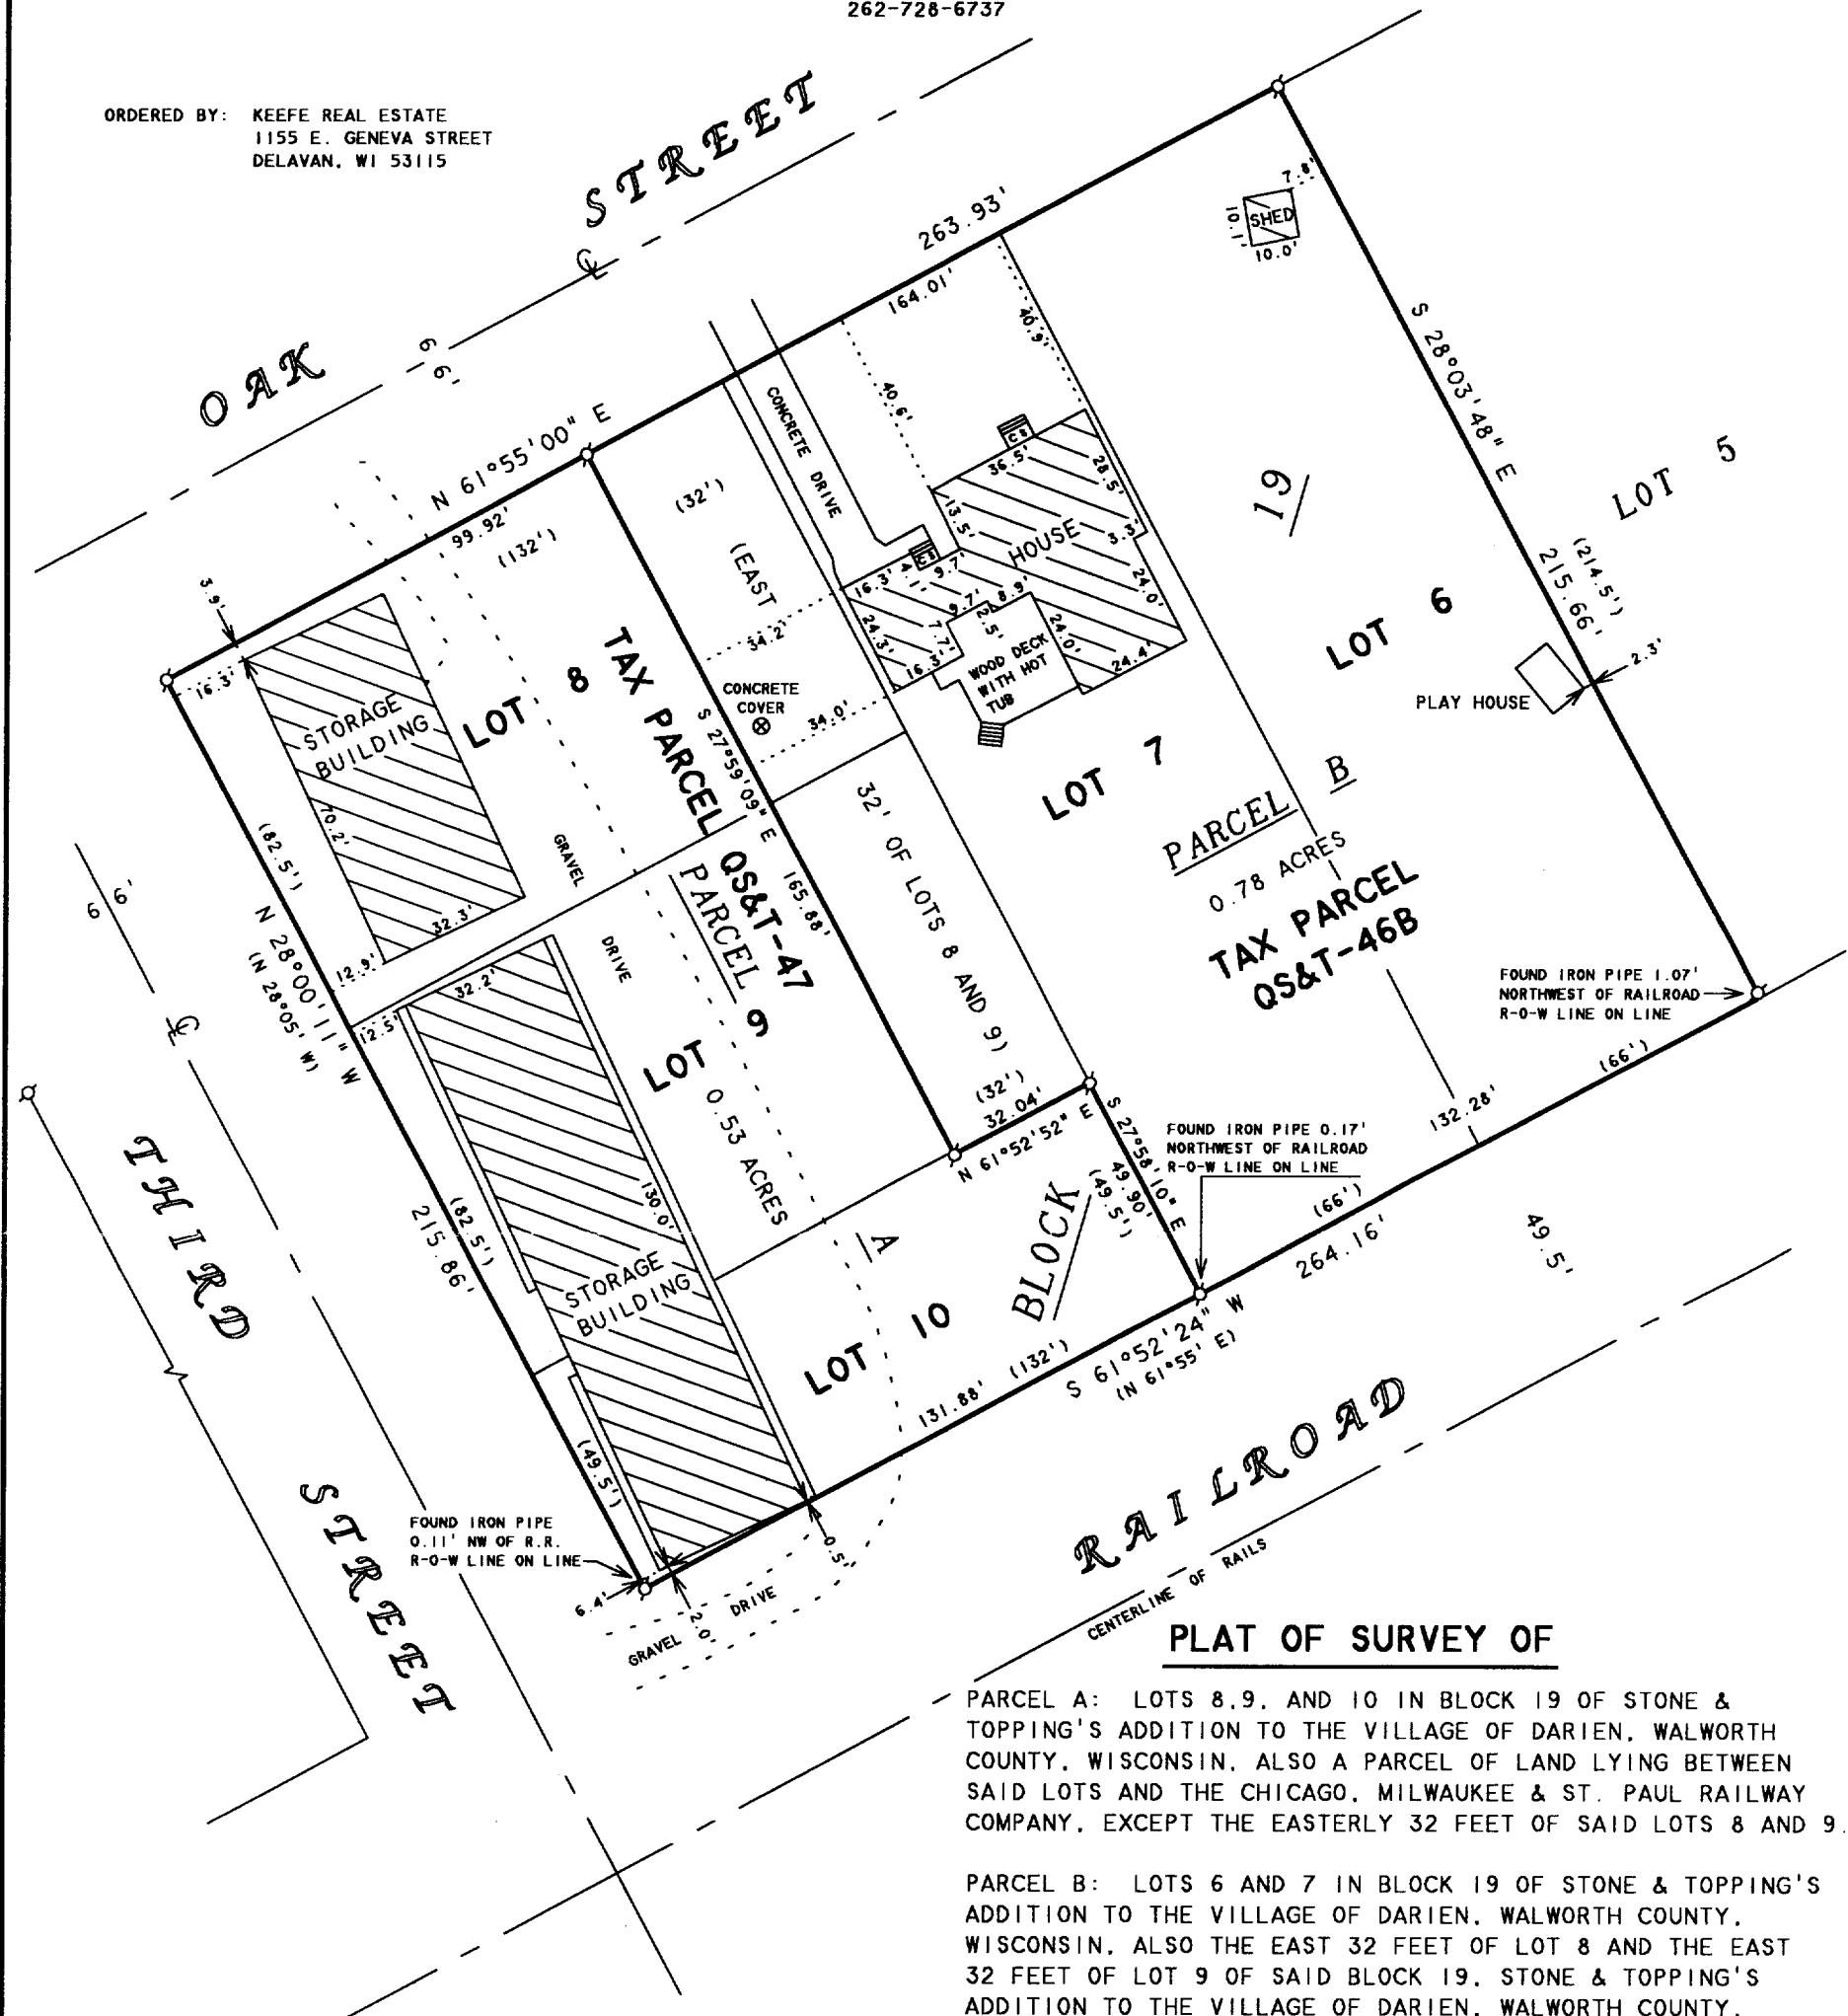

BEARINGS ARE REFERENCED TO THE
RECORDED SUBDIVISION PLAT.

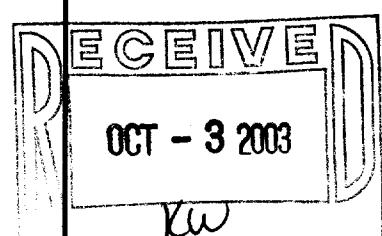

N



SCALE 1"=40'

LEGEND

- - IRON PIPE FOUND
- CS - CONCRETE STOOP
- () - RECORDED AS

I HEREBY CERTIFY THAT I HAVE SURVEYED THE ABOVE DESCRIBED PROPERTY AND THAT THE ABOVE MAP IS A TRUE REPRESENTATION THEREOF AND SHOWS THE SIZE AND LOCATION OF THE PROPERTY, ITS EXTERIOR BOUNDARIES, THE LOCATION OF ALL VISIBLE STRUCTURES AND DIMENSIONS OF ALL PRINCIPAL BUILDINGS THEREON, BOUNDARY FENCES, APPARENT EASEMENTS, ROADWAYS AND VISIBLE ENCROACHMENTS, IF ANY, TO THE BEST OF MY KNOWLEDGE AND BELIEF.

THIS SURVEY IS MADE FOR THE USE OF THE PRESENT OWNERS OF THE PROPERTY, AND ALSO THOSE WHO PURCHASE, MORTGAGE, OR GUARANTEE THE TITLE THERETO WITHIN ONE (1) YEAR FROM DATE HEREON.

David F. Abell

DAVID F. ABELL
WISCONSIN REGISTERED LAND SURVEYOR, S-1596

June 20, 2003

DATE JOB NUMBER - 03075

NOTE: THIS IS NOT A CERTIFIED COPY UNLESS SEALED.

QS+T-46B
QS+T-47

001-466