


ABELL SURVEYING & MAPPING

1140 SEQUOIA STREET • DELAVAN, WISCONSIN 53115
262-728-6737

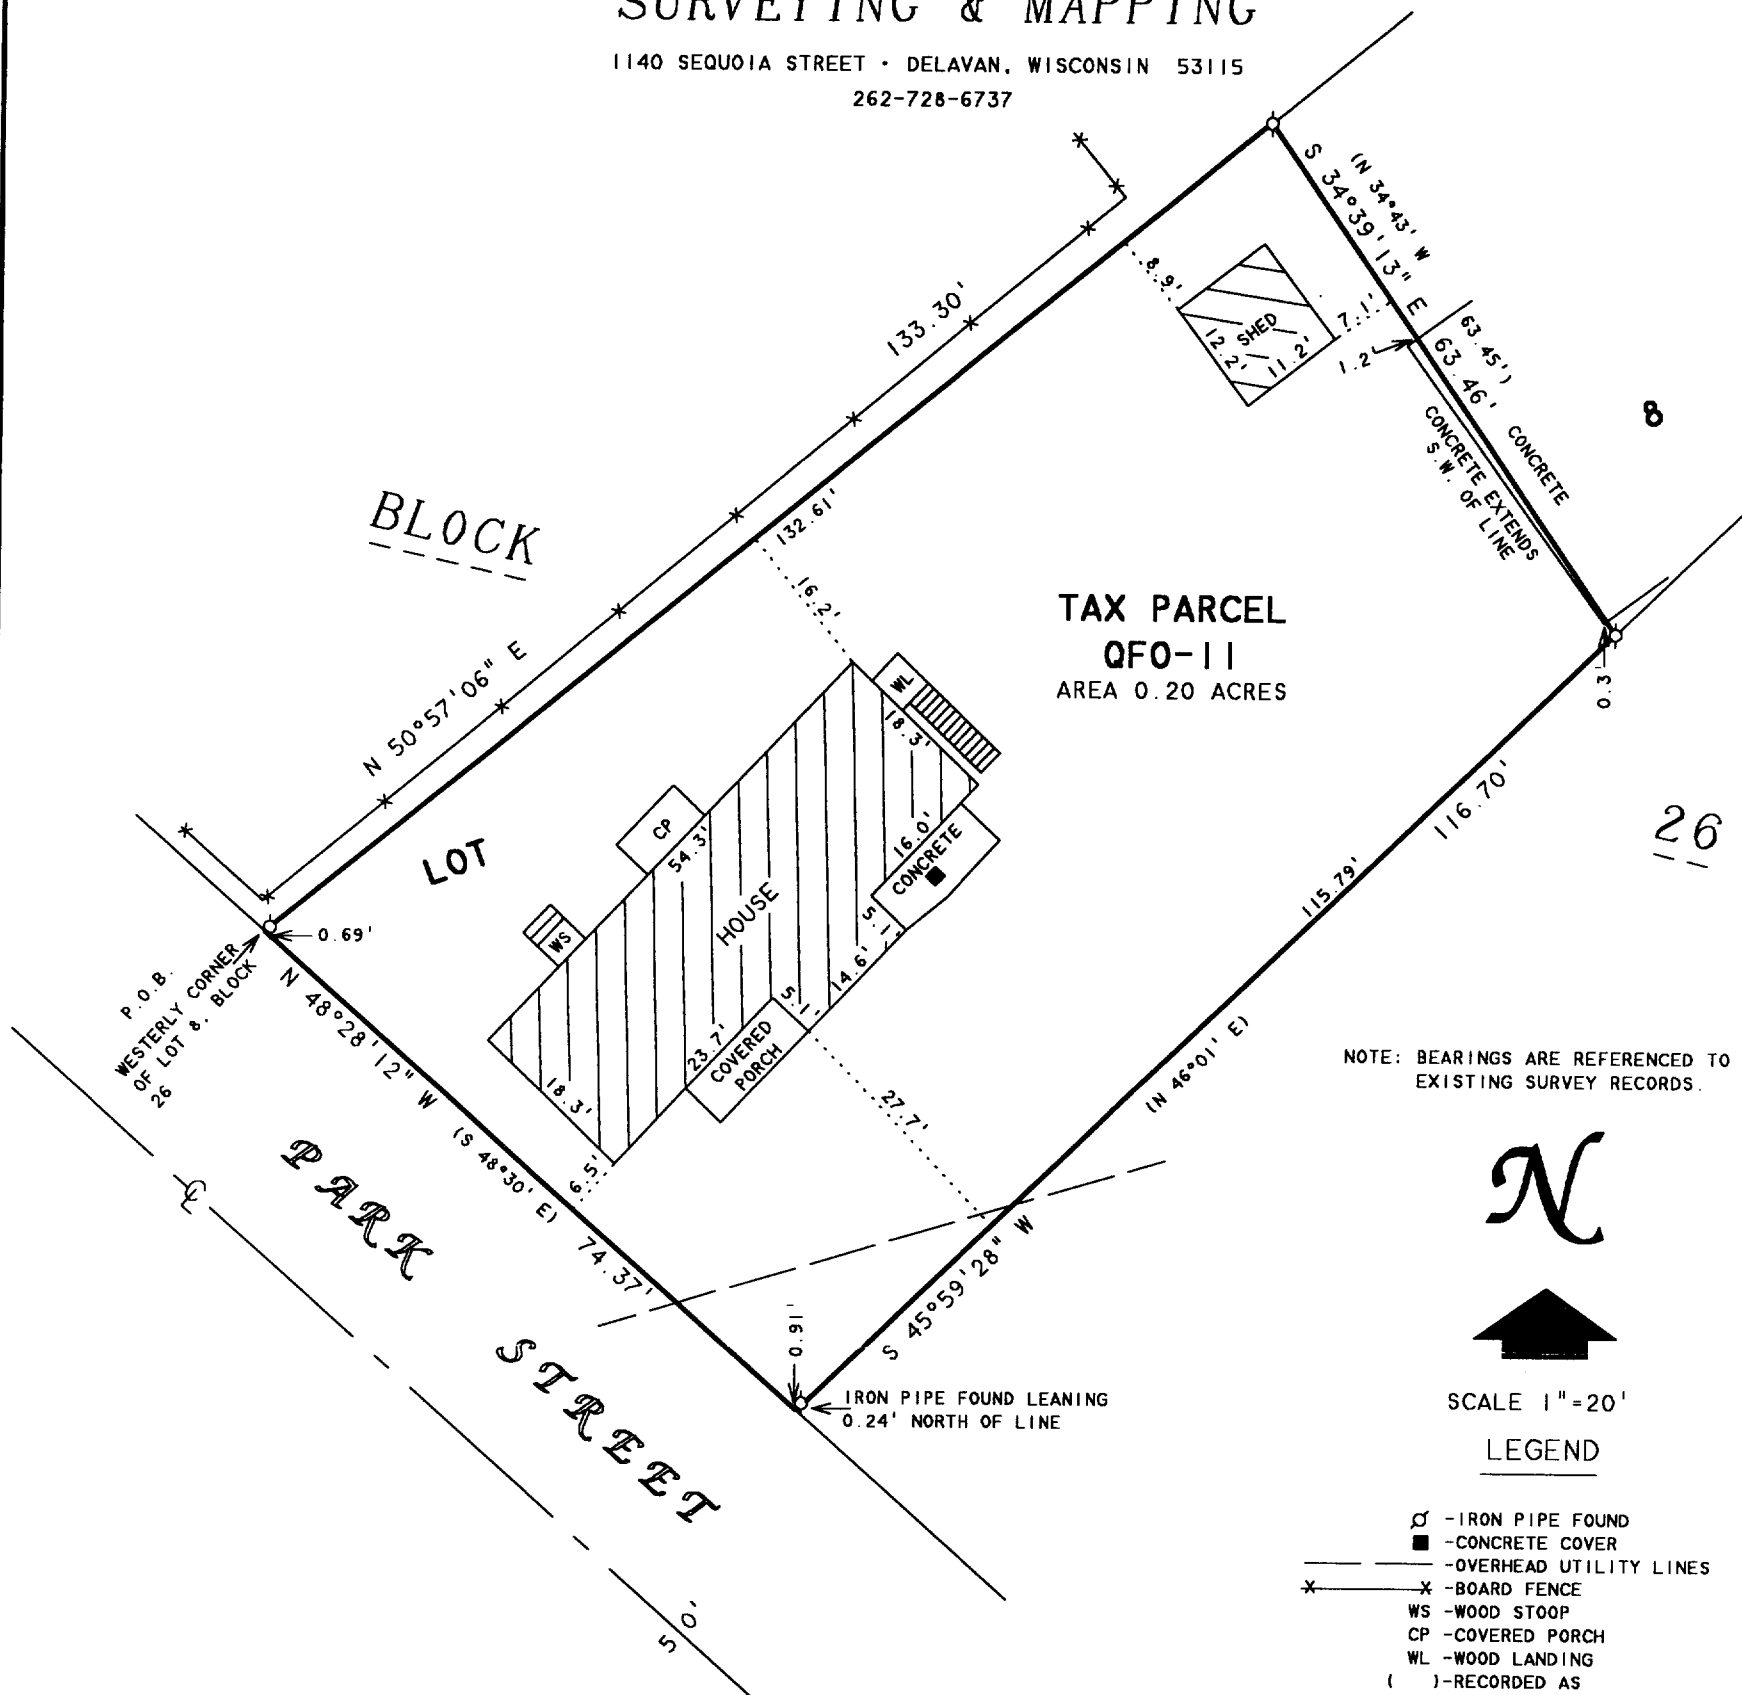

PLAT OF SURVEY OF

A PART OF LOT 8, BLOCK 26 OF THE FOURTH ADDITION TO THE VILLAGE OF DARIEN, WALWORTH COUNTY, WISCONSIN, DESCRIBED AS FOLLOWS:
BEGINNING AT THE WESTERLY OR NORTHWESTERLY CORNER OF SAID LOT 8;
THENCE S 48°30' E ALONG THE SOUTHWESTERLY LINE OF SAID LOT 8, 74.37 FEET; THENCE N 46°01' E 116.70 FEET; THENCE N 34°43' W 63.45 FEET; THENCE S 50°57'06" W 133.30 FEET TO THE PLACE OF BEGINNING.

FEB 2

DRR

ORDERED BY: RE/MAX-LAKES AREA REALTORS
1815 N. SHORE DRIVE
DELAVAN, WI. 53115

I HEREBY CERTIFY THAT I HAVE SURVEYED THE ABOVE DESCRIBED PROPERTY AND THAT THE ABOVE MAP IS A TRUE REPRESENTATION THEREOF AND SHOWS THE SIZE AND LOCATION OF THE PROPERTY, ITS EXTERIOR BOUNDARIES, THE LOCATION OF ALL VISIBLE STRUCTURES AND DIMENSIONS OF ALL PRINCIPAL BUILDINGS THEREON, BOUNDARY FENCES, APPARENT EASEMENTS, ROADWAYS AND VISIBLE ENCROACHMENTS, IF ANY, TO THE BEST OF MY KNOWLEDGE AND BELIEF.

THIS SURVEY IS MADE FOR THE USE OF THE PRESENT OWNERS OF THE PROPERTY, AND ALSO THOSE WHO PURCHASE, MORTGAGE, OR GUARANTEE THE TITLE THERETO WITHIN ONE (1) YEAR FROM DATE HEREON.

David F. Abell

DAVID F. ABELL
WISCONSIN REGISTERED LAND SURVEYOR, S-1596

August 11, 2003

DATE: August 11, 2003 JOB NUMBER - 03118
NOTE: THIS IS NOT A CERTIFIED COPY UNLESS SEALED.

QFO-11

001-479