


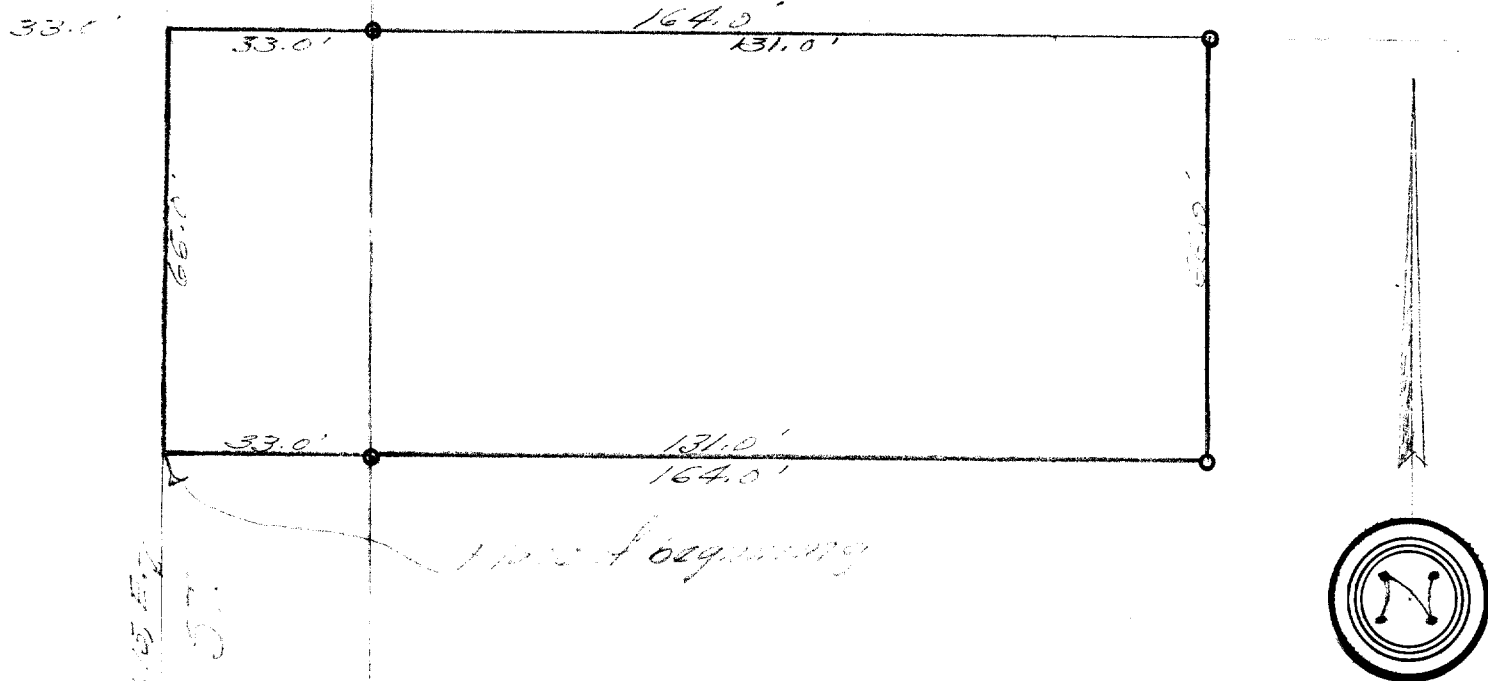

2nd of Beginning
33.0' 66.0' 131.0' 164.0'

JACKSON

DESCRIPTION: Commencing at a point in the North and South Quarter Section line of Section 27, Town 2 north, Range 15 east of the 5th Principal Meridian, (center of Wisconsin Street) that is 737.0 feet north of the center of said Section 27, thence East 134.0 feet to an iron stake, North 33.0 feet to an iron stake, thence West 134.0 feet to a point in the North and South Quarter line of said Section 27, (center of Wisconsin Street), thence South along the North and South Quarter line of said section 27, 33.0 feet to the place of beginning. Containing one quarter acre more or less.

CERTIFICATE: I, hereby certify that I have on this the 22nd day of July 1948, surveyed the above described property according to the official records on file in the office of the Recorder of Deeds in and for Walworth County, Wisconsin, and find that the measurements and bearings of the boundary line of said property as taken at the site on this day, substantially agree with those in the above description and that no encroachments exist.

Joseph M. Biagi, Professional Engineer.
Elkhorn Wisconsin.