


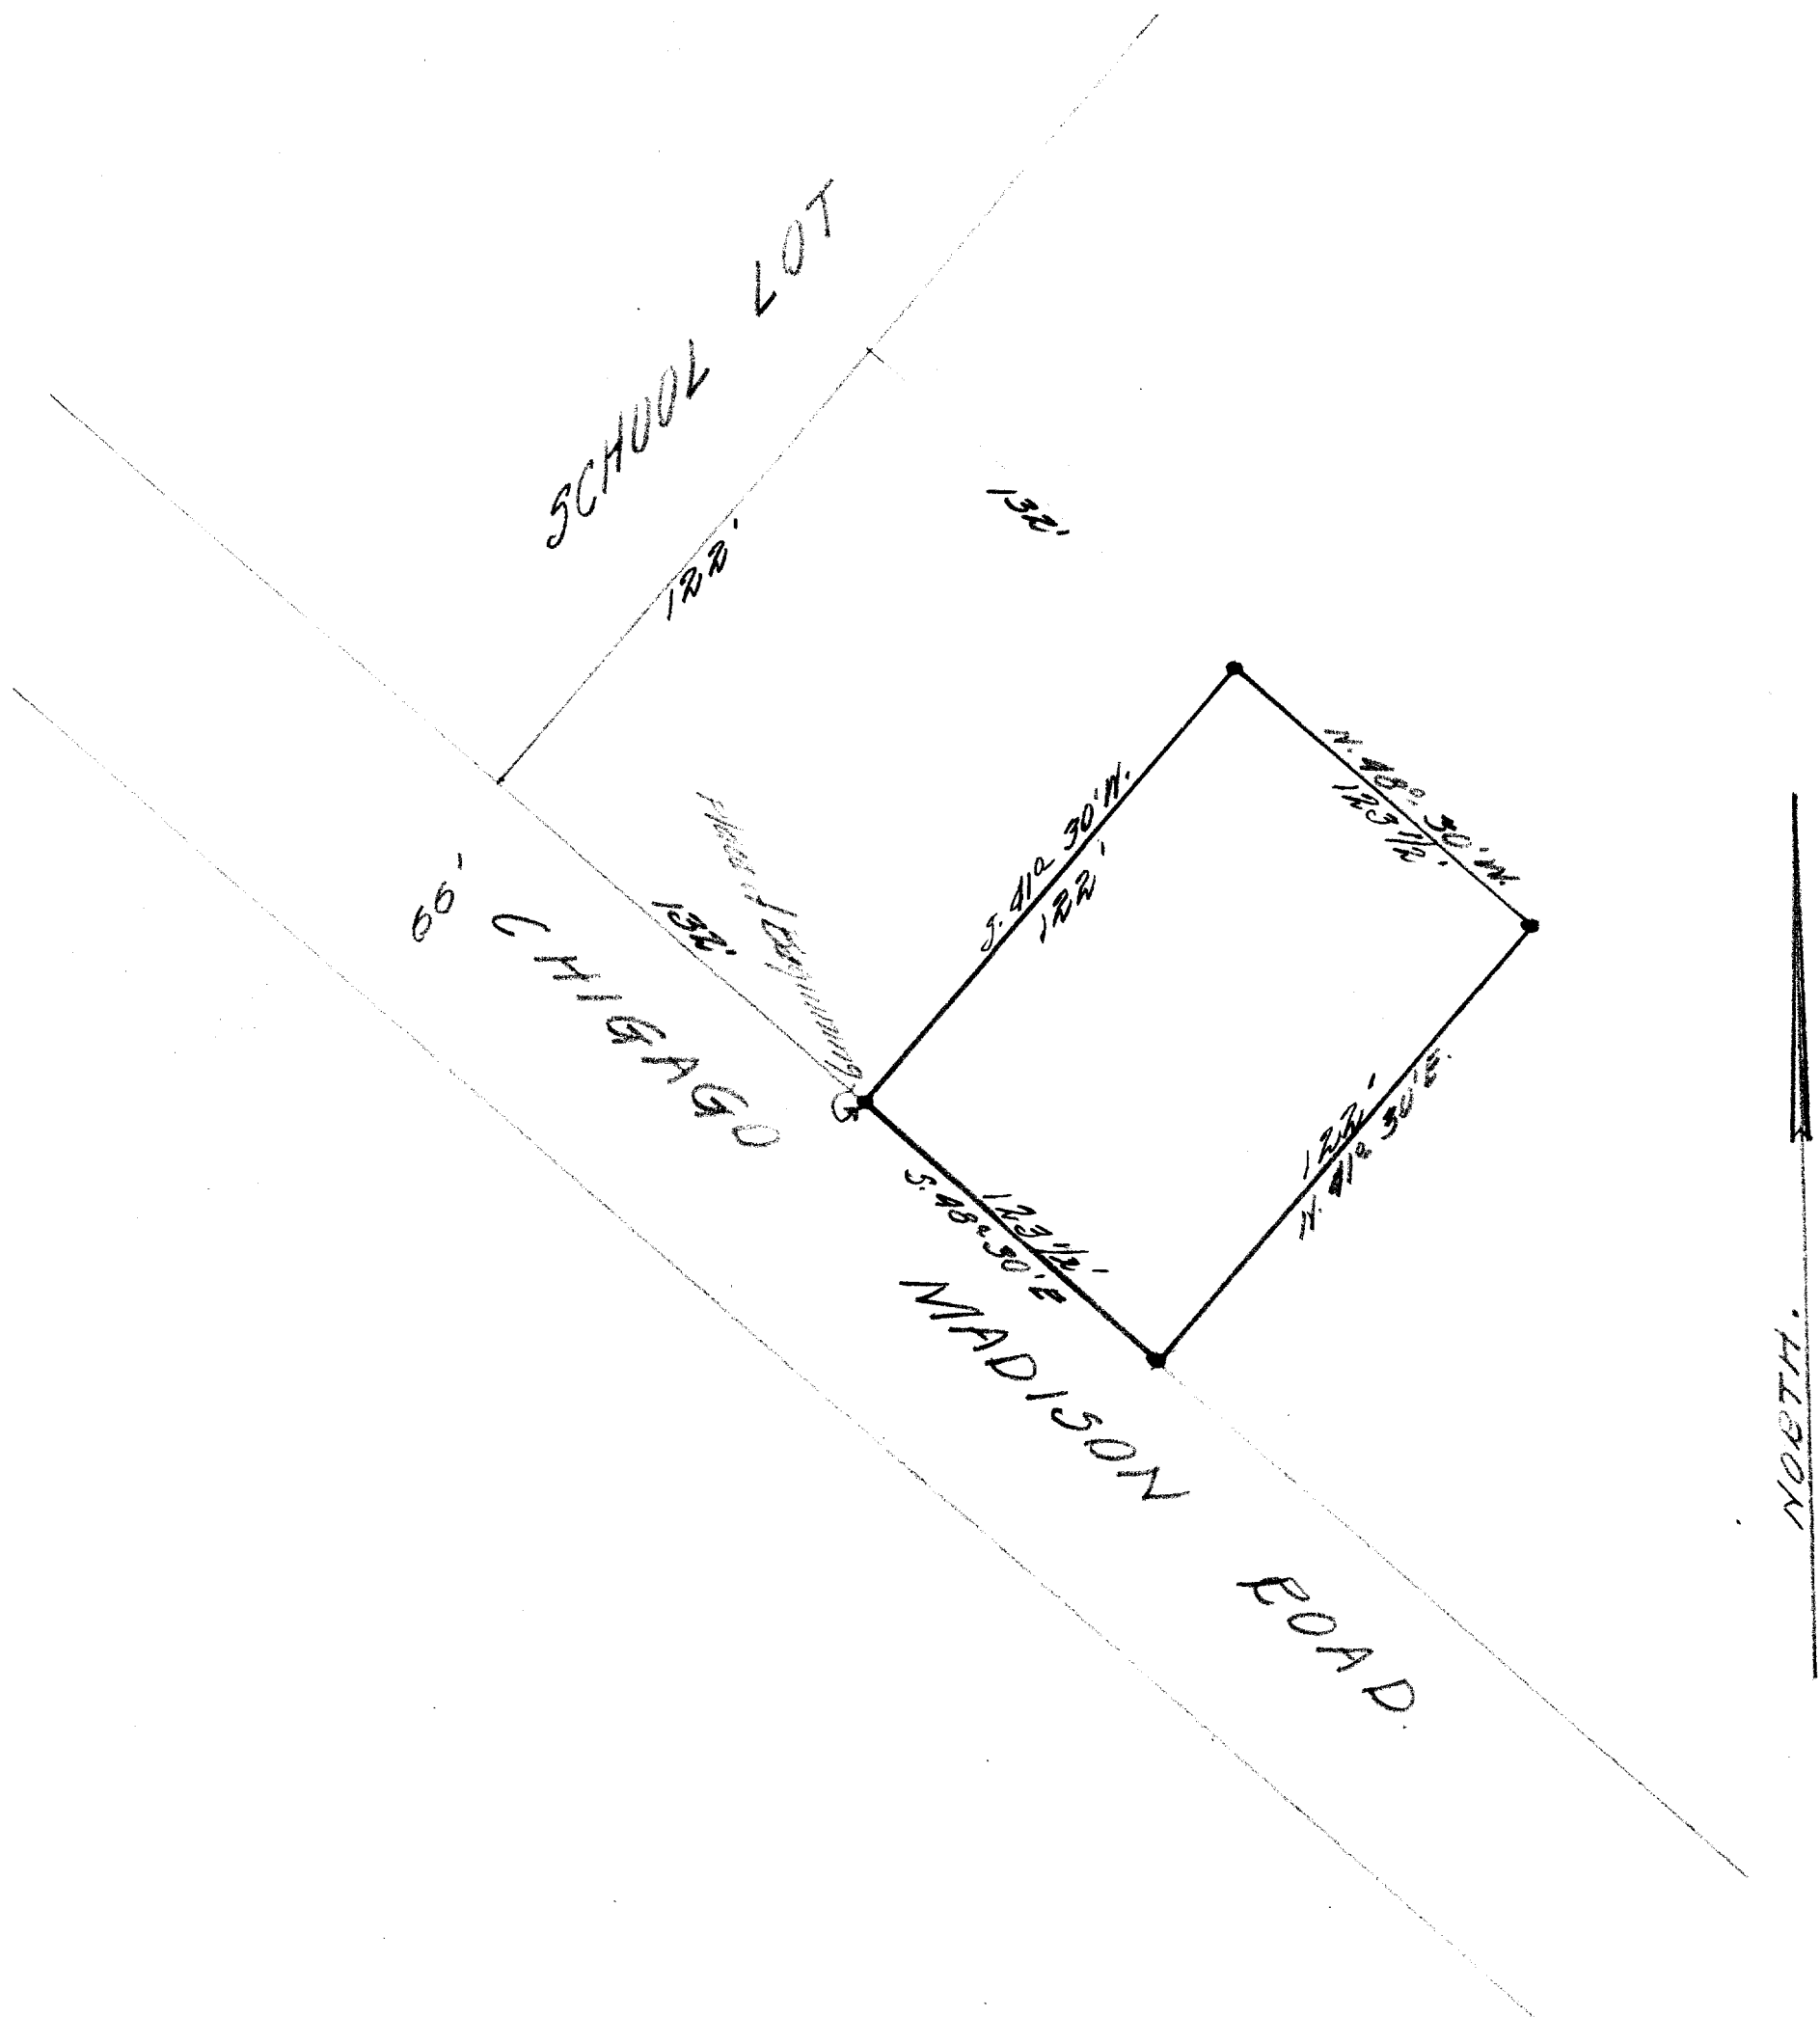

DESCRIPTION:

A, strip of land located in the S.E. $\frac{1}{4}$ of the S.W. $\frac{1}{4}$ of the S.E. $\frac{1}{4}$ of Section 27, Town 2 north, Range 15 east of the 4th P. M., described as follows to-wit; Commencing at an iron stake in the easterly line of the Chicago and Madison Road, (now known as State Trunk Highway #89), 1020.2 feet, S. 48° - 30' E., from the southwest corner of the Public Square, thence S. 48° - 30' E., along the easterly line of said highway, 123½ feet to an iron stake, thence N. 41° - 30' E., 122 feet, to an iron stake, thence N. 48° - 30' W., 123½ feet to an iron stake, thence S. 41° - 30' W., 122 feet to the place of beginning.

CERTIFICATE:

I, hereby certify that I have on this the 22nd day of May 1946, surveyed the above described property according to the official records on file in the office of the Recorder of Deeds in and for Walworth County, Wisconsin, and find that the measurements and bearings of the boundary lines of said property substantially agree with those in the above description and that no encroachments exist.

SIGNED AND SEALED THIS 23RD DAY OF MAY 1946.

Joseph M. Biagi
Joseph M. Biagi.
Professional Engineer.
Elkhorn Wisconsin.