

# Plat of Survey


of

A parcel of land described in a Land Contract recorded on June 6, 2005 as Document No. 642448, as shown below:


Parcel A: A parcel of land located in the North 10 acres of the West 1/2 of the Northeast 1/4 of Section 34, T2N, R15E, Village of Darien, Walworth County, Wisconsin, described as follows: Commencing at the Northwest corner of said Northeast 1/4; thence South 0 54' W. along the West line of said Northeast 1/4, 100.00 feet to the place of beginning; thence continue S 0 54' W. along said West line 100.00 feet; thence East 650.00 feet; thence N 0 54' E 100.00 feet; thence West 650.00 feet to the place of beginning.

Parcel B: A parcel of land located in the North 10 acres of the West 1/2 of the Northeast 1/4 of Section 34, T2N, R15E, Village of Darien, Walworth County, Wisconsin, described as follows: Beginning at the northwest corner of said Northeast 1/4; thence S 0 54' W. along the West line of said Northeast 1/4, 100.00 feet; thence East 650.00 feet; thence N 0 54' E 100.00 feet; thence West along the North line of said Northeast 1/4, 650.00 feet to the place of beginning.

Surveyed for: **Ryan Logterman**  
P.O. Box 333  
Delavan, Wisconsin, 53115

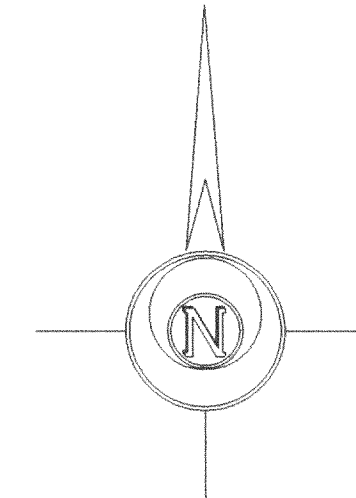

Bearings reference to the Wisconsin State Plane Coordinate System, South Zone

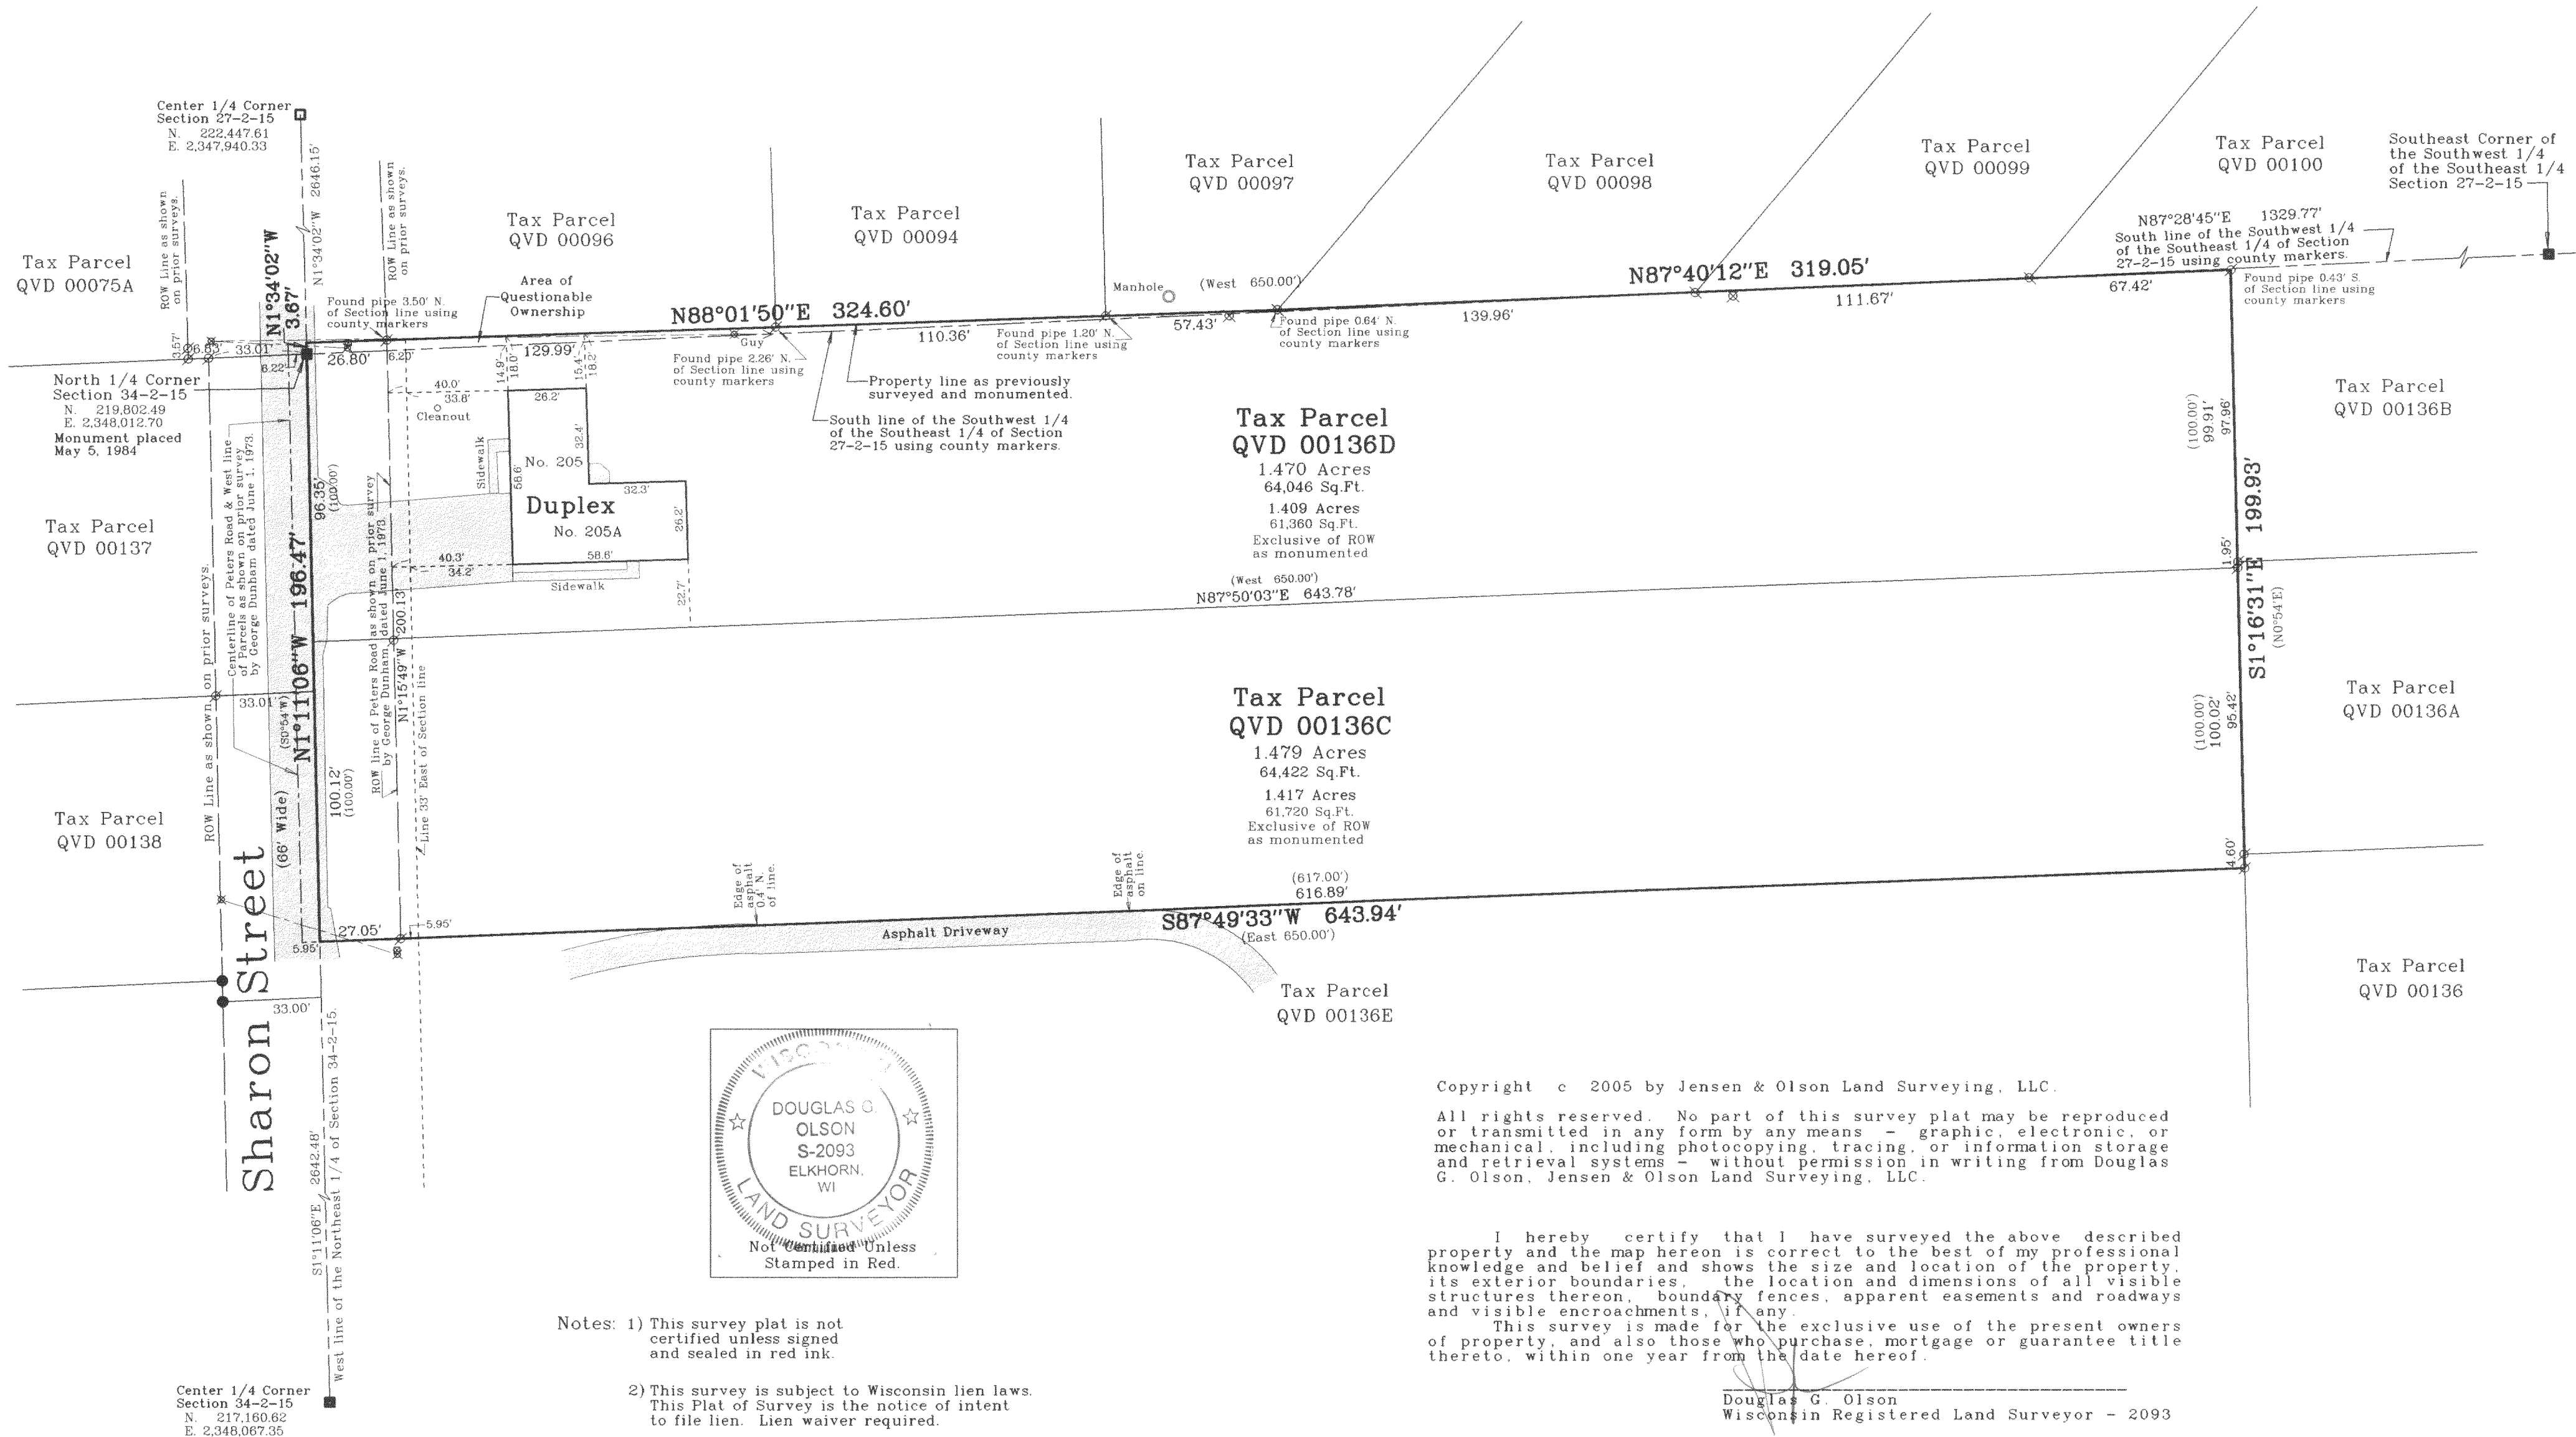

Notes: 1) This survey plat is not certified unless signed and sealed in red ink.

2) This survey is subject to Wisconsin lien laws. This Plat of Survey is the notice of intent to file lien. Lien waiver required.

Copyright c 2005 by Jensen & Olson Land Surveying, LLC.


All rights reserved. No part of this survey plat may be reproduced or transmitted in any form by any means - graphic, electronic, or mechanical, including photocopying, tracing, or information storage and retrieval systems - without permission in writing from Douglas G. Olson, Jensen & Olson Land Surveying, LLC.

I hereby certify that I have surveyed the above described property and the map hereon is correct to the best of my professional knowledge and belief and shows the size and location of the property, its exterior boundaries, the location and dimensions of all visible structures thereon, boundary fences, apparent easements and roadways and visible encroachments, if any.

This survey is made for the exclusive use of the present owners of property, and also those who purchase, mortgage or guarantee title thereto, within one year from the date hereof.

Douglas G. Olson  
Wisconsin Registered Land Surveyor - 2093

Survey Date: Sept. 21, 2005  
Revisions:

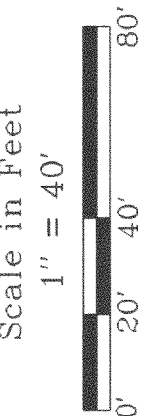

**Jensen & Olson Land Surveying, LLC**  
45 South Wisconsin Street  
Elkhorn, Wisconsin, 53121  
Telephone (262) 723-3434  
Facsimile (262) 723-8044

**Legend**  
Found County Monument  
Co. Mon. per Control Survey  
Found Iron Pipe  
Found Iron Rod  
Recorded Information  
Utility Pole  
Asphalt Surface  
Concrete

Sheet 1 of 1 Sheets  
Job Reference Number  
**2005.129**

**2005.129**

QVD-136D

QVD-136C

001-518