

STONE & TOPPING'S ADDITION

BLOCK 13

7

2

ORIGINAL PLAT VILLAGE OF DARIEN

BLOCK 1

2

3

PLAT OF SURVEY OF THE EASTERLY 66 FEET OF LOTS 1 & 7, BLOCK 1 OF THE ORIGINAL PLAT OF THE VILLAGE OF DARIEN, WALWORTH COUNTY, WISCONSIN

MONUMENT KEY

- Iron Pipe Found
W/ Dia. Shown
- (XXX.XX) Record Information



Scale: 1" = 30'

BEARINGS ASSUMED N 28°05' W ALONG THE
EASTERLY LINE OF LOTS 1 & 7 OF BLOCK 1 OF THE
ORIGINAL PLAT



OCT 27 2016

Jan

Robert H. Leuenberger

Robert H. Leuenberger, P.L.S.
Wisconsin Professional Land Surveyor S-1244


State of Wisconsin } ss
County of Rock

If the surveyor's signature is not red in color,
the plan is a copy that should be assumed to
contain unauthorized alterations.
The certification contained on this document
shall not apply to any copies.

I hereby certify that I have supervised the survey of the property described above and to the
best my knowledge and belief, the plat drawn hereon correctly represents said survey and its
location. Given under my hand and seal this 24th day of October, 2016 at Beloit, Wisconsin.
Last day of field work October 21, 2016

OAK STREET

THIRD AVENUE

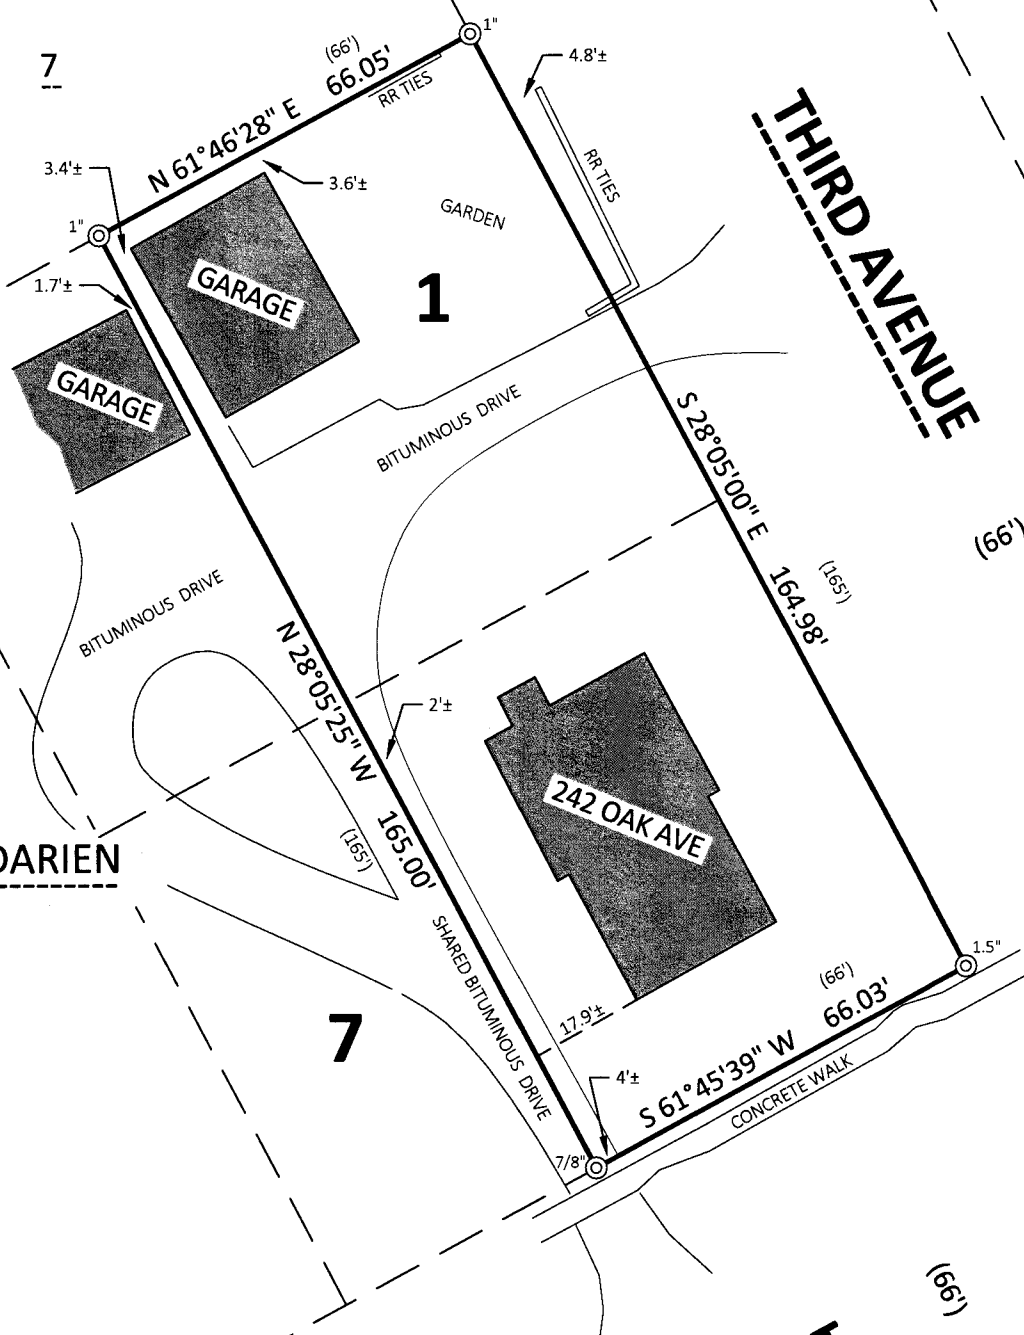

QOP-2

001-599