


PLAT OF SURVEY

LOTS 34, 35 AND 36, THE PONDS OF DARIEN, AND LOCATED IN THE SW 1/4 OF THE NE 1/4 OF SECTION 27, T.2N., R.15E. OF THE 4TH P.M., VILLAGE OF DARIEN, WALWORTH COUNTY, WISCONSIN.

STATE OF WISCONSIN
COUNTY OF ROCK SS.


I HEREBY CERTIFY THAT I HAVE SUPERVISED THE SURVEY OF THE PROPERTY DESCRIBED ABOVE FOR THE EXCLUSIVE USE OF RANDY GADDINI AND THAT TO THE BEST OF MY KNOWLEDGE AND BELIEF THE PLAT HEREON DRAWN CORRECTLY REPRESENTS SAID SURVEY AND ITS LOCATION AND COMPLIES WITH CHAPTER A-E7.

GIVEN UNDER MY HAND AND SEAL THIS 16th DAY OF MAY, 2017, AT JANESVILLE, WISCONSIN.


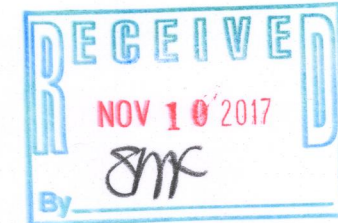


Ronald J. Combs
RONALD J. COMBS, PLS NO. 1330

If the surveyor's signature is not red in color, the map is a copy and may contain unauthorized alterations. The certification contained hereon shall not apply to any copies.

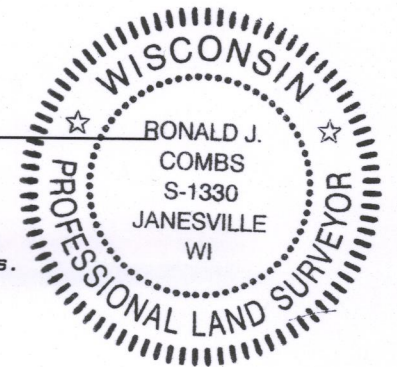

NORTH 1/4 CORNER
OF SECTION 27-2-15.

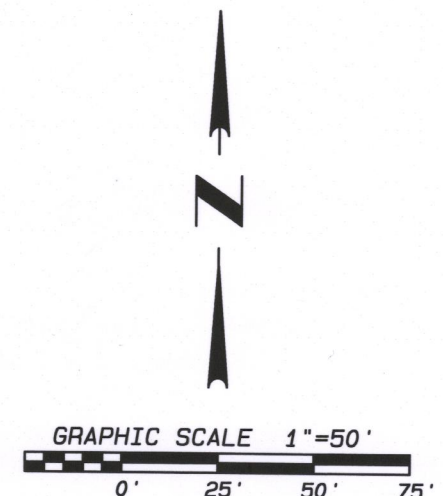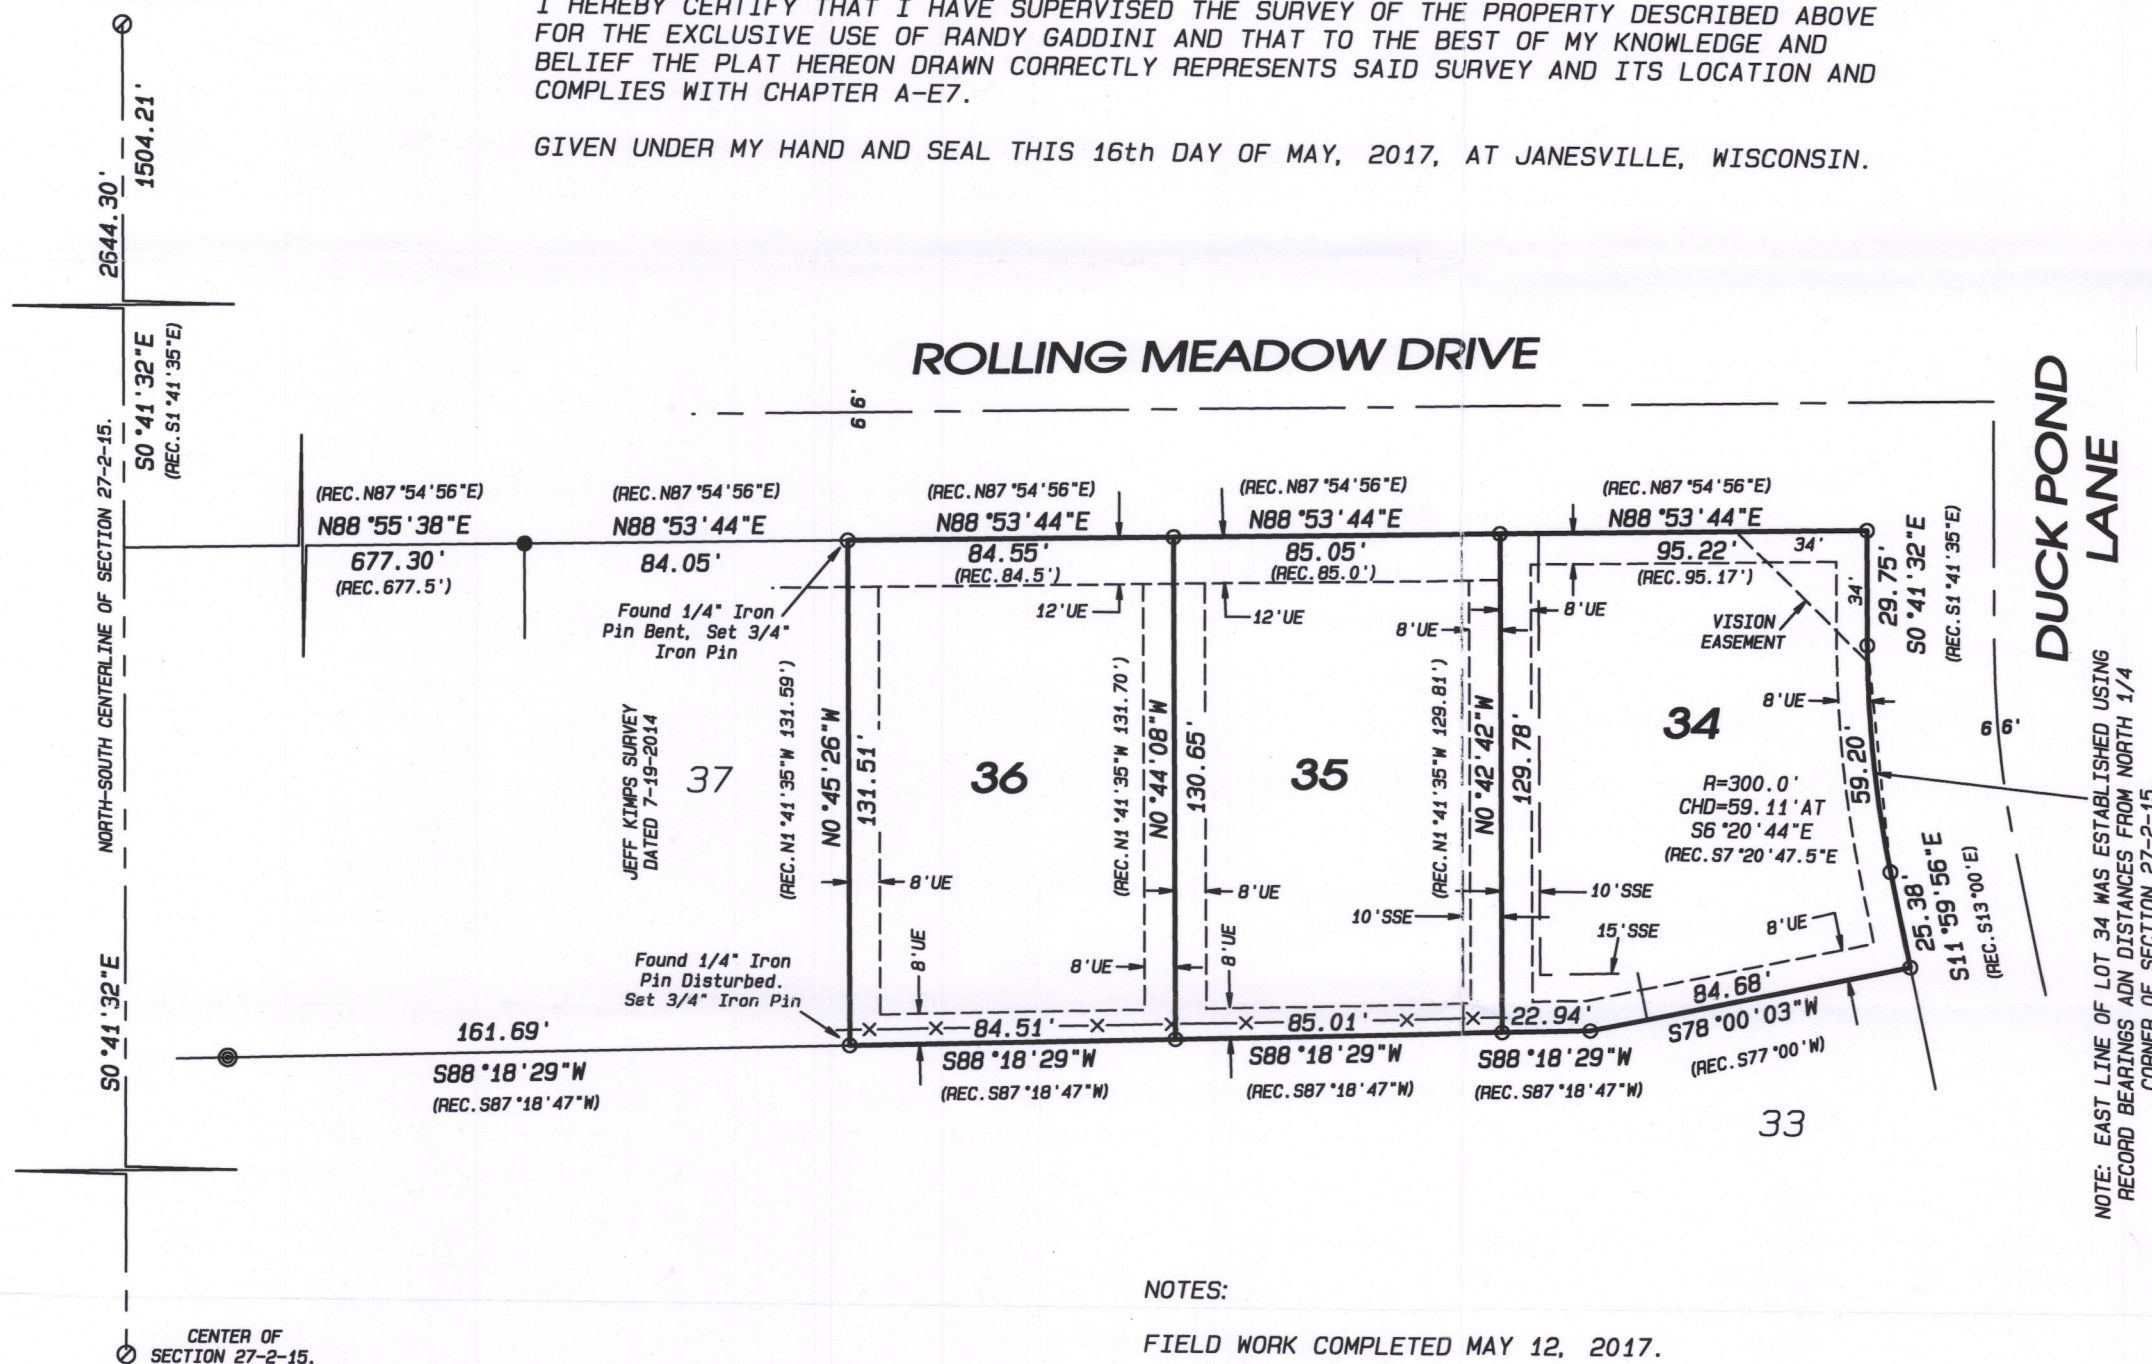

Project No. 117 - 171 For: GADDINI

Combs & Associates

- LAND SURVEYING
- LAND PLANNING
- CIVIL ENGINEERING

109 W. Milwaukee St.
Janesville, WI 53548
www.combsurvey.com

tel: 608 752-0575
fax: 608 752-0534

QPON 34 QPON 35 QPON 39

001-606