
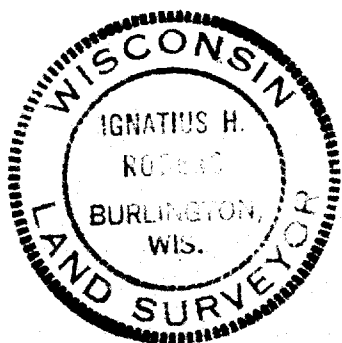


BURLINGTON, WIS. 53105

C.M. STP & P. R.R. I 2-10

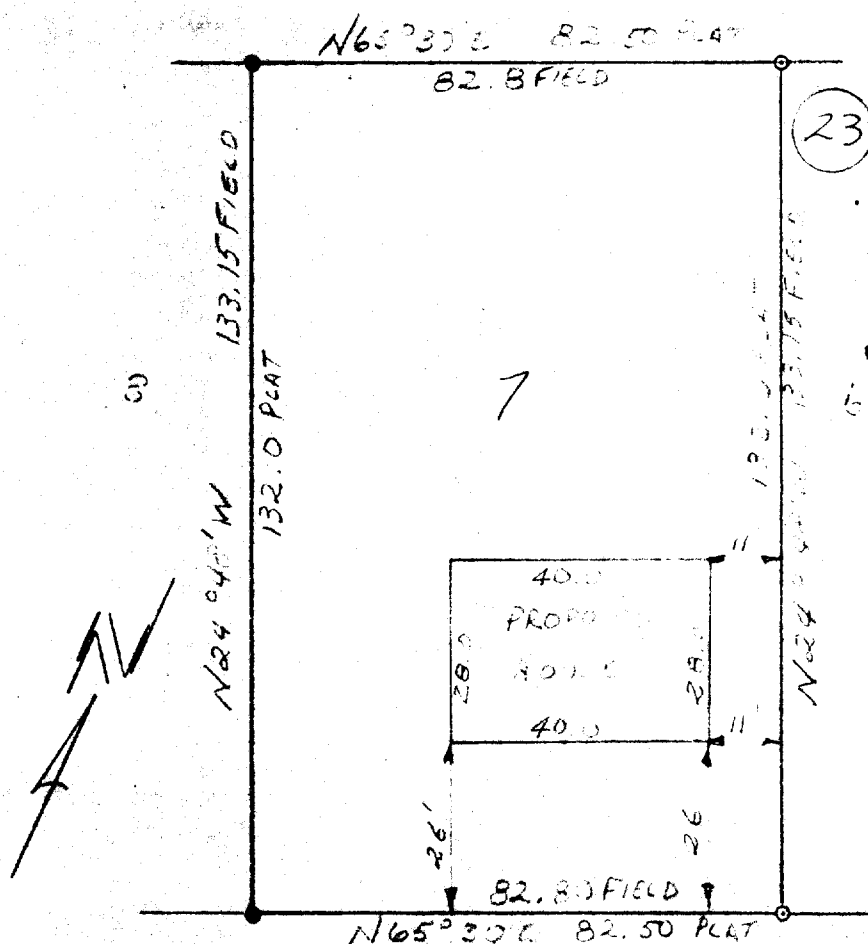

LEGEND.

SCALE 1" = 30'

0 - IRON PIPE FOUND

- - IRON PIPE SET

FREE MONT

STREET

I HEREBY CERTIFY THAT WE HAVE SURVEYED THE LANDS DESCRIBED ABOVE ACCORDING TO OFFICIAL RECORDS AND THAT THE PLAN DRAWN HEREON IS A CORRECT REPRESENTATION OF SAID SURVEY.

Wm. H. Lano Surveyor 500787

DATE 6-18-73

JOB NO. 73117