

# PLAT OF SURVEY WITH TOPOGRAPHIC DATA

NW CORNER OF NE 1/4 OF SEC. 34-2-15 "AS SHOWN BY THE CENTERLINE OF THE CONCRETE PAVEMENT" GEORGE T. DUNHAM, JUNE 1, 1973 UNRECORDED PLAT OF 6 PARCELS.

FOUND CONC. MON. W/ CAP MARKING THE NW CORNER OF NE 1/4 SEC. 34-2-15

FOUND CONC. MON. W/ CAP NE CORNER OF NE 1/4 SEC. 34-2-15

KNOWN AS: 215 SHARON STREET, DARIEN, WISCONSIN

A PARCEL OF LAND LOCATED IN THE NORTHWEST 1/4 OF THE NORTHEAST 1/4 OF SECTION 34, TOWN 2 NORTH, RANGE 15 EAST, VILLAGE OF DARIEN, WALWORTH COUNTY, WISCONSIN, DESCRIBED AS FOLLOWS:  
THE SOUTH 50 FEET OF THE WEST 83 FEET OF THE NORTH 10 ACRES OF THE NORTHWEST 1/4 OF THE NORTHEAST 1/4 OF SECTION 34 T2N, R15E.

**NOTES:**

- BEARINGS ARE BASED ON THE NORTH LINE OF THE NORTHWEST 1/4 OF SECTION 34, TOWNSHIP 2 NORTH, RANGE 15 EAST, WHICH BEARS NORTH 87°35'14" EAST.
- ELEVATIONS ARE BASED ON NAV88, STARTING BENCHMARK, CONCRETE MONUMENT WITH BRASS CAP, CENTER OF SECTION 27, ELEV: 941.99'
- FIELD DATE: FEBRUARY 12, 2025

PREPARED FOR: VILLAGE OF DARIEN  
SURVEY NO: 169598-KAC

I CERTIFY, that this survey was prepared under my supervision and is correct to the best of my professional knowledge and belief and complies with Chapter A-E 7 of the Wisconsin Administrative Code.

Date: FEBRUARY 21, 2025




*Eric R. Sturm*

ERIC R. STURM  
WISCONSIN PROFESSIONAL LAND SURVEYOR S-2309

## LEGEND

- ⊙ SANITARY MANHOLE
- ⊕ SANITARY VENT
- ⊠ ELECTRIC METER
- ⊗ WATER VALVE
- ⊕ HYDRANT
- DECIDUOUS TREE
- s - SANITARY SEWER
- sto - STORM SEWER
- w - WATERMAIN
- g - MARKED GAS MAIN
- e - MARKED ELECTRIC
- ohw - OVERHEAD WIRES
- (p) - UTILITY PER PLAN
- 780— INDICATES EXISTING CONTOUR ELEVATION
- x 780.55 INDICATES EXISTING SPOT ELEVATION

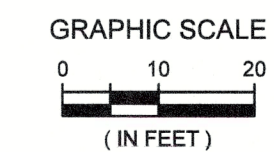


**raSmith**  
CREATIVITY BEYOND ENGINEERING

16745 W. Bluemound Road  
Brookfield, WI 53005-5938  
(262) 781-1000  
rasmith.com

S:\5163598\dwg\PS100-DARIEN LIFT.dwg, DARIEN LIFT STATION C, 2/25/2025 10:36:32 AM, ETS

DIGGERS HOTLINE

SHARON ST.

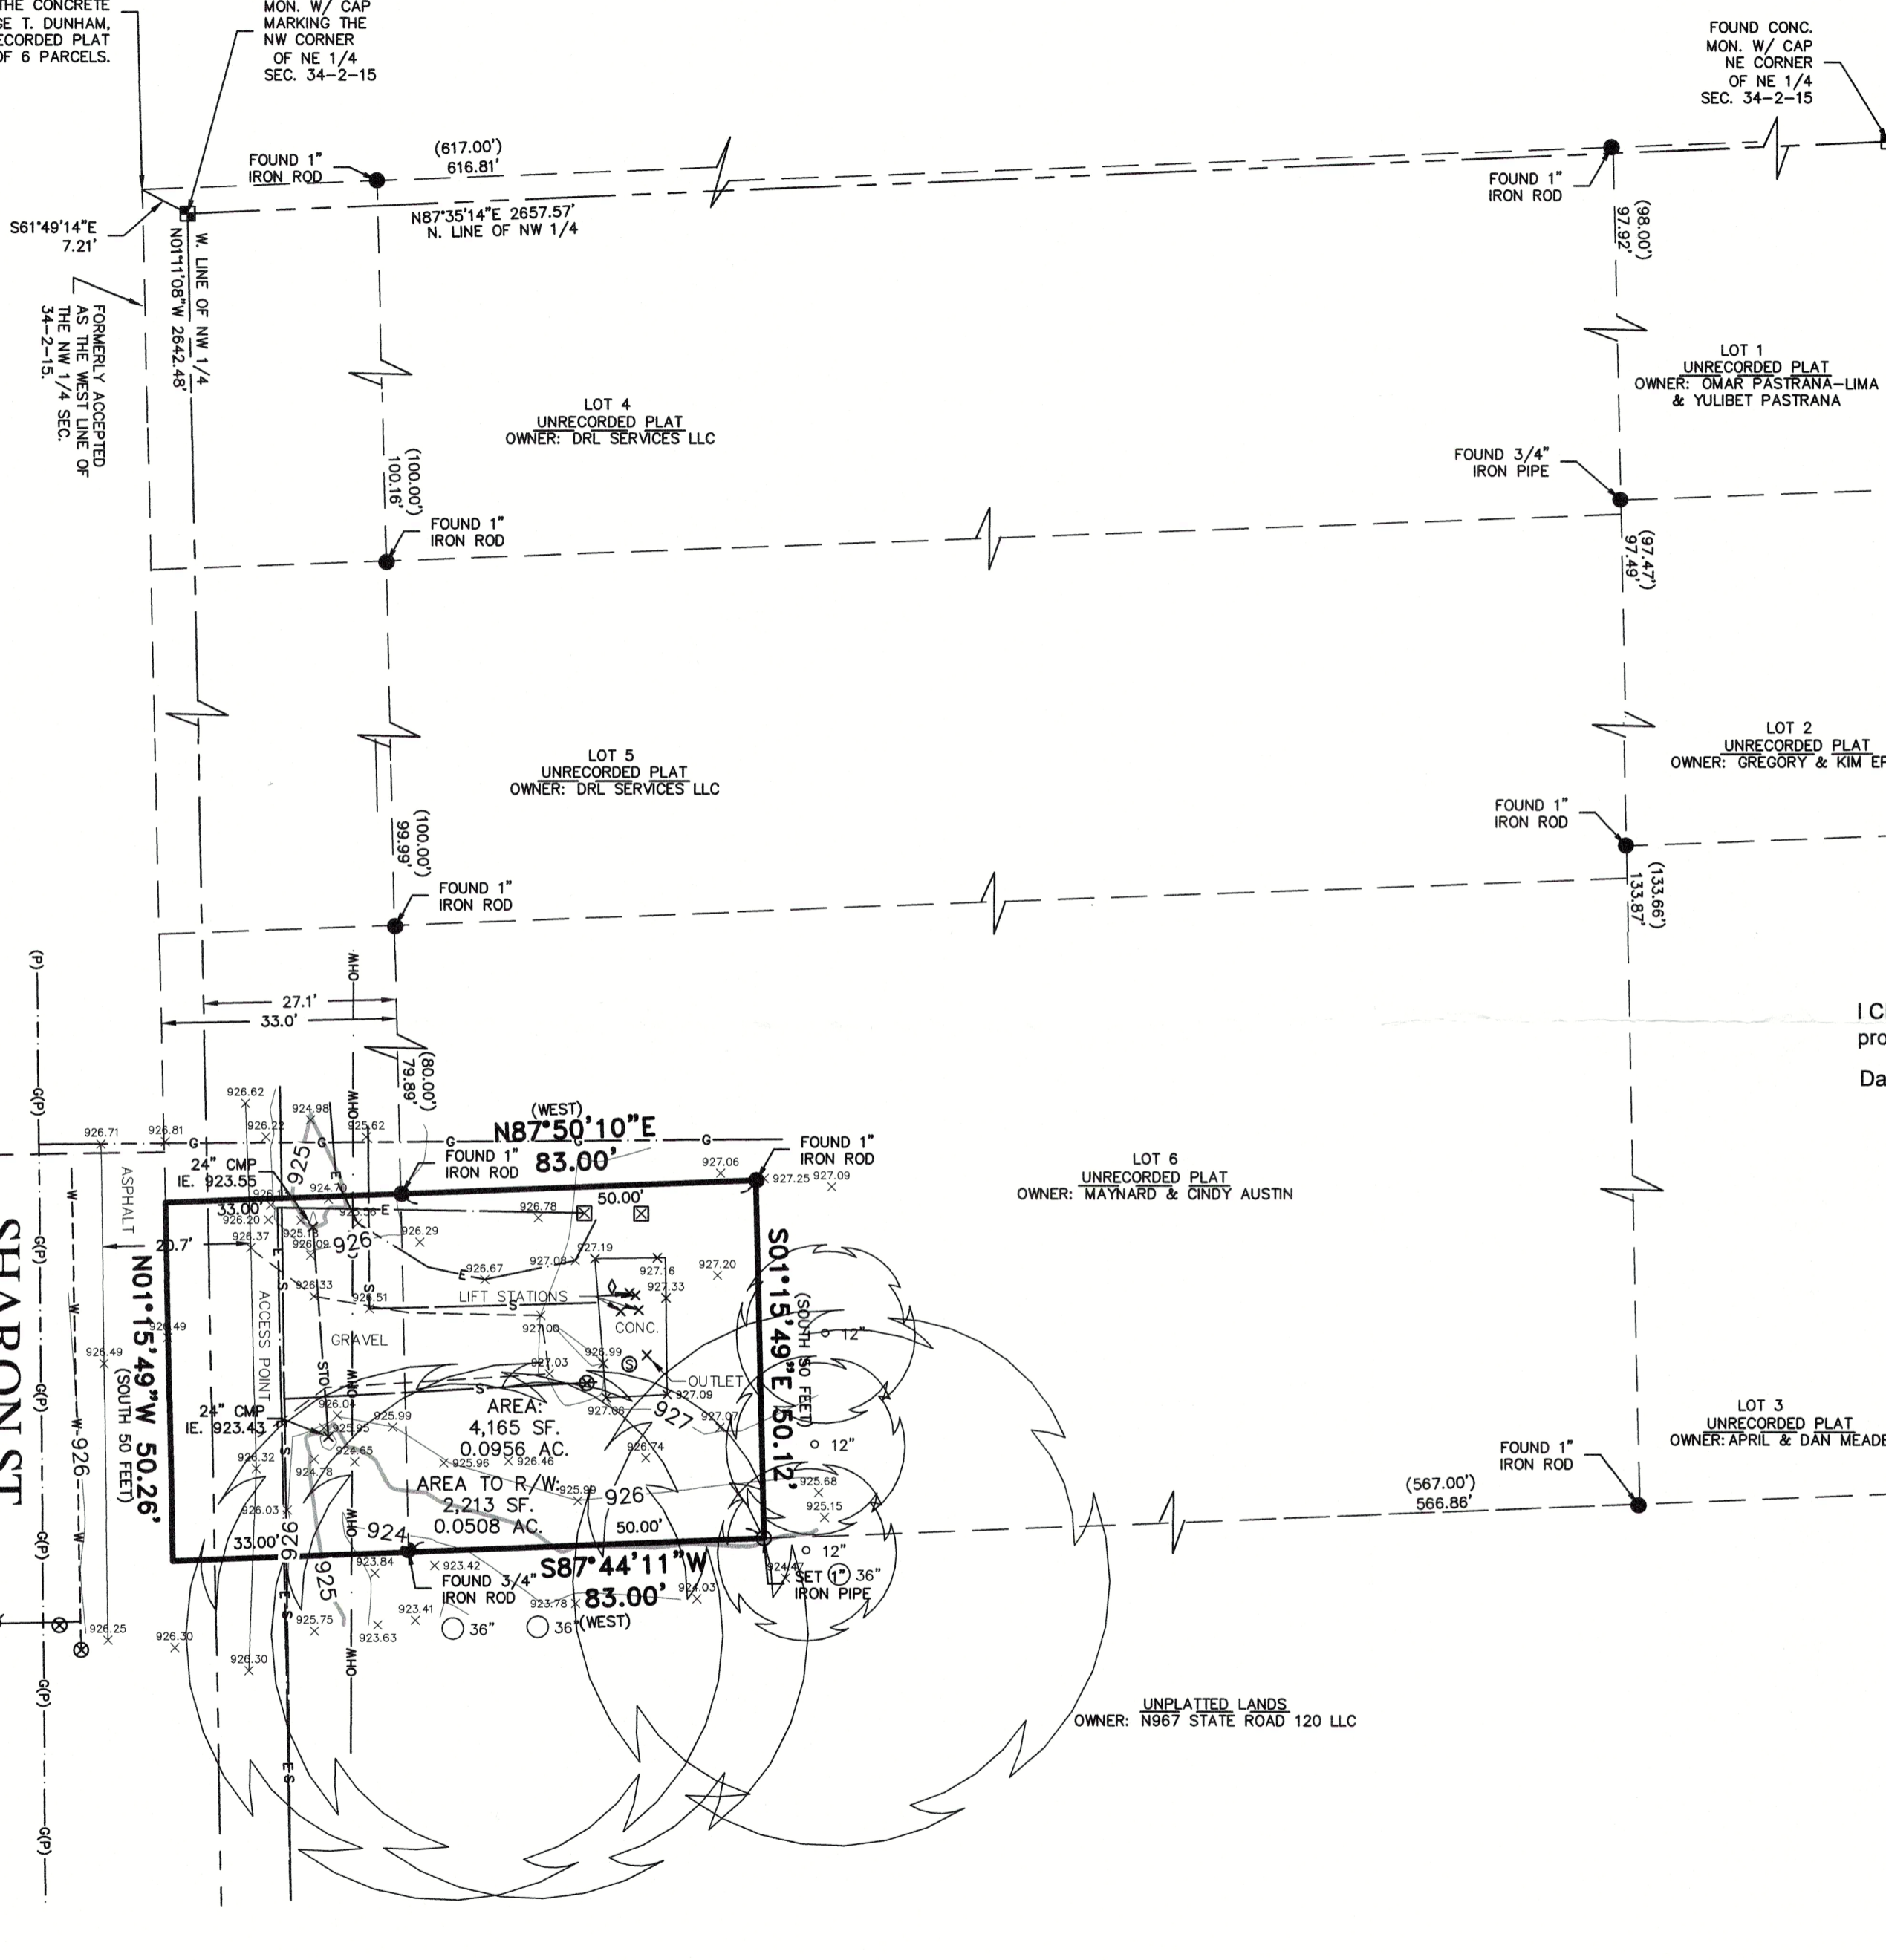

ASPHALT

SHARON ST.

SHARON ST.

