


GEORGE T. DUNHAM
SURVEYING & ENGINEERING
DELAVER, WISCONSIN

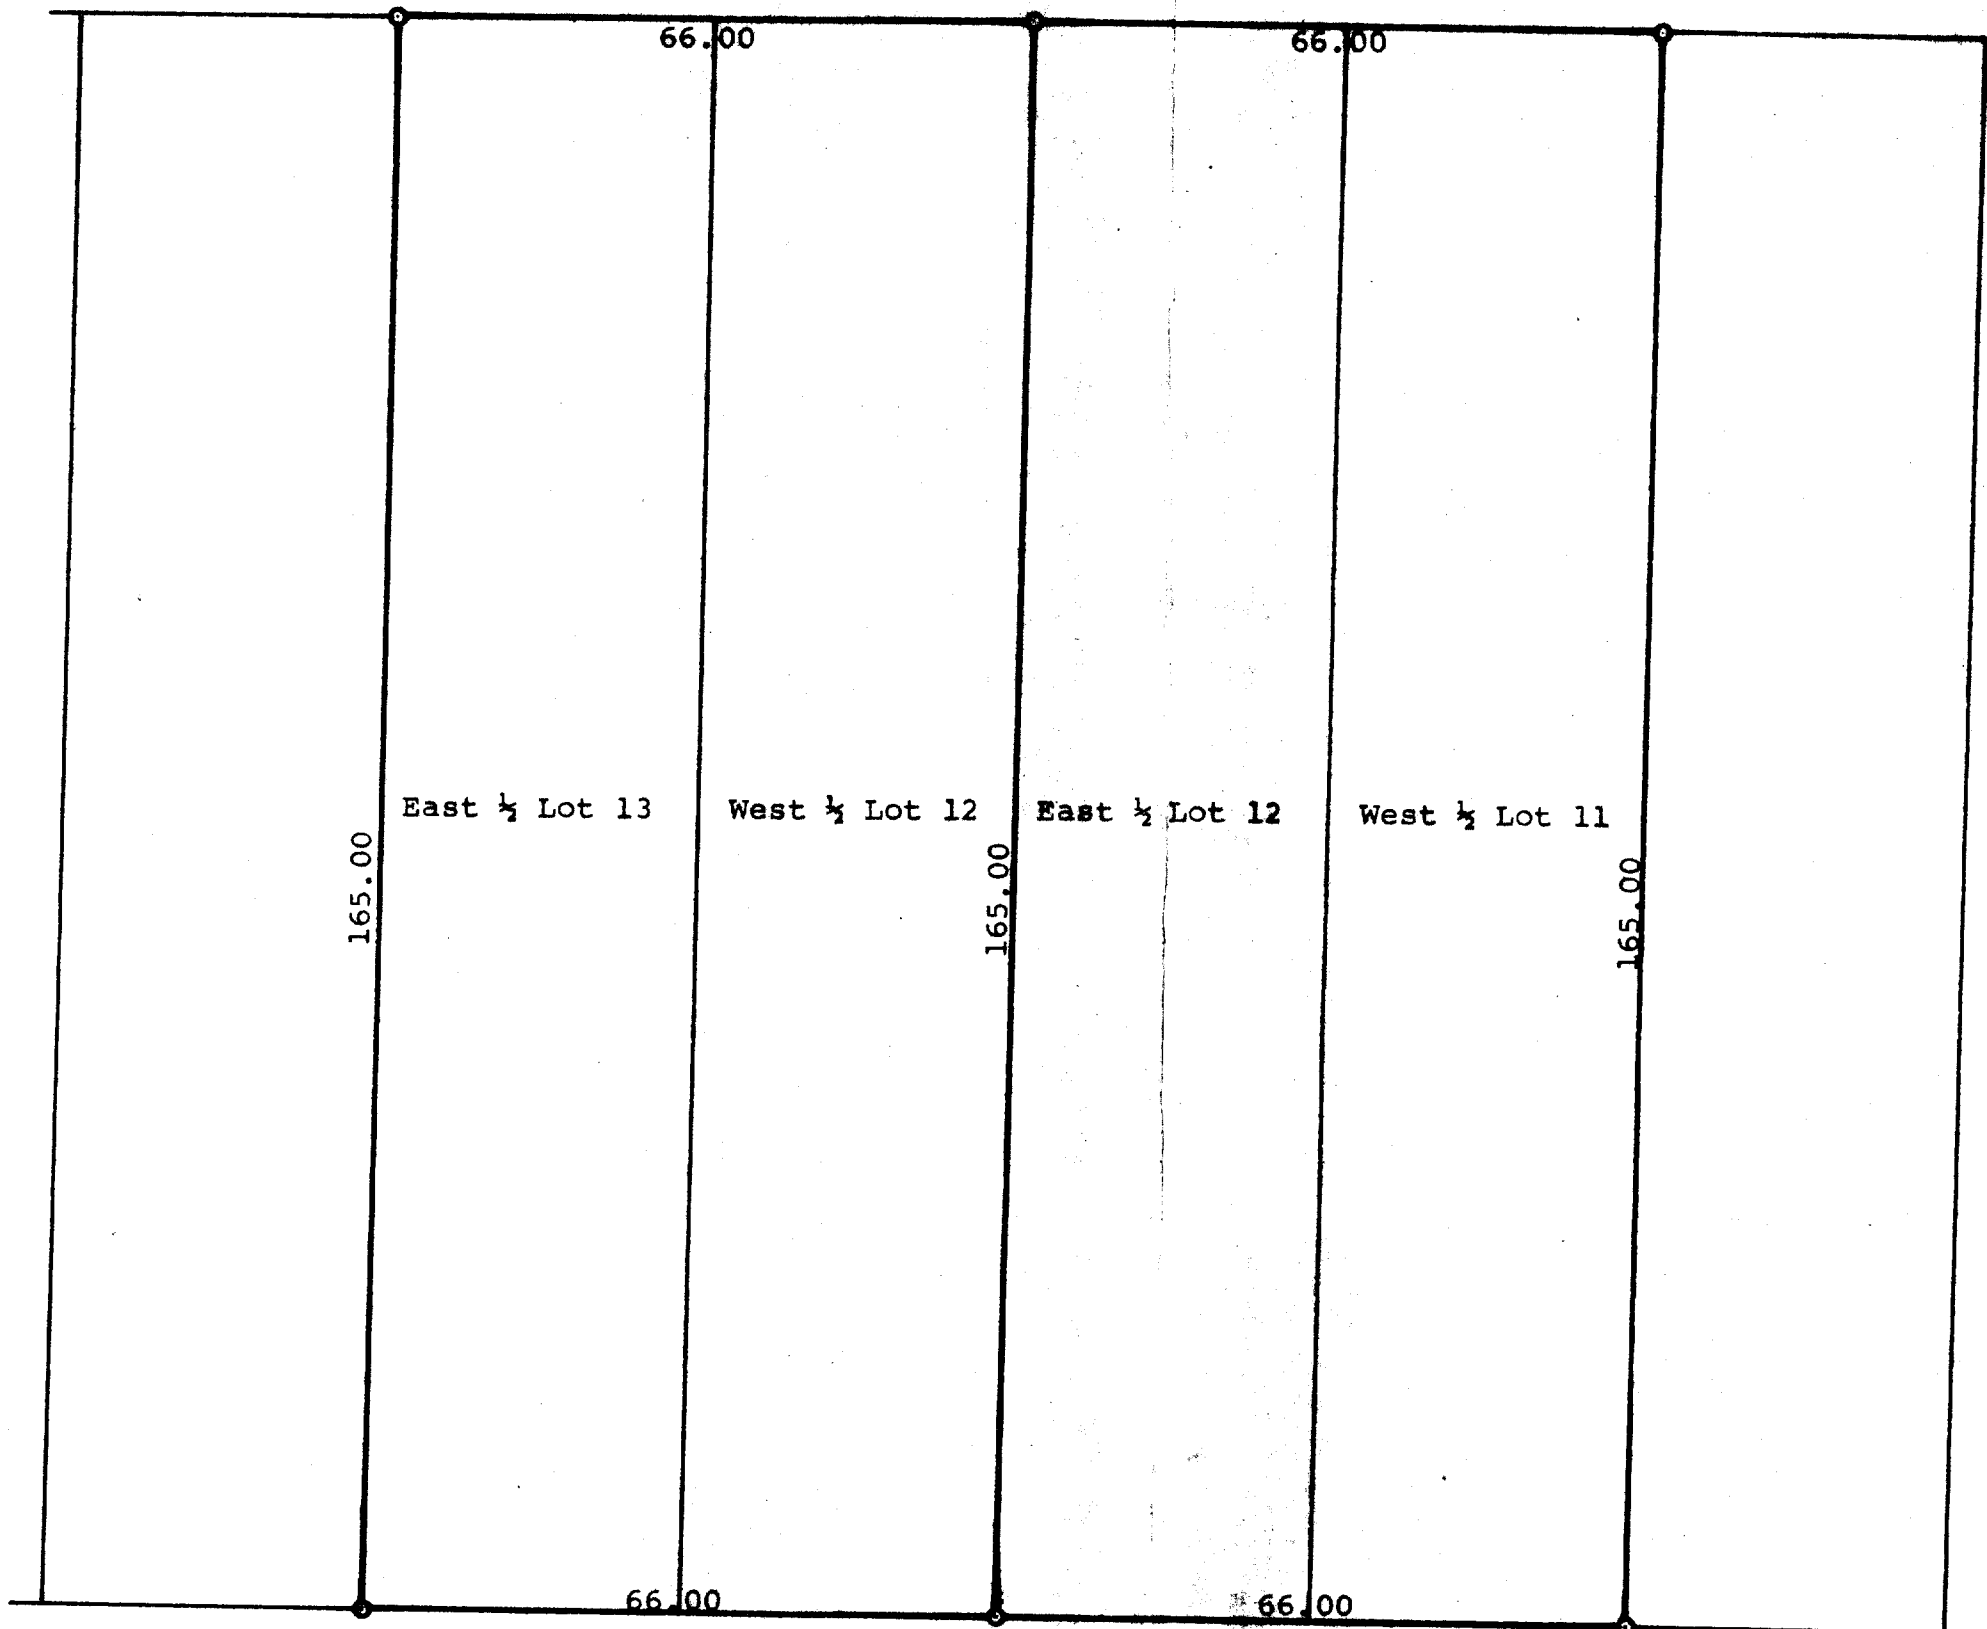

Scale - 1" = 20'
O = Iron Pipe

JEFFERSON

STREET

STATE OF WISCONSIN) SS
COUNTY OF WALWORTH)

I, George T. Dunham, Surveyor, certify that I have surveyed the property described as follows:

The West 1/2 of Lot 12 and the East 1/2 of Lot 13, Block 16 of Stone & Tappan's Addition to the Village of Darien, Walworth County, Wisconsin,

and that the above plat is an accurate survey and a true representation thereof and correctly shows the exterior boundary lines and that there are no buildings on said lots at this time,
March 13, 1974

George T. Dunham
George T. Dunham, Surveyor

