


WEST LINE OF THE EAST  $\frac{1}{2}$  OF THE SOUTH-  
WEST  $\frac{1}{4}$  OF SECTION 27, T2N R15E

MILWAUKEE - BELOIT  
ROAD

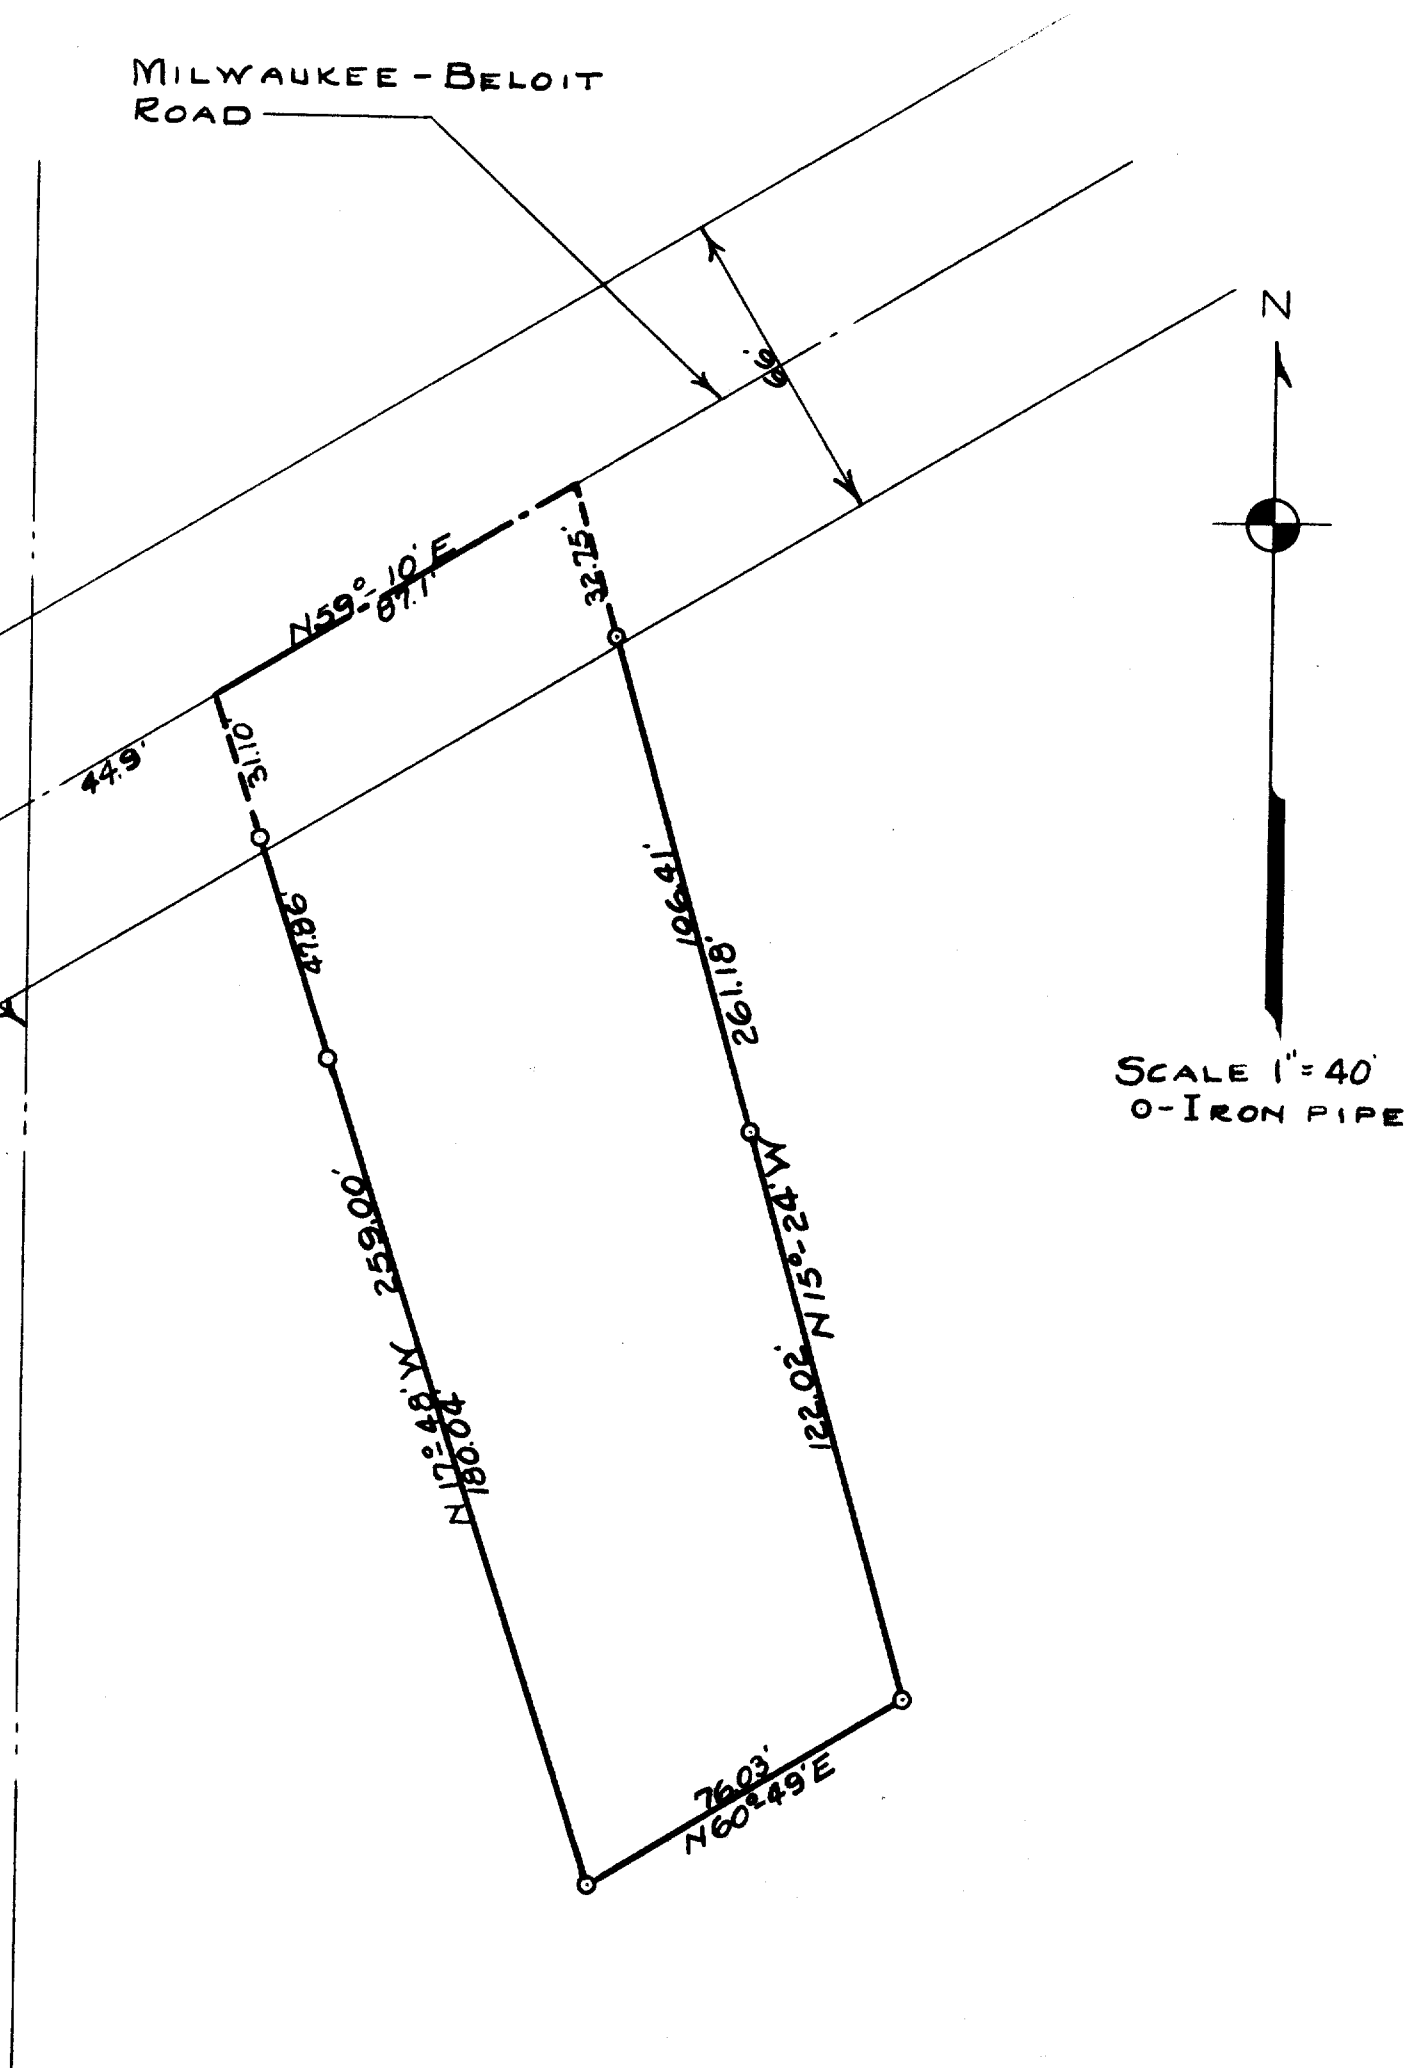

I HEREBY CERTIFY THAT THE ABOVE MAP IS A CORRECT  
REPRESENTATION OF A SURVEY OF THE LAND  
REMAINING IN THE PETER EASTERLING ESTATE  
IN SECTION 27, T2N R15E WALWORTH COUNTY  
WISCONSIN.  
JULY 1946

*Lloyd D. Jensen*  
COUNTY SURVEYOR 1-6 B