




SCALE-1"=40'  
O=IRON PIPE

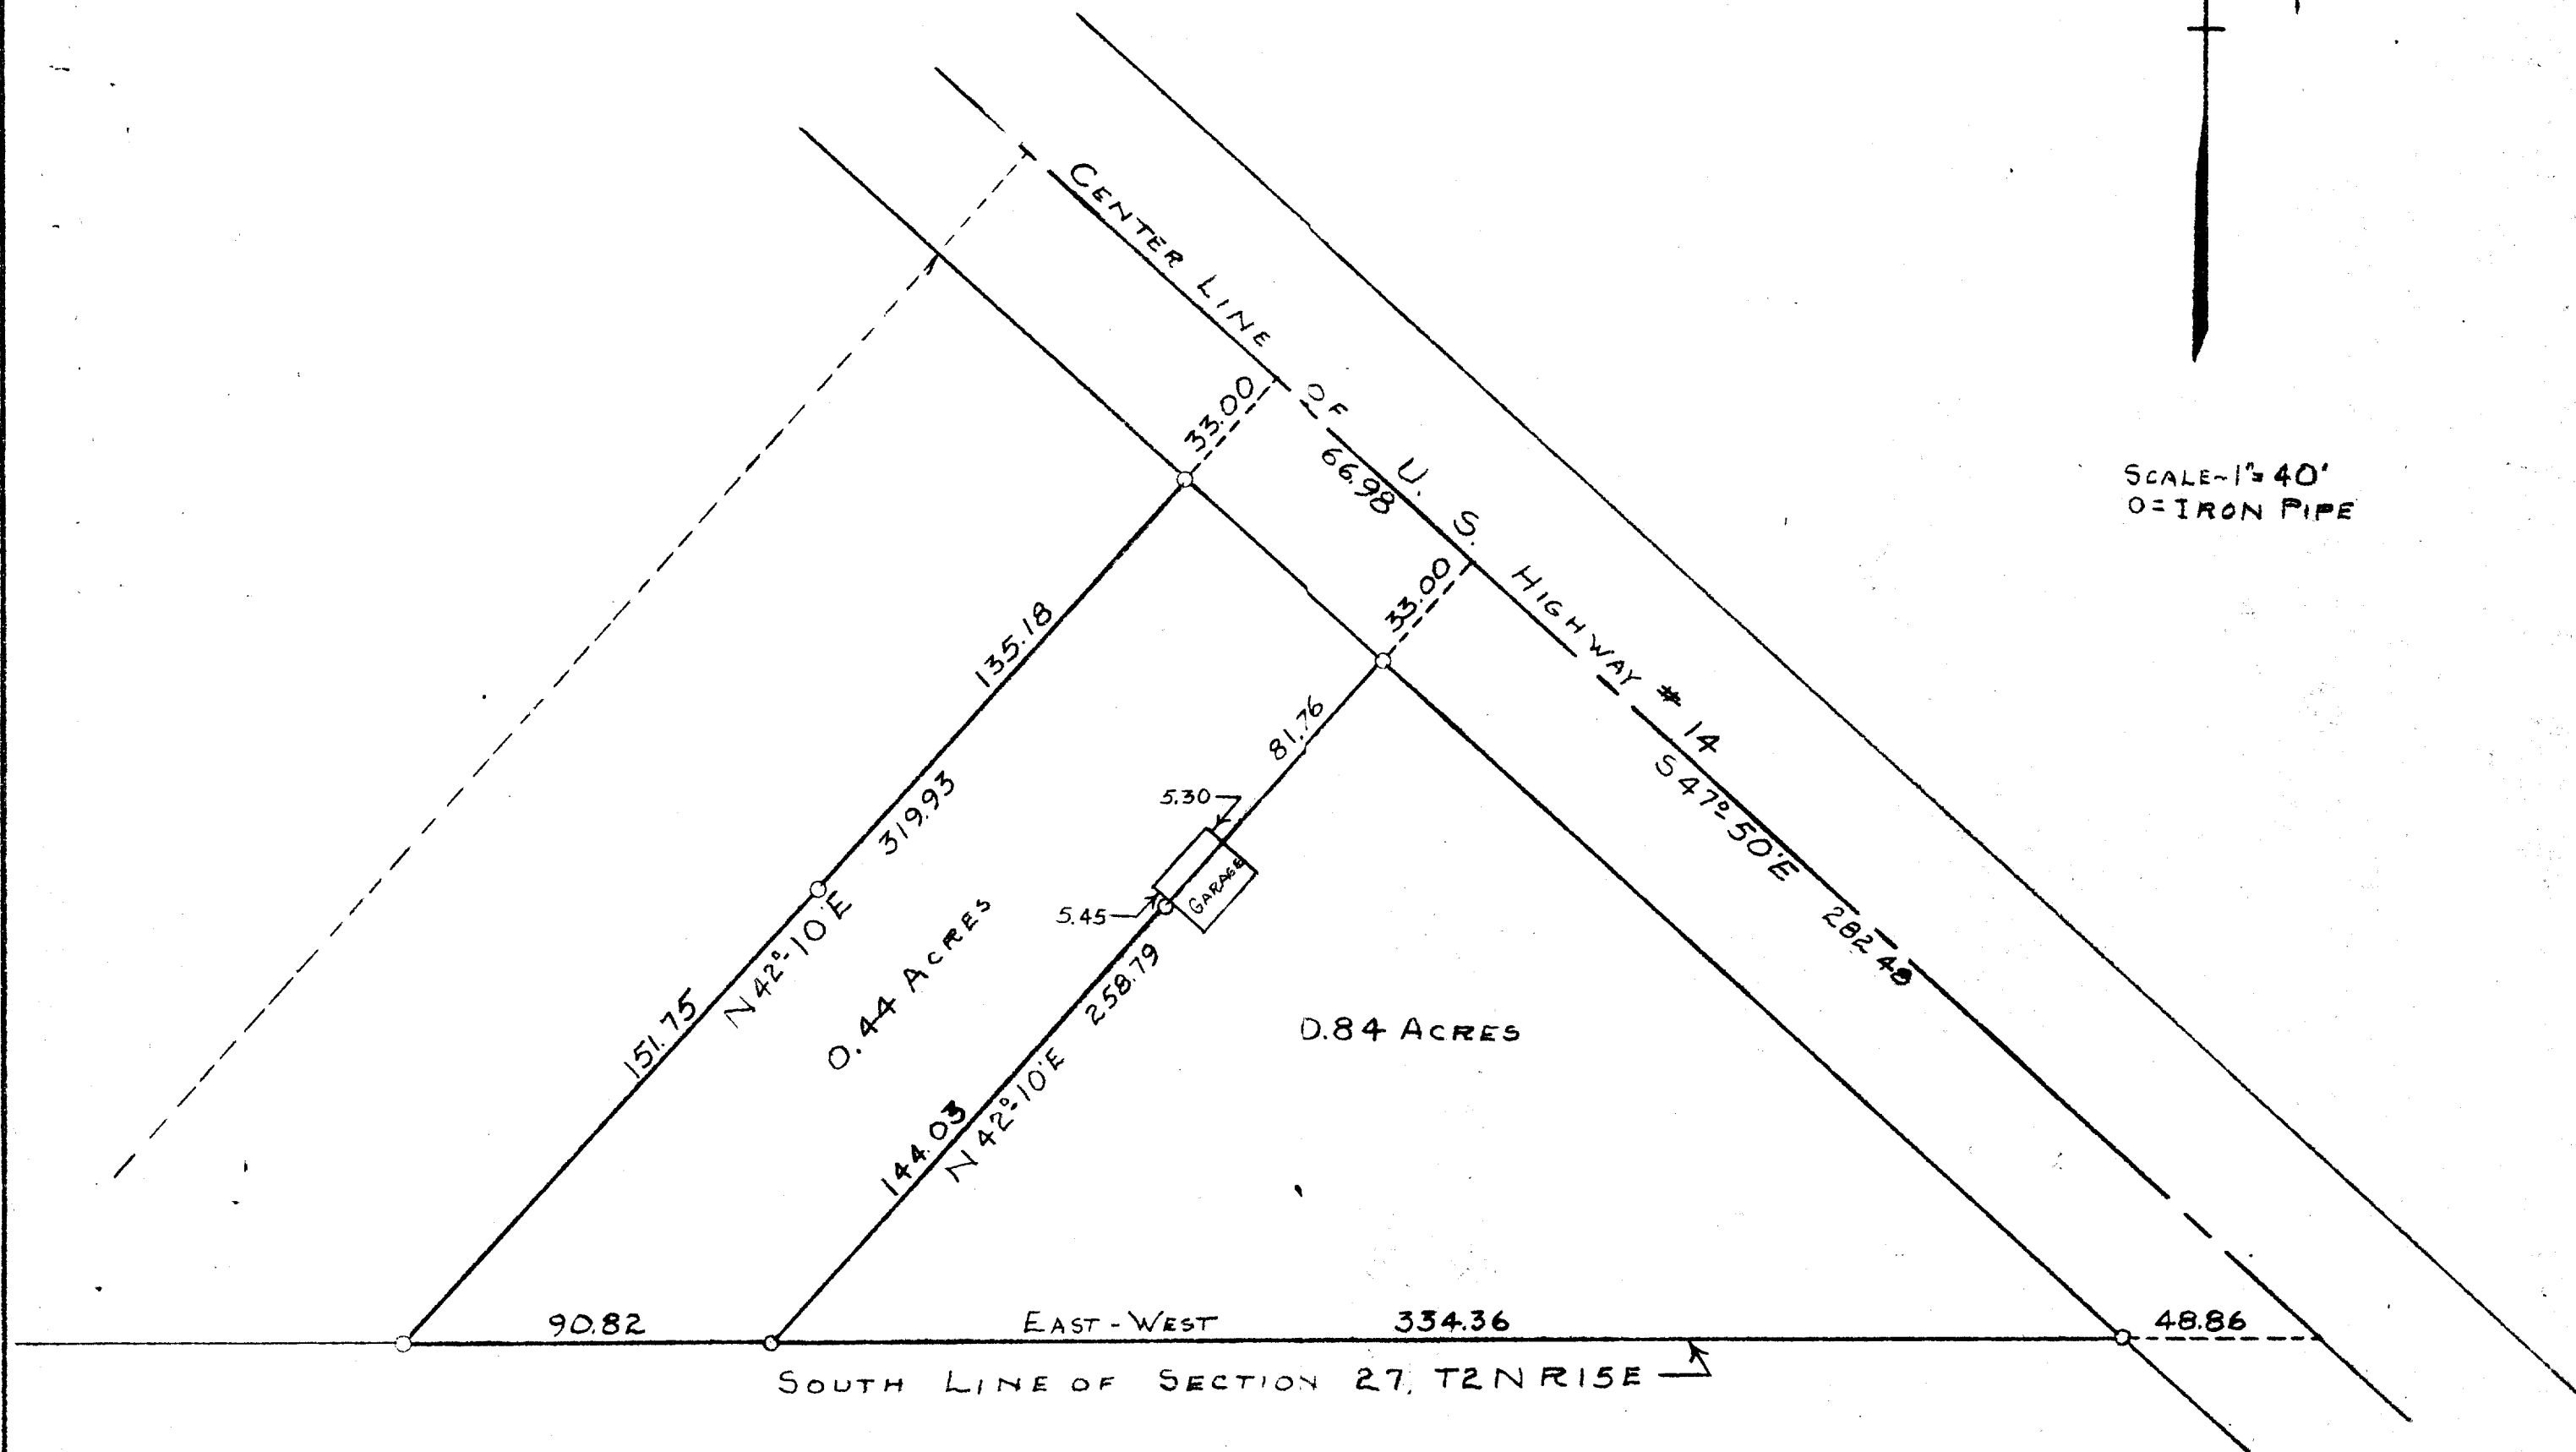

PLAT OF SURVEY OF PARCELS OF LAND LOCATED IN THE  
SOUTHEAST 1/4 OF SECTION 27, T2N R15E WALWORTH  
COUNTY, WISCONSIN  
NOVEMBER 1952

*George T. Dunham*  
SURVEYOR

1-7