


GEORGE T. DUNHAM
SURVEYING & SUBDIVIDING
DELAVAN, WISCONSIN

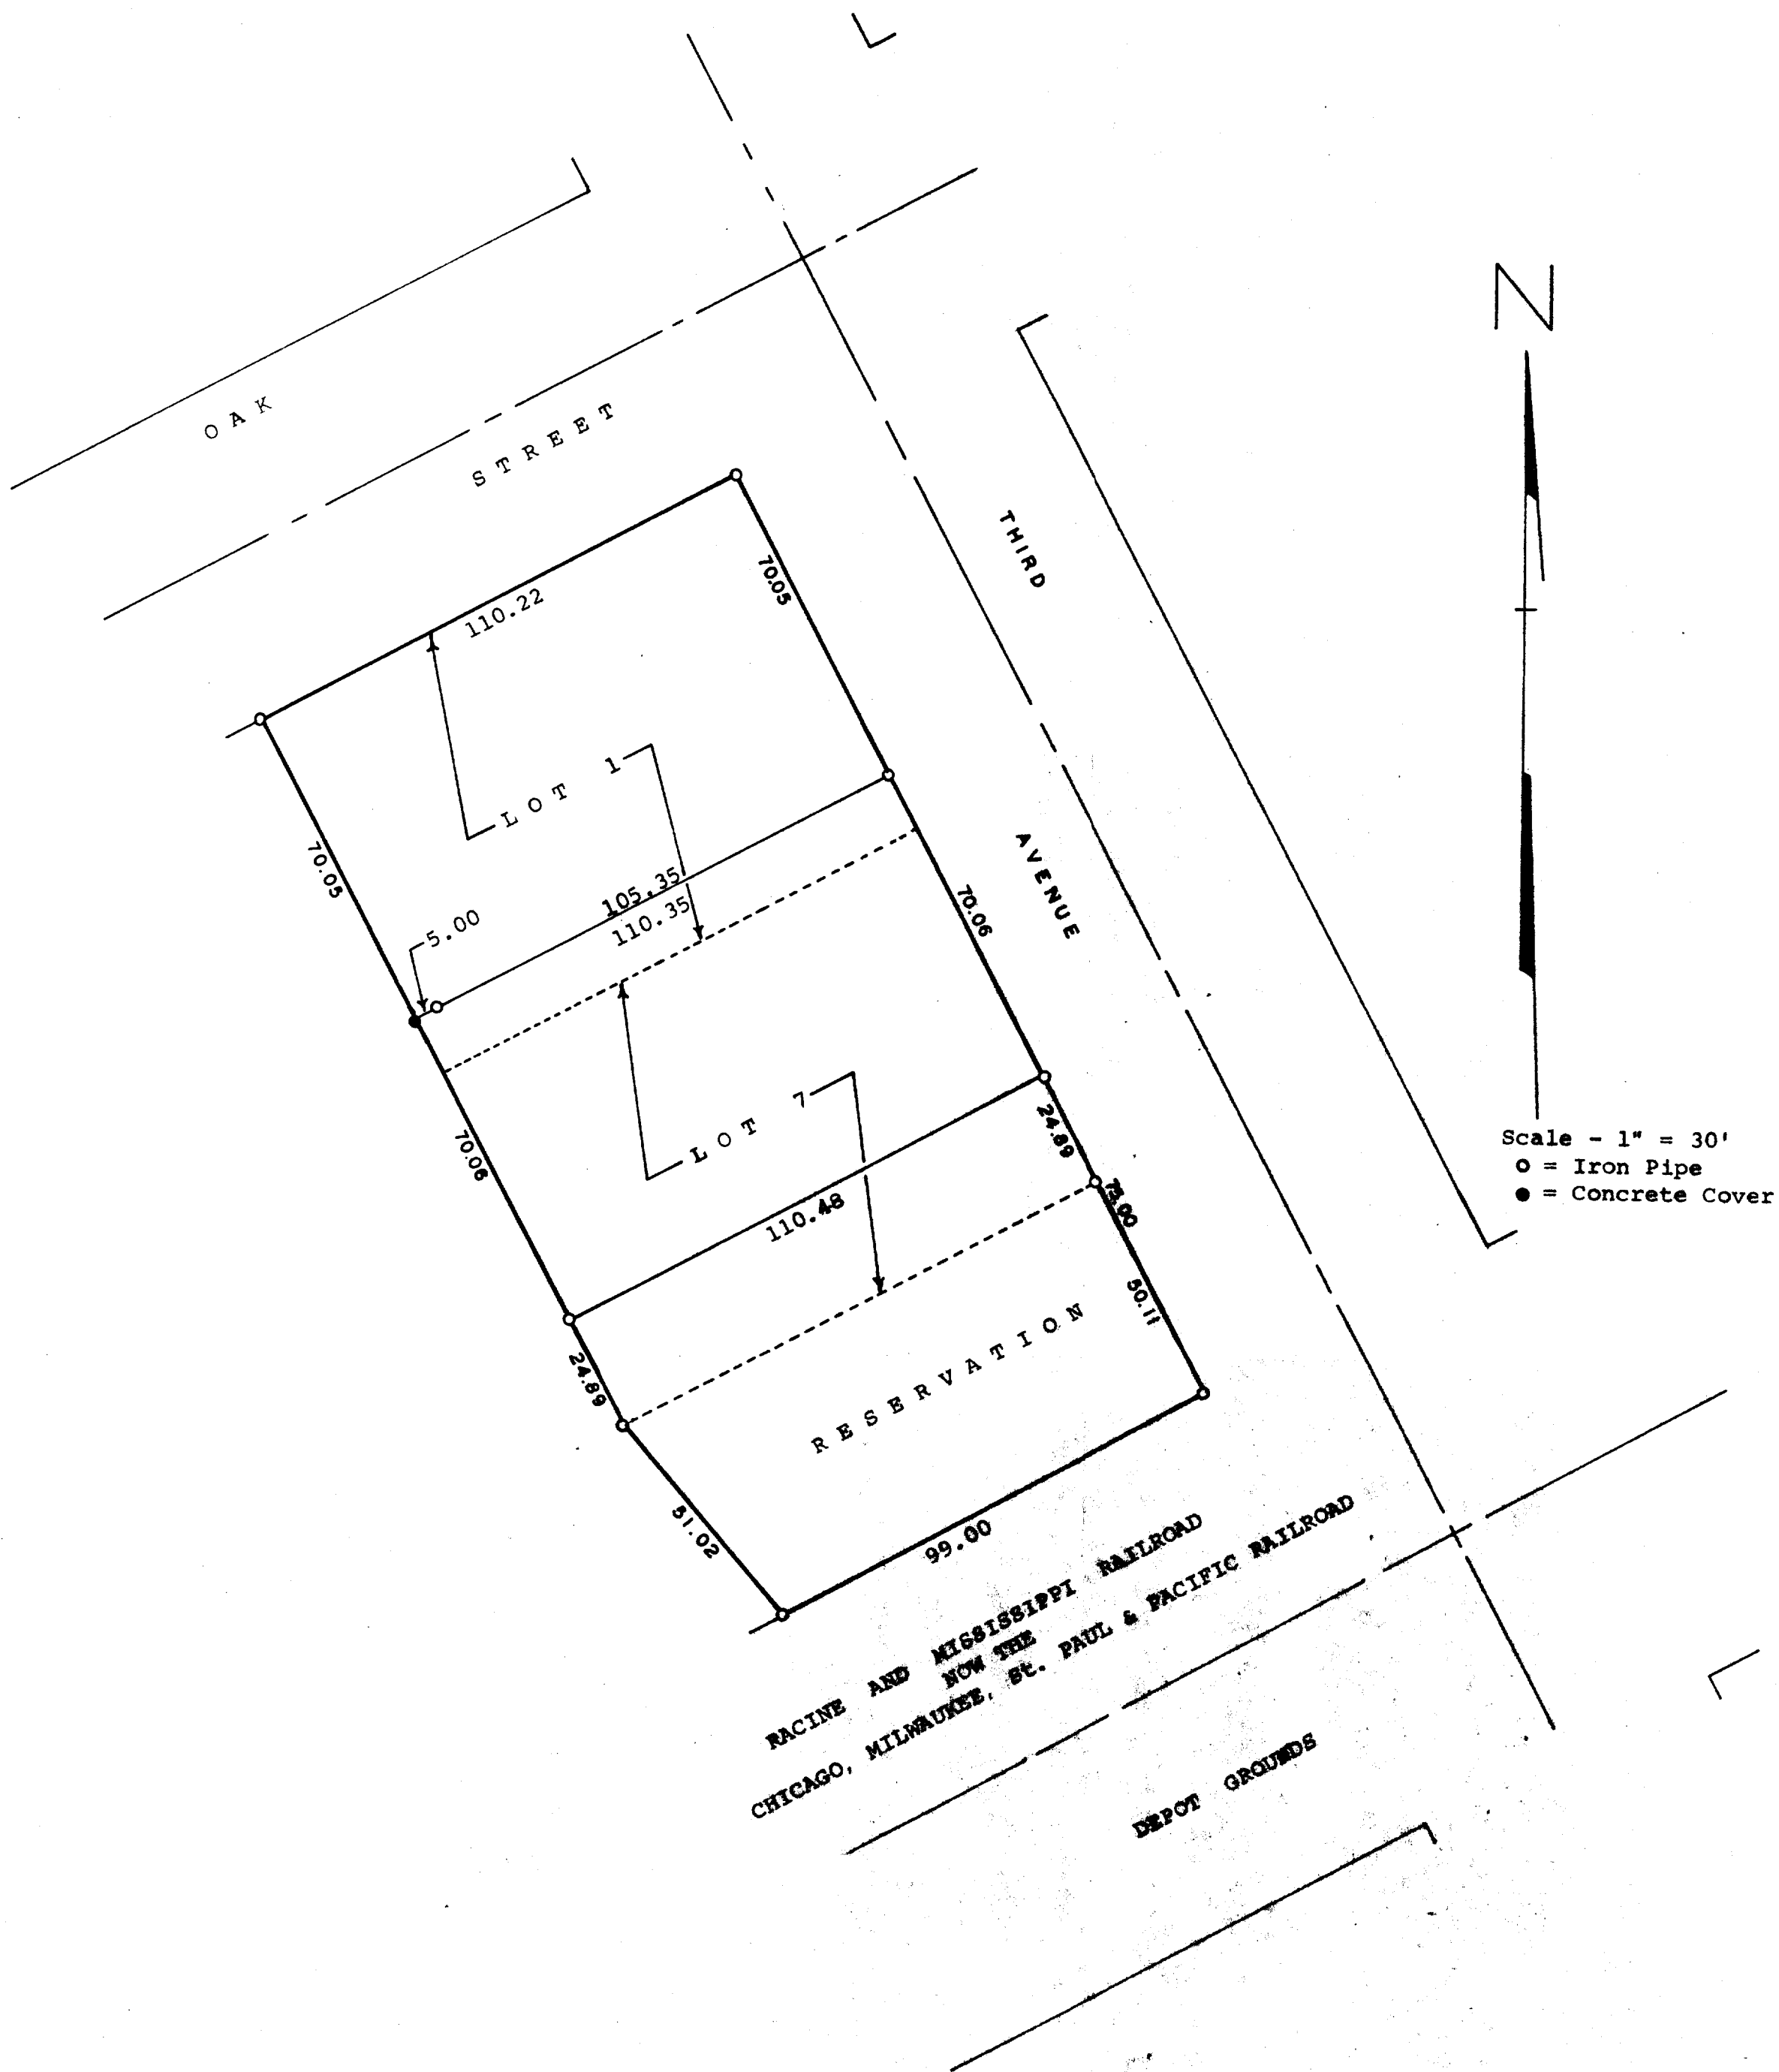

Plat of survey of Lots 1 and 7, Block 4 and part of a parcel of land designated as Reservation, all in the Original Plat of the Village of Darien, Walworth County, Wisconsin.
June 12, 1974

George T. Dunham
George T. Dunham, Surveyor

