




W I S C O N S I N

S T R E E T

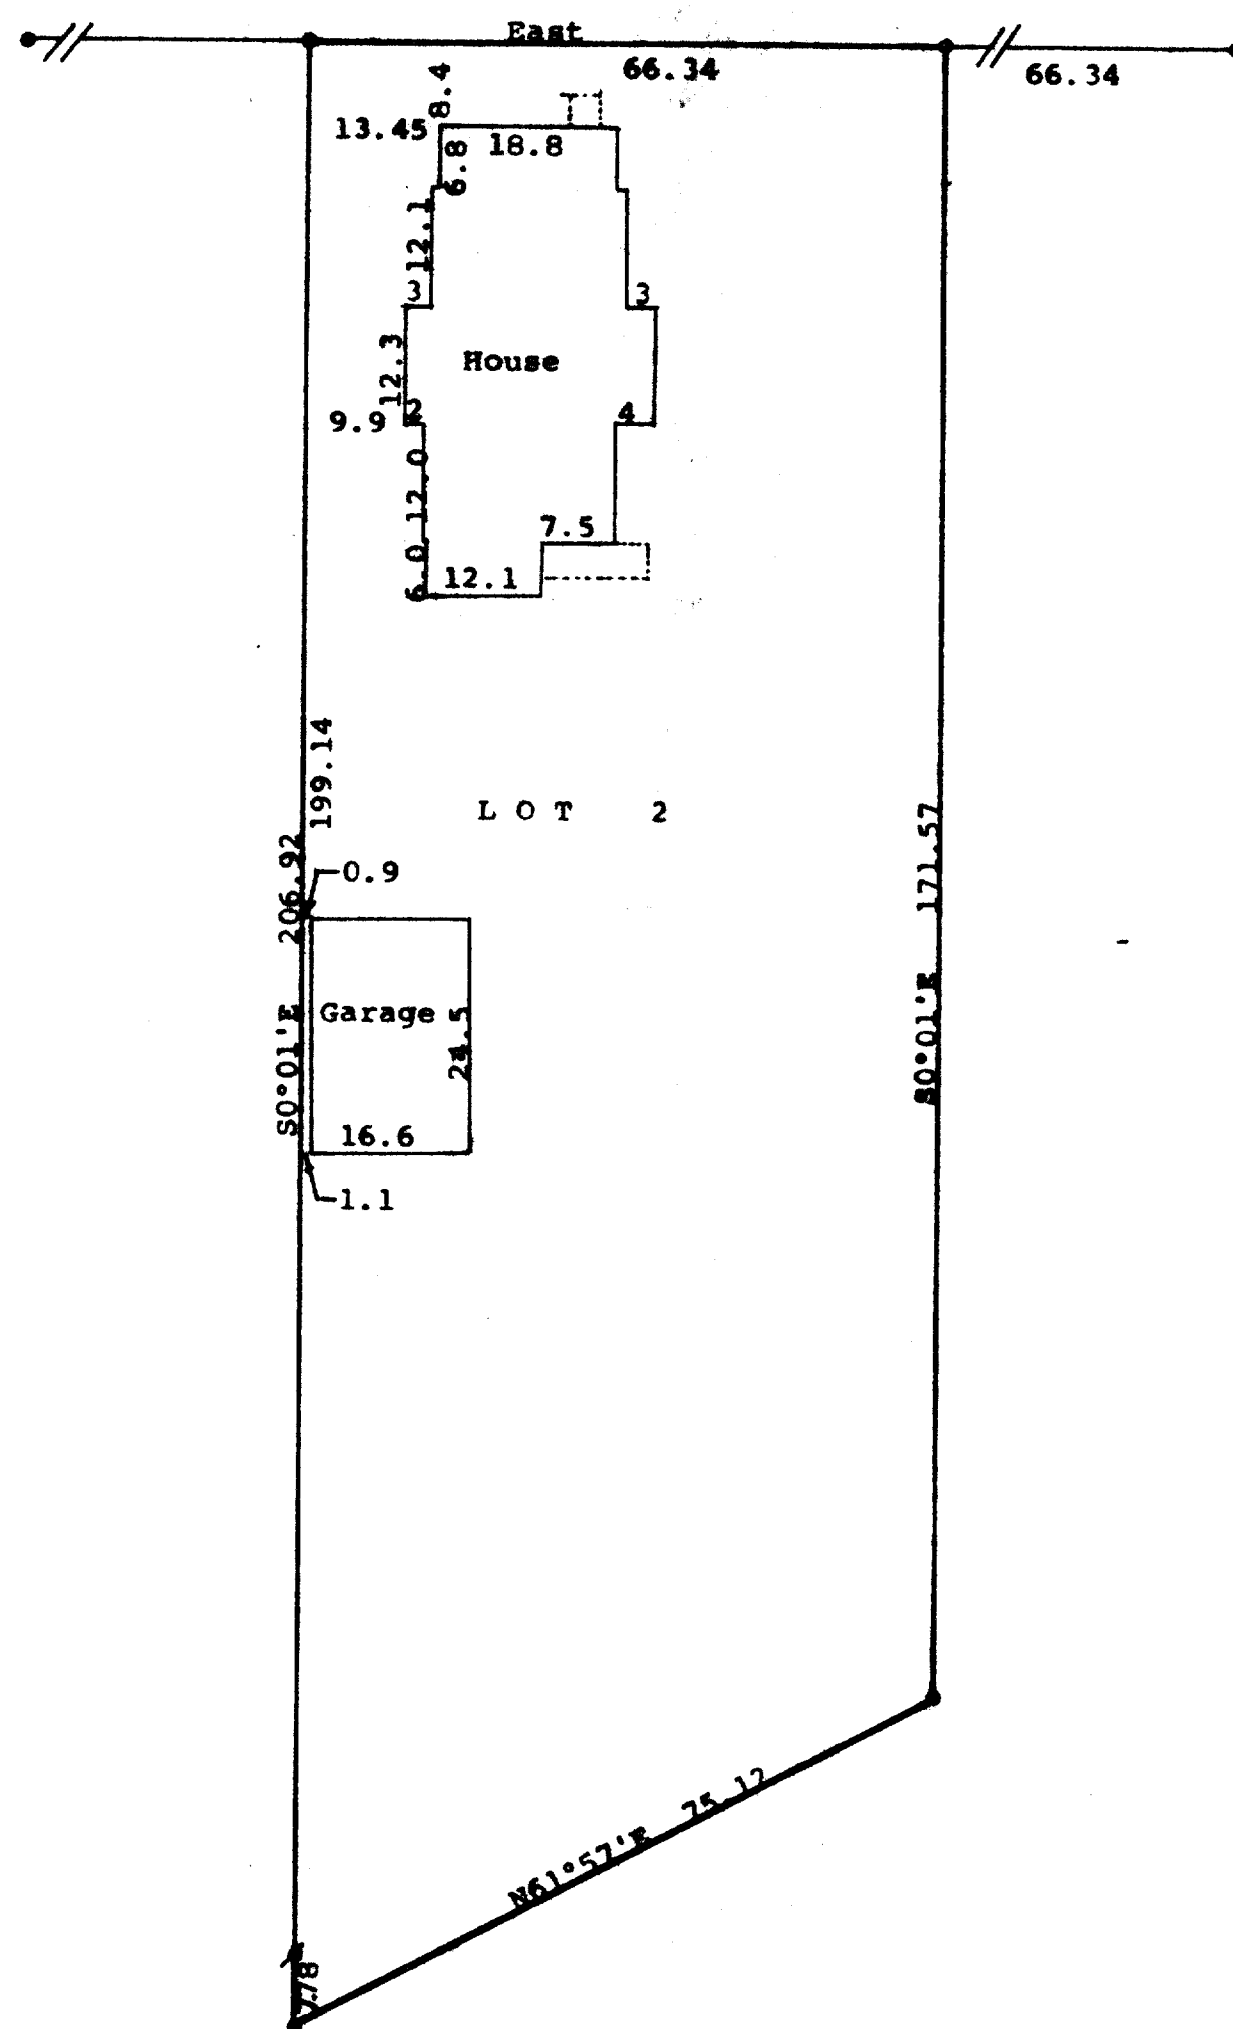

Bearings referenced to the south line of Wisconsin Street with the assumed bearing of East Survey ordered by: The Rauland Agency
118 Kenosha Street
Walworth, WI 53184

George T. Dunham
George T. Dunham, Surveyor

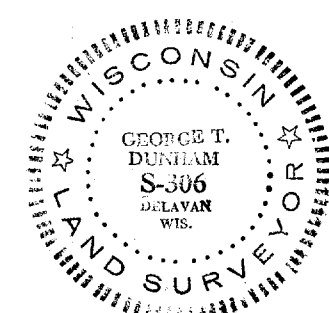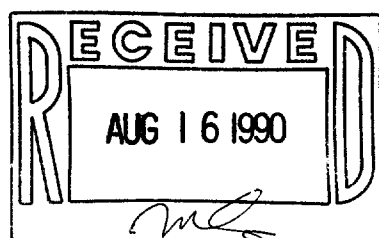

Survey # 002-1007

TAX KEY # ~~XP XXXX51~~