


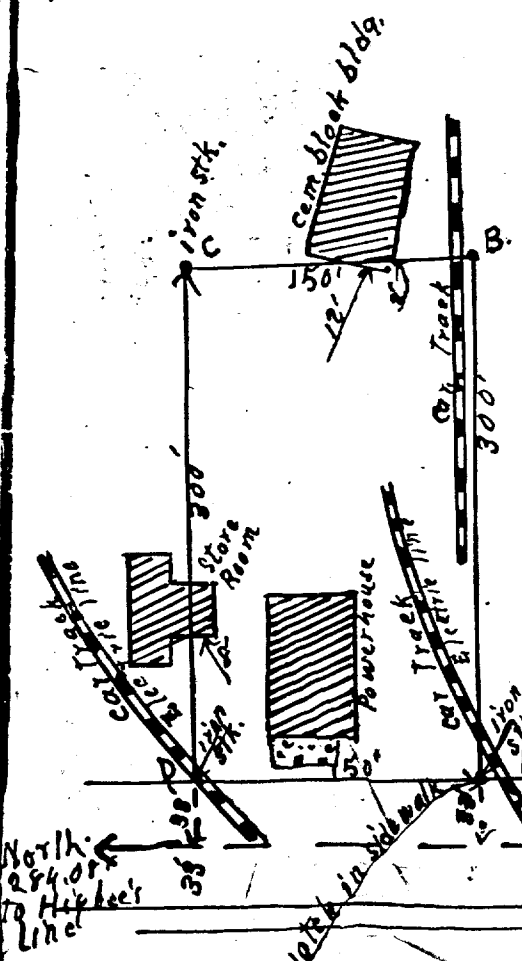

to Skeels, C. E.,
re Mr. Palmer, Asst

35' 35' 1/4 sect cor.
covered by
pave ment

58 12/15/23. Copy of Delavan

Lot 1: Begin at N.E. Cor.
to City of Delavan, W.
to S. line Lot 1. easterly
to beginning. Lot 1. 83.7'
Wis. Street N. (66' wide)
Mon. at S. W. cor. lot
where iron or other material
Ray St. 66' wide
Passage - Tram

Block 9 Lots 15, 16, 17.
Wis. St. at 6th St 82.5'
Lot 17 N. 48' S. 83.5' W. 93'
Lot 16 N. 38.5' S. 38.6' Lot

See plat

Walworth, 1938.

83 rods $3\frac{1}{2}$ ' N. of N. 1/4
E. 300' ~~1175~~ ¹¹⁷⁵ Higbee
W. as before 300' S.
Higbee S. line 1972.06

Surveyed Dec. 17.

lots 15, 16, 17. are parallel
line. Wis. St. 78'
Power cage at N.W.
S. line 38' N. of Ctr. of
10 off. E. side Lot
Stake at N.E. & S.E.

records of Electric Light prop. at
Walworth.

lot 1. B. 6. Converse's Sub-Ad.
in N. line Lot 1. 10' S. 11 E. line 1
10' to S. E. Cor. of 1. N in E. line. 160'
N line 63.5' S. line.

iron stks central at E. end. of St.

1". Wood stks at all Cors. except
stks $5\frac{1}{2}$ " x $3\frac{1}{4}$ " x $3\frac{1}{4}$ " pine. Platted in 1909.
Fremont 63'. stks on R.R. line 6' more or less
Downie

wide at Lot 15 66'

8.60.

15' 30' x 60'

Cor. 22-1-16

S. line. N. 11 Sect. line 150'

in Sect. line 150'

N. of 1/4 cor

1923. - as described above.

pl. to R.R. No bldgs over R.R.

wide as built up.

Cor. in street

Main track

B. 9. Converse & O.K.

Cors. found.

2-100-SK

Part of lot 1, Blk 6 Converse Subd
also lots 15, 16 & 17 of Blk 9 Pass. Aron + Downie add (p-138)

58 12/15/23. Copy of
DeLaan

Lot 1: Begin at N.E. Cor.
to C/P of DeLaan, W.
to S. line Lot 1. Easterly
to beginning. Lot 1. 83.7'
Wis. Street N. (66' wide)
Mon. at S. W. cor. lot
where iron or other material
Ray St. 66' wide
Passage - Tram

Block 9 Lots 15, 16, 17.
Wis. St. at 6th St. 82.5'
Lot 17 N. 49' S. 83.5' W. 93'
Lot 16 N. 38.5' S. 38.5' Lot

See plat

Walworth, 1938.

83 rods $3\frac{1}{4}$ N. of $W\frac{1}{4}$

E. 300 ~~11~~ to Higbee

W. as before 300' S.

Higbee & line 1972. of

Surveyed Dec. 17.

lots 15, 16, 17, are parallel

line. Wis. St. 78'

Power cage at N.W.

S. line 38' N. of C/P of

10' off E. side Lot 1

Stake at N.E. & S.E.

records of Electric Light Prop at
& Walworth.

lot 1. B. 6. Converse's Sub-Ad.
in N. line Lot 1. 10' S. 11 E. line 1
10' to S. E. cor. of 1. N in E. line. 160'
N line 63.5' S line.

iron. Stk central at E. end. of St.

19. Wood stks at all Cors. except

stks $5\frac{1}{2}$ " x $3\frac{1}{4}$ " x $3\frac{1}{4}$ " pine. Platted in 1909.

Fremont 63'. Stks on R.R. line 6' more or less

Downie

wide at Lot 15- 66'

8.60.

15-30' x 60'

cor. 22-1-16

S. line. N. 11. Sect. line 150'

in Sect. line 140'

N. of $\frac{1}{4}$ cor.

1923. as described above.

pl. to R.R. No bldgs over R.R.

wide as built up.

cor. in street

main track.

B. 6 Converse & O.K.

Cors. found.