


DUNHAM SURVEYING, S. C.
SURVEYING & SUBDIVIDING
DELAVER, WISCONSIN 53115

EDWARDS

STREET

BRADLEY AVENUE

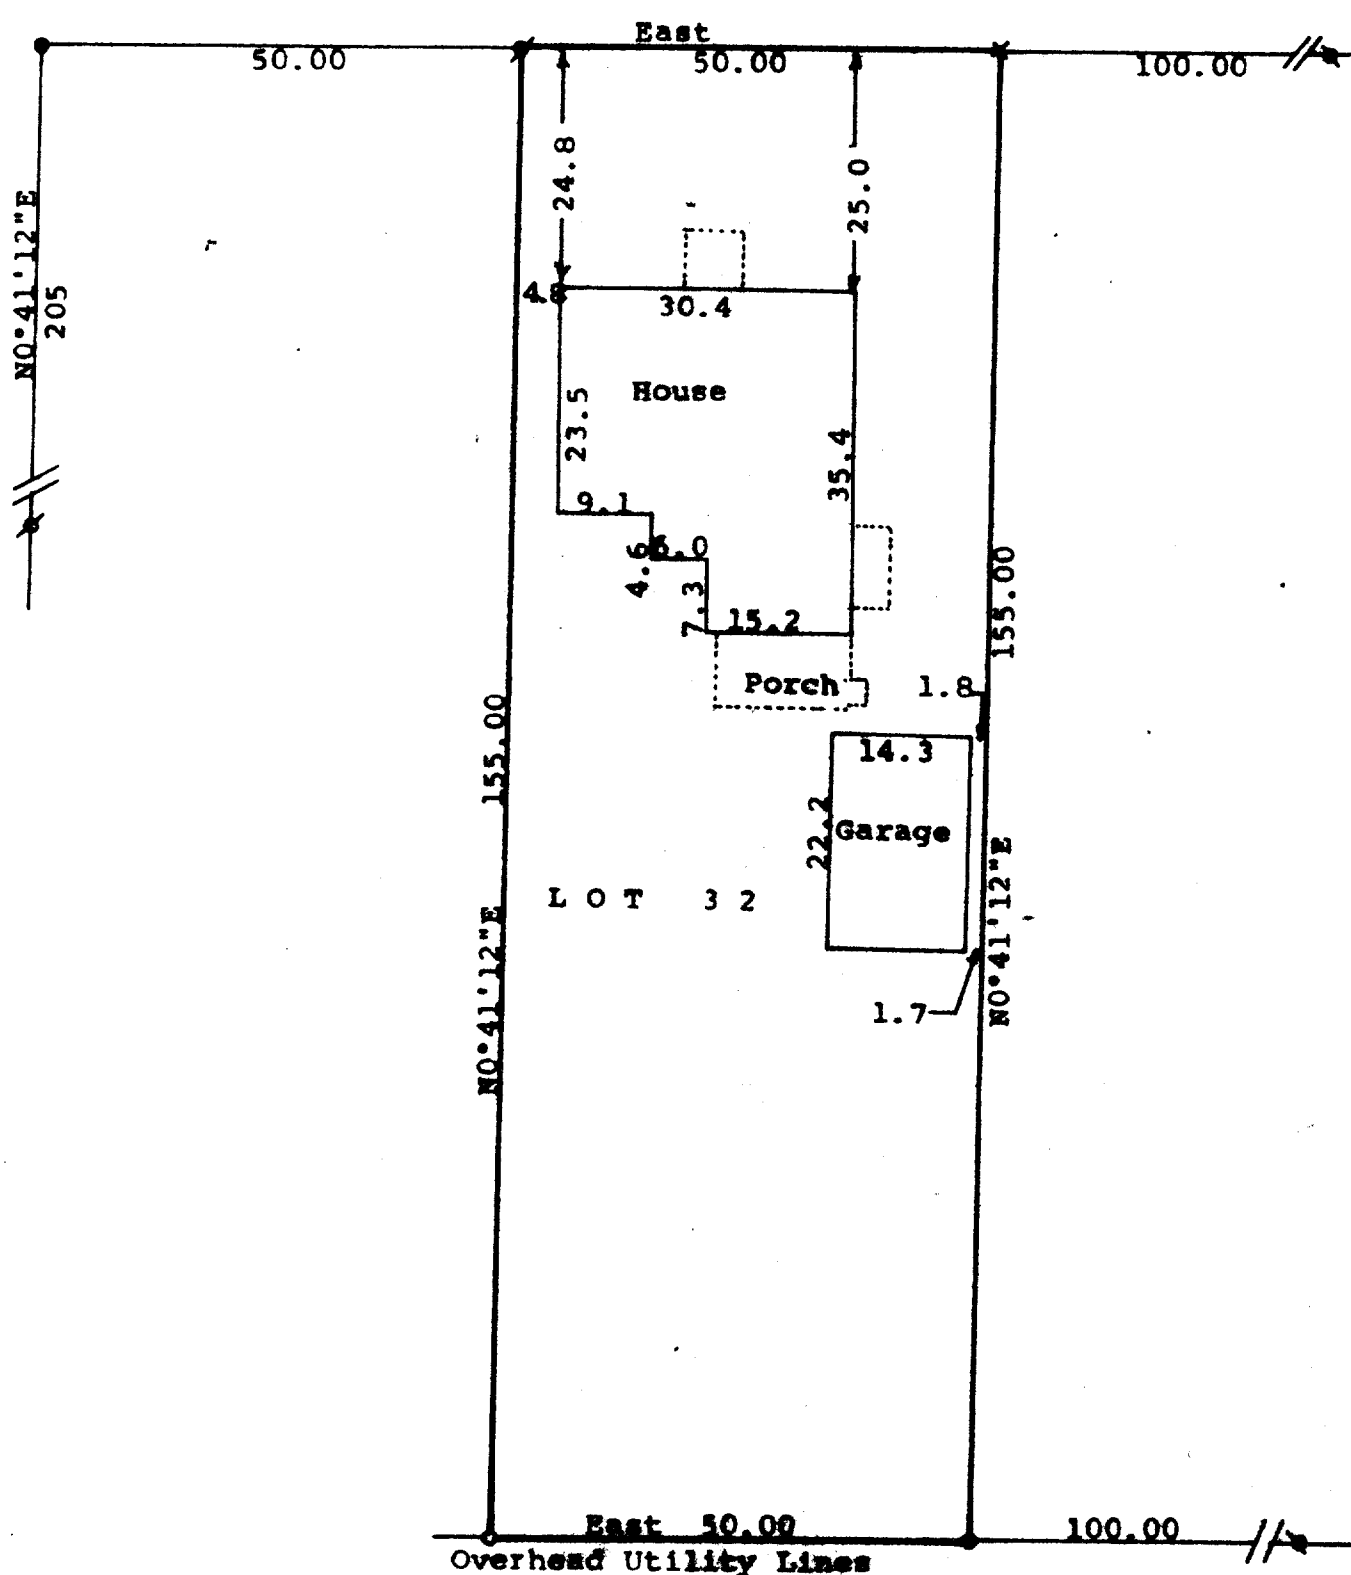

Scale - 1" = 20'

X = cross cut in concrete walk
o = 3/4" X 24" Iron Pipe Set
/ = 1 1/4" Iron Pipe Found
/ = 1" X 10" Iron Rod found 0.6' S. of correct line. Pulled and set 3/4" X 24" Iron Pipe on correct line.

Bearings referenced to the south line of Edwards Street with the assumed bearing of East

Survey ordered by:
Century 21, Skandia Realty
312 South 7th Street
Delavan, WI 53115

o = 1" Iron Rod on Concrete
/ = 3/4" Iron Pipe Found

STATE OF WISCONSIN) SS
COUNTY OF WALWORTH)



I, George T. Dunham, Surveyor, certify that I have surveyed the property described as follows:

Lot 32 of Tyrrell's Subdivision located in the City of Delavan, Walworth County, Wisconsin.

and that the plat shown hereon is a correct representation thereof and shows the size and location of the property, its exterior boundaries, the location of all visible structures and dimensions of all principal buildings thereon, boundary fences, apparent easements, roadways and visible encroachments, if any, and that I have surveyed the property hereon described, according to the official records, to the best of my knowledge and belief.

May 23, 1990

George T. Dunham
George T. Dunham, Surveyor

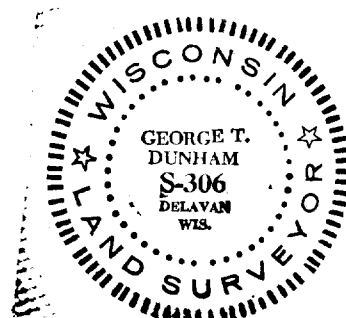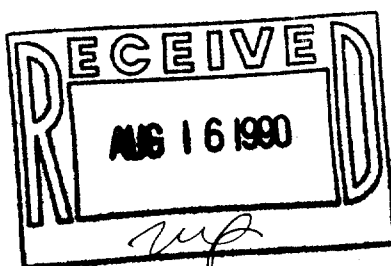

Survey # 002-1019

TAX KEY #