

ABELL
SURVEYING & MAPPING
DELAVAN, WISCONSIN 53115
414-720-6787

ORDERED BY: PHILLIP BICKEL
113 N. 4th ST.
DELAVAN, WI. 53115

SIXTH STREET

RAILROAD

SHED IS ON CONC.
SLAB

9.5'
SHED

19


BLOCK

HOUSE

GRAVEL
DRIVE

STREET

ANN

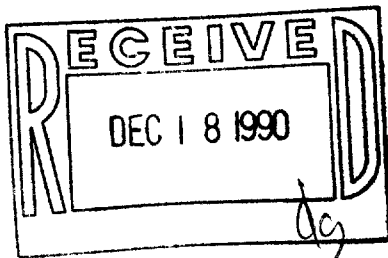

PLAT OF SURVEY OF

LOTS 19 AND 20, BLOCK 10 OF
PASSAGE, ARAM & DOWNIE ADDITION
TO THE CITY OF DELAVAN, WALWORTH
COUNTY, WISCONSIN.



SCALE - 1"=20'

LEGEND

- - IRON PIPE FOUND
- - CONCRETE MONUMENT FOUND
- - IRON ROD SET
- () - AS SHOWN ON EXISTING SURVEY RECORDS

I HEREBY CERTIFY THAT I HAVE SURVEYED THE ABOVE DESCRIBED PROPERTY AND THAT THE ABOVE MAP IS A TRUE REPRESENTATION THEREOF AND SHOWS THE SIZE AND LOCATION OF THE PROPERTY, ITS EXTERIOR BOUNDARIES, THE LOCATION OF ALL VISIBLE STRUCTURES AND DIMENSIONS OF ALL PRINCIPAL BUILDINGS THEREON, BOUNDARY FENCES, APPARENT EASEMENTS, ROADWAYS AND VISIBLE ENCROACHMENTS, IF ANY, TO THE BEST OF MY KNOWLEDGE AND BELIEF.

THIS SURVEY IS MADE FOR THE USE OF THE PRESENT OWNERS OF THE PROPERTY, AND ALSO THOSE WHO PURCHASE, MORTGAGE, OR GUARANTEE THE TITLE THEREIN WITHIN ONE (1) YEAR FROM DATE HEREOF.

David F. Abell
DAVID F. ABELL
WISCONSIN REGISTERED LAND SURVEYOR, S-1596

DATE *July 27, 1990* JOB NUMBER - 90141
NOTE: THIS IS NOT A CERTIFIED COPY UNLESS SEALED.

002-1033

XP00144