


**ABELL
SURVEYING & MAPPING
DELAVER, WISCONSIN 53115
414-728-6737**



PLAT OF SURVEY OF
LOT 4, BLOCK 3 OF THE ORIGINAL PLAT OF THE CITY OF
DELAVER, WALWORTH COUNTY, WISCONSIN.


ORDERED BY: FRANK LANDI
240 ELM STREET
DELAVER, WI. 53115

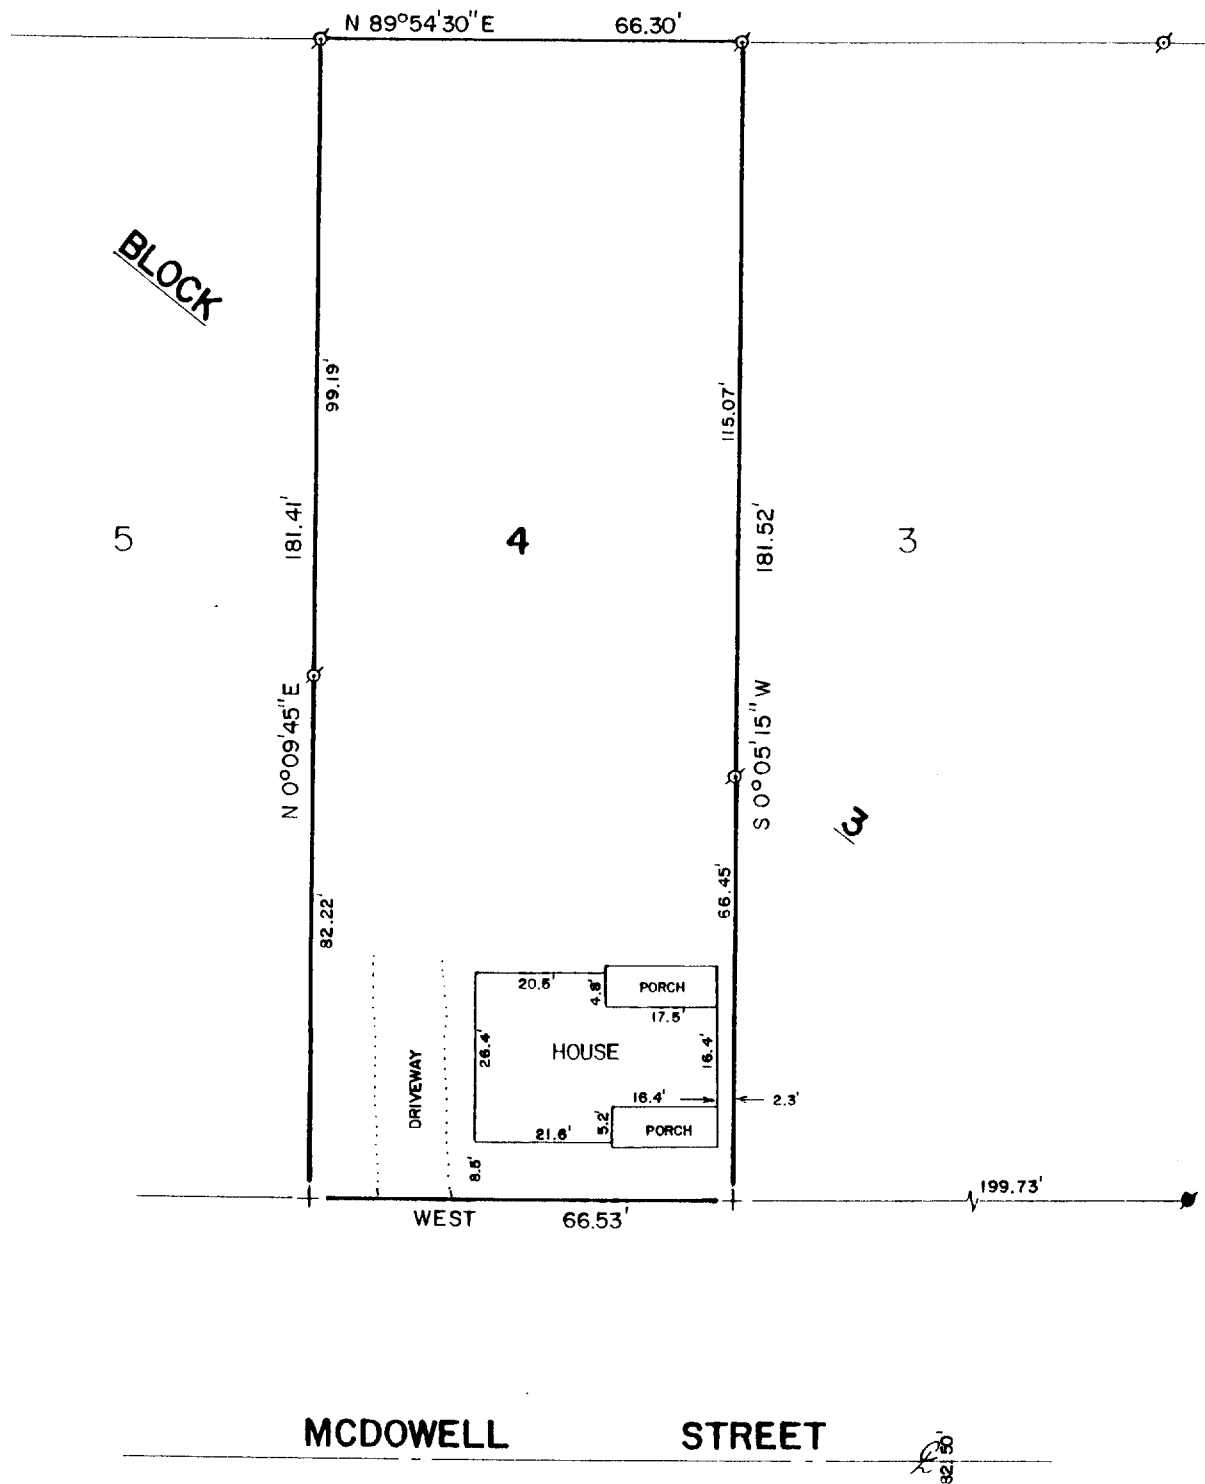

SCALE - 1"=30'

LEGEND

- ⊗ - IRON PIPE FOUND
- + - CUTCROSS IN CONCRETE SIDEWALK FOUND
- - CONCRETE MONUMENT FOUND

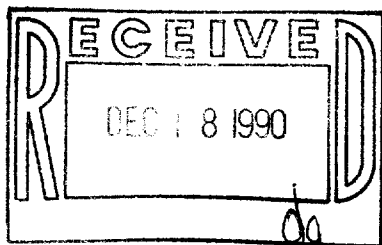

I, DAVID F. ABELL, DO HEREBY CERTIFY
THAT I HAVE SURVEYED THE PROPERTY
HEREON DESCRIBED ACCORDING TO THE
OFFICIAL RECORDS AND THAT THE PLAT
HEREON IS A CORRECT REPRESENTATION
OF THE PROPERTY LINES TO THE BEST OF
MY KNOWLEDGE AND BELIEF.

David F. Abell
DAVID F. ABELL

WISCONSIN REGISTERED LAND SURVEYOR, S-1596

July 19, 1990
DATE

JOB NUMBER - 90143

NOTE: THIS IS NOT A CERTIFIED COPY UNLESS SEALED.