


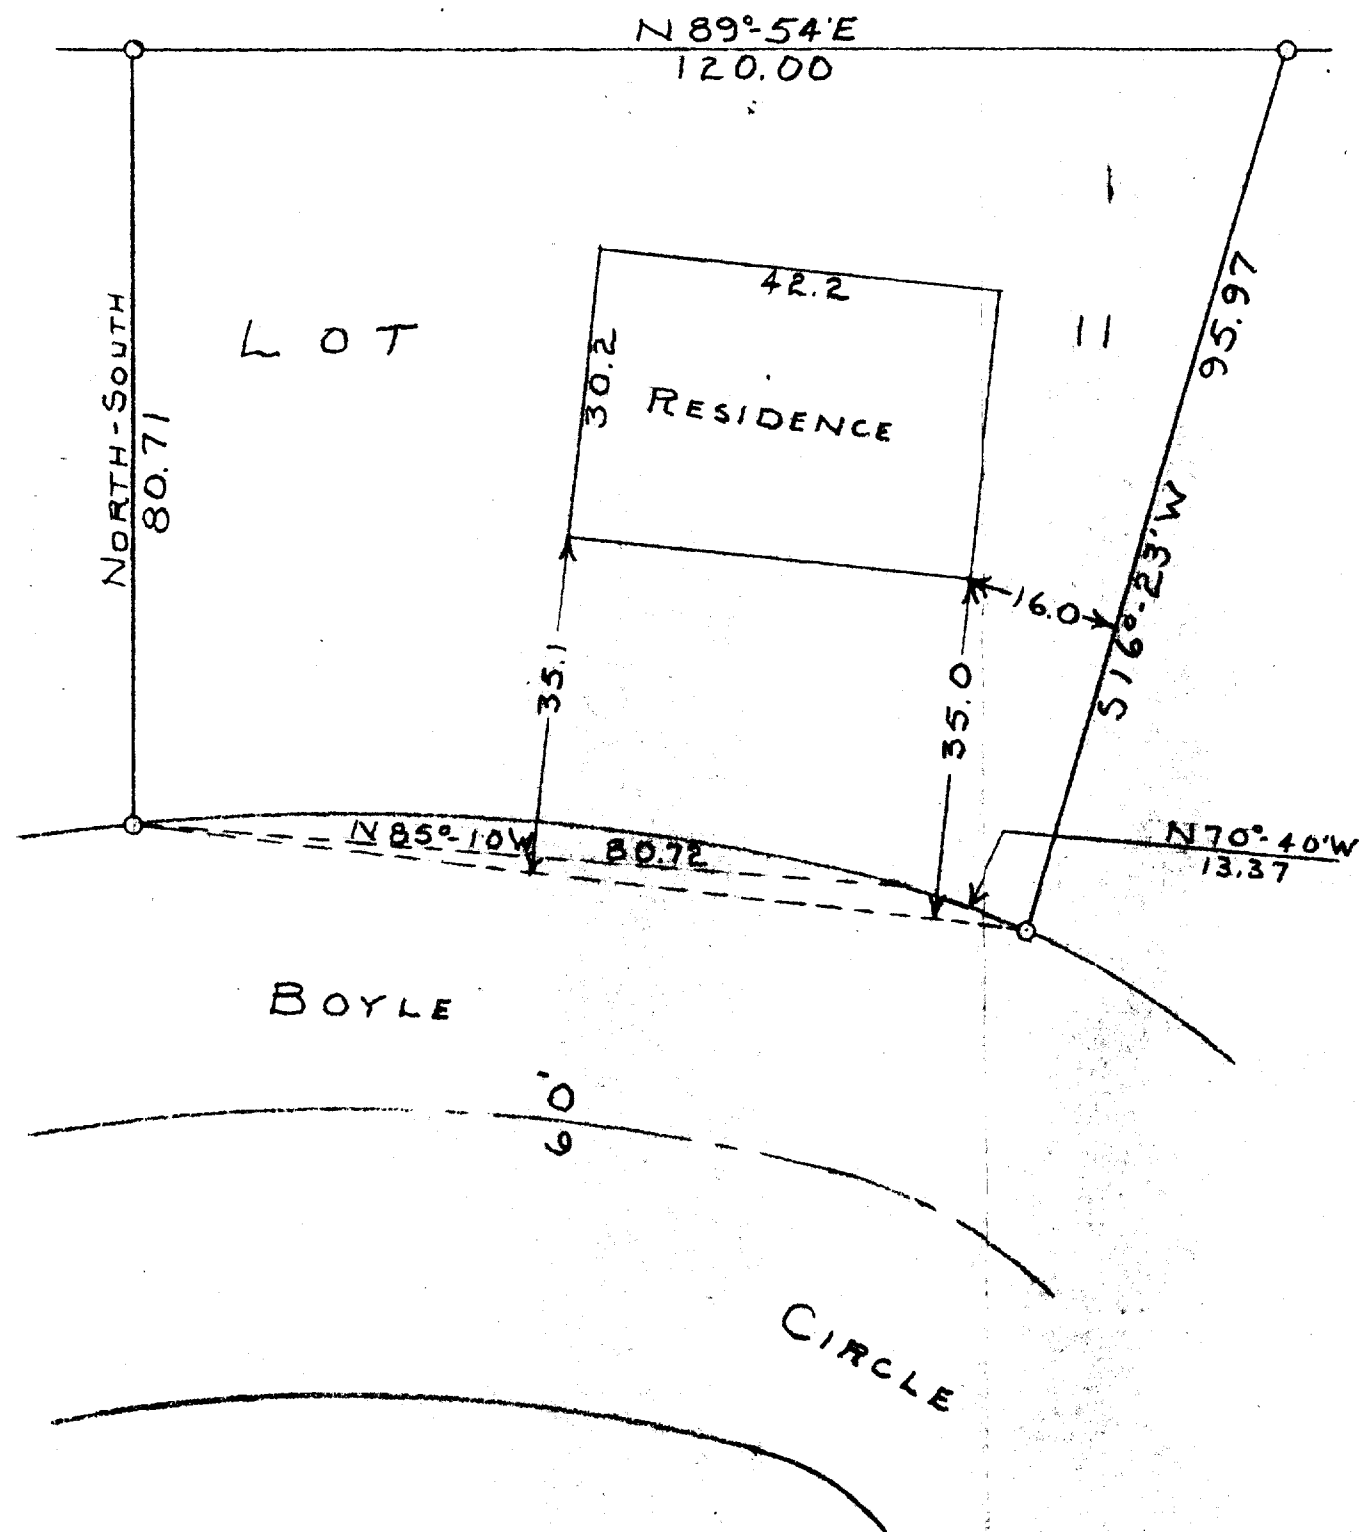

SCALE-1"=20'
O=IRON PIPE

STATE OF WISCONSIN)
WALWORTH COUNTY)

I, GEORGE T. DUNHAM, DO HEREBY CERTIFY, THAT I HAVE SURVEYED
THE PROPERTY DESCRIBED AS FOLLOWS:

LOT 11 OF HILLTOP SUBDIVISION LOCATED IN THE CITY OF DELAVAN,
WALWORTH COUNTY, WISCONSIN

AND THAT THE PLAT SHOWN ABOVE IS A CORRECT REPRESENTATION OF THE PROPERTY
LINES AND OF THE IMPROVEMENTS LOCATED THEREON

JAN. 30, 1959

George T. Dunham
GEORGE T. DUNHAM, SURVEYOR
DELAVAN, WISCONSIN

X#1-11

2-106