



ABELL
SURVEYING & MAPPING
DELAN, WISCONSIN 53115
414-728-6737

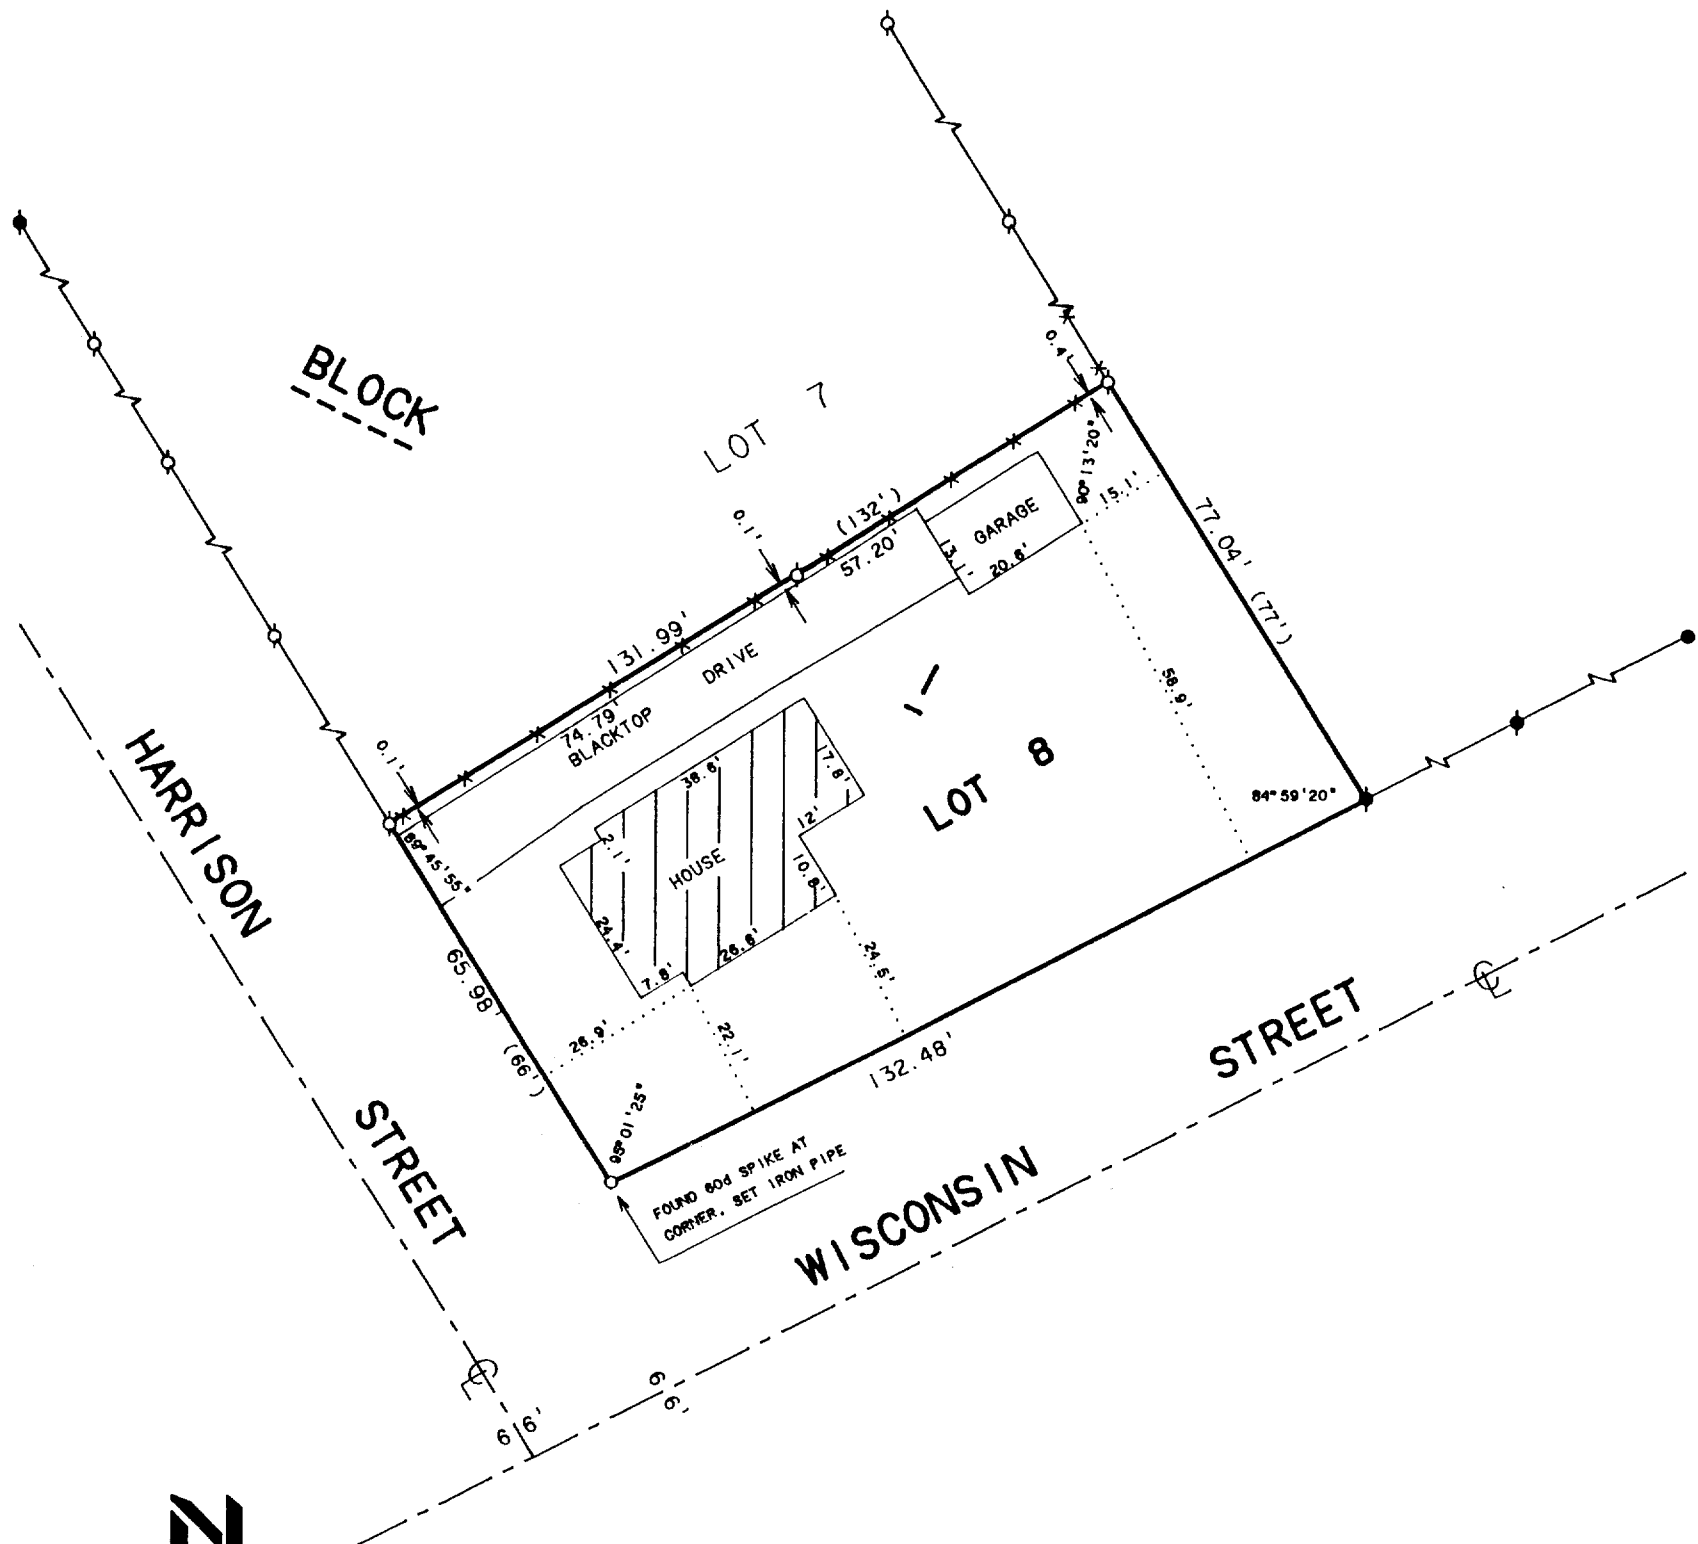

LEGEND

- - IRON PIPE FOUND
- ◆ - IRON ROD FOUND
- - CONCRETE MONUMENT FOUND
- - IRON PIPE SET
- * - CHAINLINK FENCE
- () - RECORDED AS

ORDERED BY: CENTURY 21 - SKANDIA REALTY, INC
312 S. 7th STREET
DELAN, WI. 53115

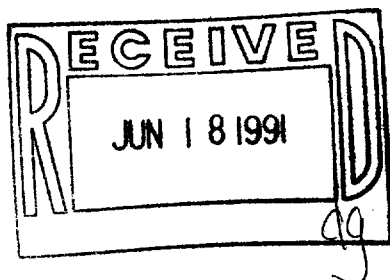

PLAT OF SURVEY OF
LOT 8, BLOCK 1, LARNARDS SUBDIVISION, CITY OF
DELAN, WALWORTH COUNTY, WISCONSIN.

I, DAVID F. ABELL, DO HEREBY CERTIFY THAT I HAVE SURVEYED THE PROPERTY HEREON DESCRIBED ACCORDING TO THE OFFICIAL RECORDS AND THAT THE PLAT HEREON IS A CORRECT REPRESENTATION OF THE PROPERTY LINES TO THE BEST OF MY KNOWLEDGE AND BELIEF.

David F. Abell

DAVID F. ABELL
WISCONSIN REGISTERED LAND SURVEYOR, S-1596

April 17, 1991

DATE: April 17, 1991 JOB NUMBER - 91068
NOTE: THIS IS NOT A CERTIFIED COPY UNLESS SEALED.

002-1067

XLDA 00009