


Plat of Survey

of

Lot 35 of the First Addition to Tod Miller Subdivision, located in the Northeast 1/4 of Section 19, Town 2 North, Range 16 East, City of Delavan, Walworth County, Wisconsin.

Surveyed for: Ed Wellnitz Builder, Inc.
1001 Highway 14 North
Janesville, Wisconsin. 53545

Bearings referenced to the
Subdivision Plat.

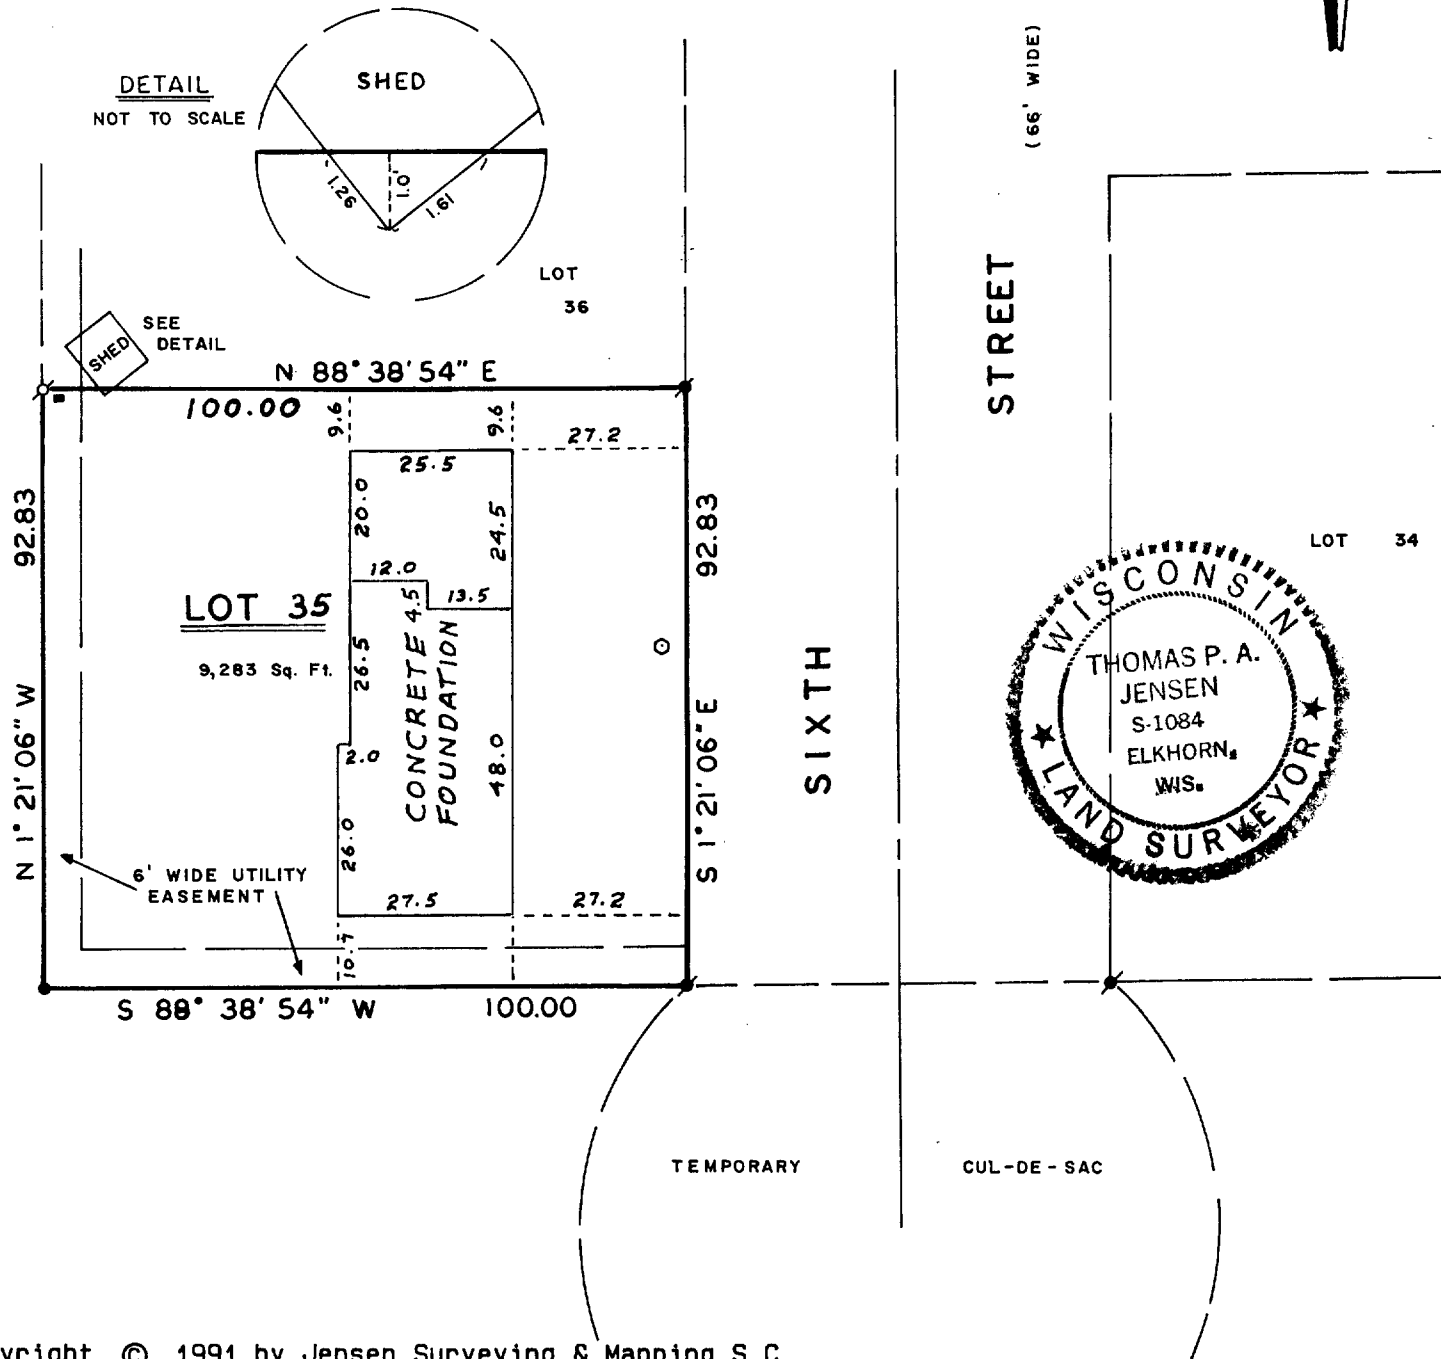


Copyright © 1991 by Jensen Surveying & Mapping S.C.

All rights reserved. No part of this survey plat may be reproduced or transmitted in any form by any means - graphic, electronic, or mechanical, including photocopying, tracing, or information storage and retrieval systems - without permission in writing from Thomas P.A. Jensen.

I, Thomas P.A. Jensen, Wisconsin Registered Land Surveyor, do hereby certify that this survey was performed by me, or under my direction, in full compliance with the owner's/agent's instructions and Chapter A-E 7 of the Wisconsin Administrative Code 'Minimum Standards For Property Surveys', and that this map is an accurate representation thereof to the best of my knowledge and belief.

Note: This survey plat is not
certified unless signed
and sealed in red ink.

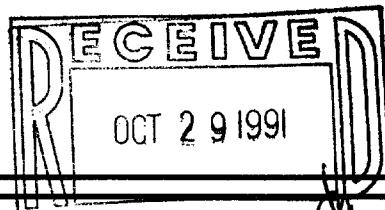

Thomas P.A. Jensen
Thomas P.A. Jensen R.L.S. 1084

Legend

- ~ Found iron pipe
- ~ Found iron rod, 3/4' dia.
- - Set iron rod 3/4' dia.
- () - Recorded as dimension
- - Utility box
- - Water valve


Jensen Surveying & Mapping S.C.
45 South Wisconsin Street P.O. Box 322
Elkhorn, Wisconsin. 53121.
(414) 723-3434

Mapping date: January 31, 1991
Revisions: FEB. 15, 1991

Sheet 1 of 1 Sheets

Job reference number:
1991.018

Scale: 1" = 30'

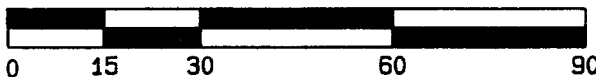

002-1070

XM1A-66009