


SCALE ~ 1" = 20'
 O ~ IRON PIPE
 ● ~ CONC. MON.

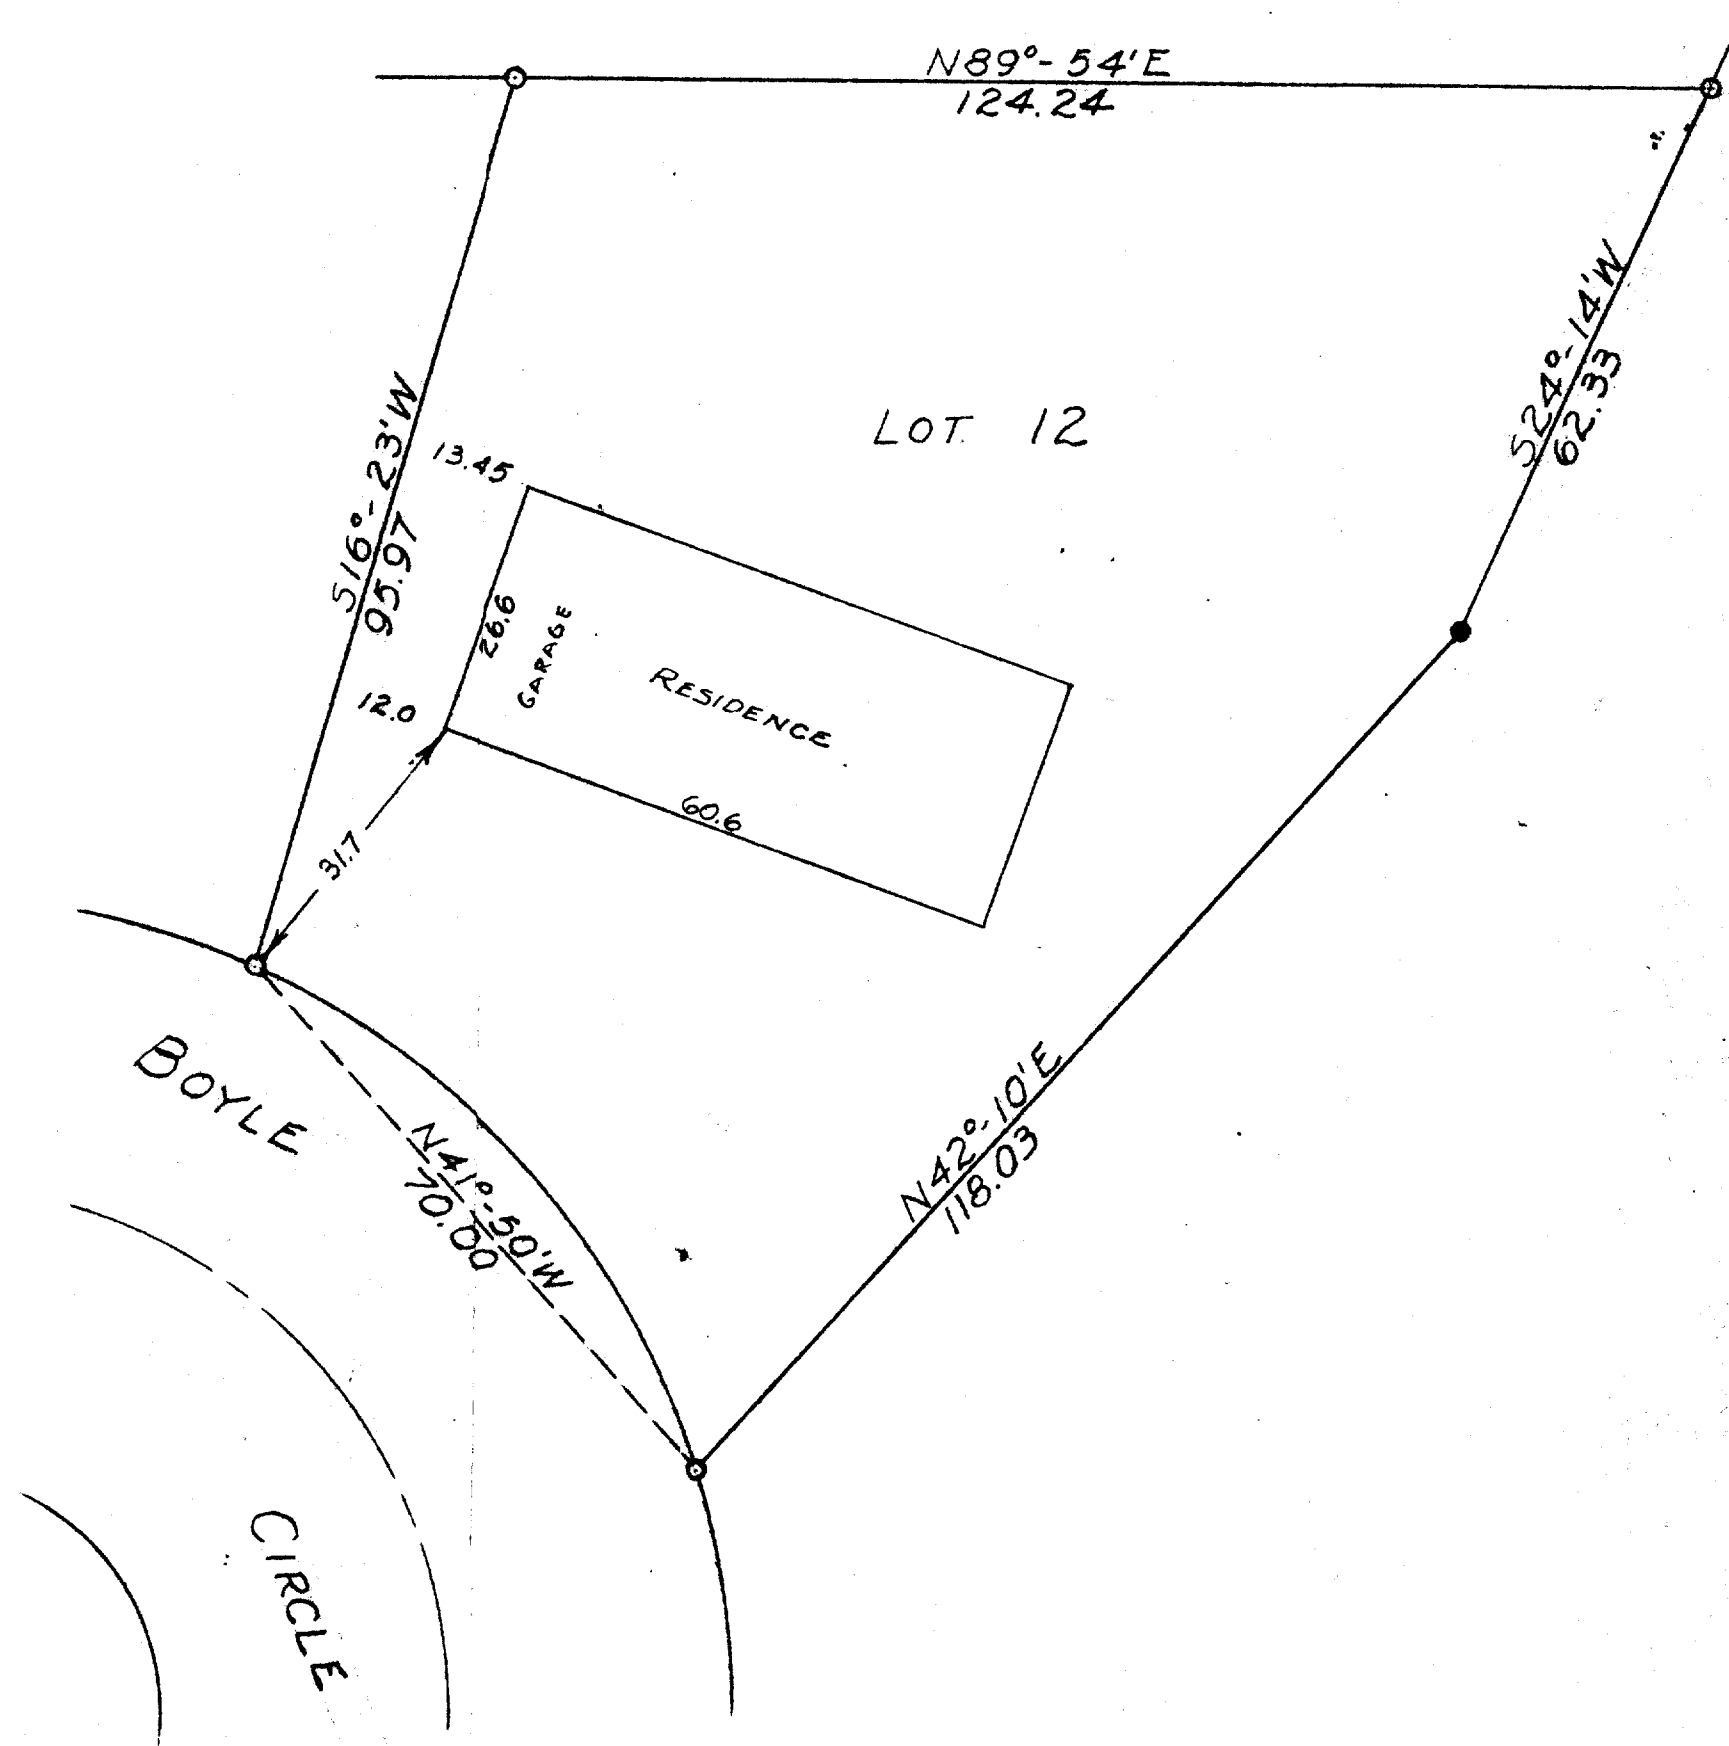

STATE OF WISCONSIN } S.S.
 WALWORTH COUNTY }

I, GEORGE T. DUNHAM DO HEREBY CERTIFY THAT I HAVE SURVEYED THE PROPERTY DESCRIBED AS FOLLOWS:

LOT 12 OF HILLTOP SUBDIVISION LOCATED IN THE CITY OF DELAVAN, WALWORTH COUNTY, WISCONSIN.

AND THAT THE PLAT SHOWN ABOVE IS A CORRECT REPRESENTATION OF THE PROPERTY LINES AND THE IMPROVEMENTS LOCATED THEREON.
 SEPT. 5, 1958

George T. Dunham
 GEORGE T. DUNHAM, SURVEYOR
 DELAVAN, WISCONSIN