


DUNHAM SURVEYING, S.C.
SURVEYING & SUBDIVIDING
DELAVAN, WISCONSIN 53115

North 1/4 section corner of Section 18-2-16
as shown by the county surveyor prior to 1971

North 1/4 section corner as relocated
in 1971.

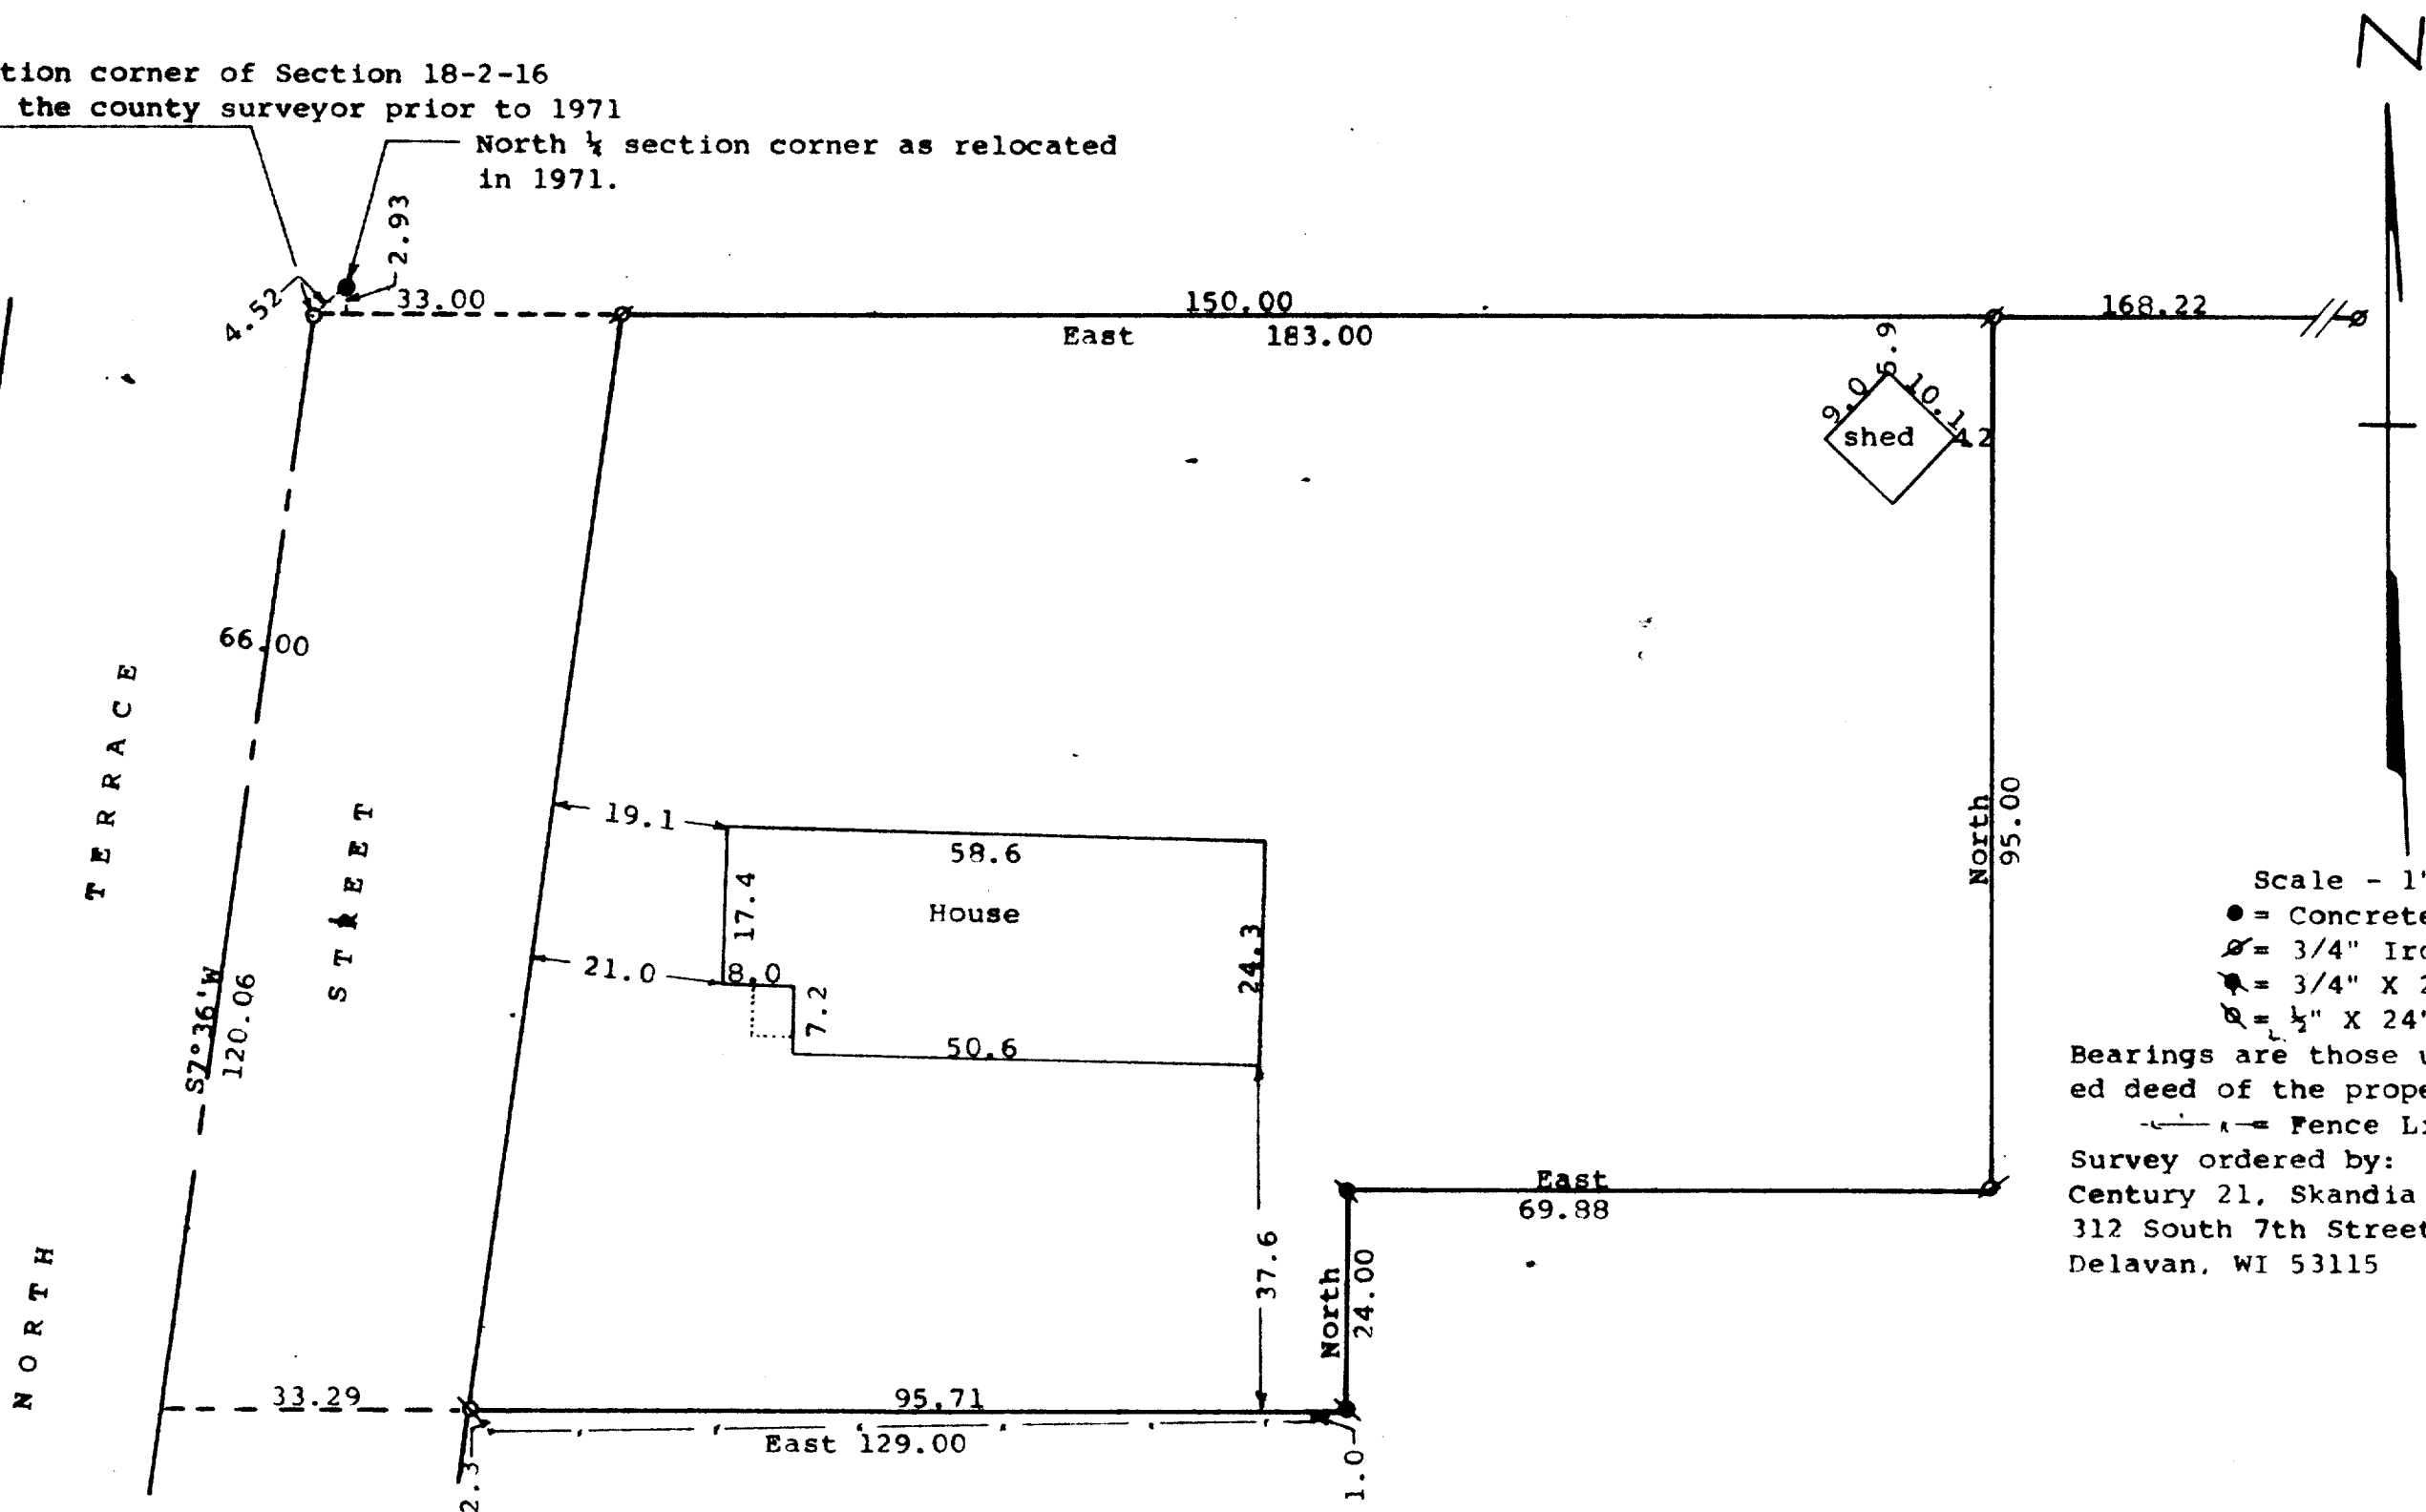

STATE OF WISCONSIN)
COUNTY OF WALWORTH)

I, George T. Dunham, Surveyor, certify that I have surveyed the property described as follows:

A parcel of land located in the Northwest 1/4 of the Northeast 1/4 and in the Northeast 1/4 of the Northwest 1/4 of Section 18, T 2 N, R 16 E, City of Delavan, Walworth County, Wisconsin, described as follows: Beginning at the North 1/4 corner of said Section 18; thence S7°36'W along the centerline of North Terrace Street, 120.06 feet; thence East 129.00 feet; thence North 24.00 feet; thence East 69.88 feet; thence North 95.00 feet to the north line of said Section 18; thence West 183.00 feet to the place of beginning

and that the plat shown hereon is a correct representation thereof and shows the size and location of the property, its exterior boundaries, the location of all visible structures and dimensions of all principal buildings thereon, boundary fences, apparent easements, roadways and visible encroachments, if any, and that I have surveyed the property hereon described, according to the official records, to the best of my knowledge and belief.

April 26, 1991

George T. Dunham
George T. Dunham, Surveyor

