


DUNHAM SURVEYING, S.C.
 SURVEYING & SUBDIVIDING
 DELAVAN, WISCONSIN 53115

N

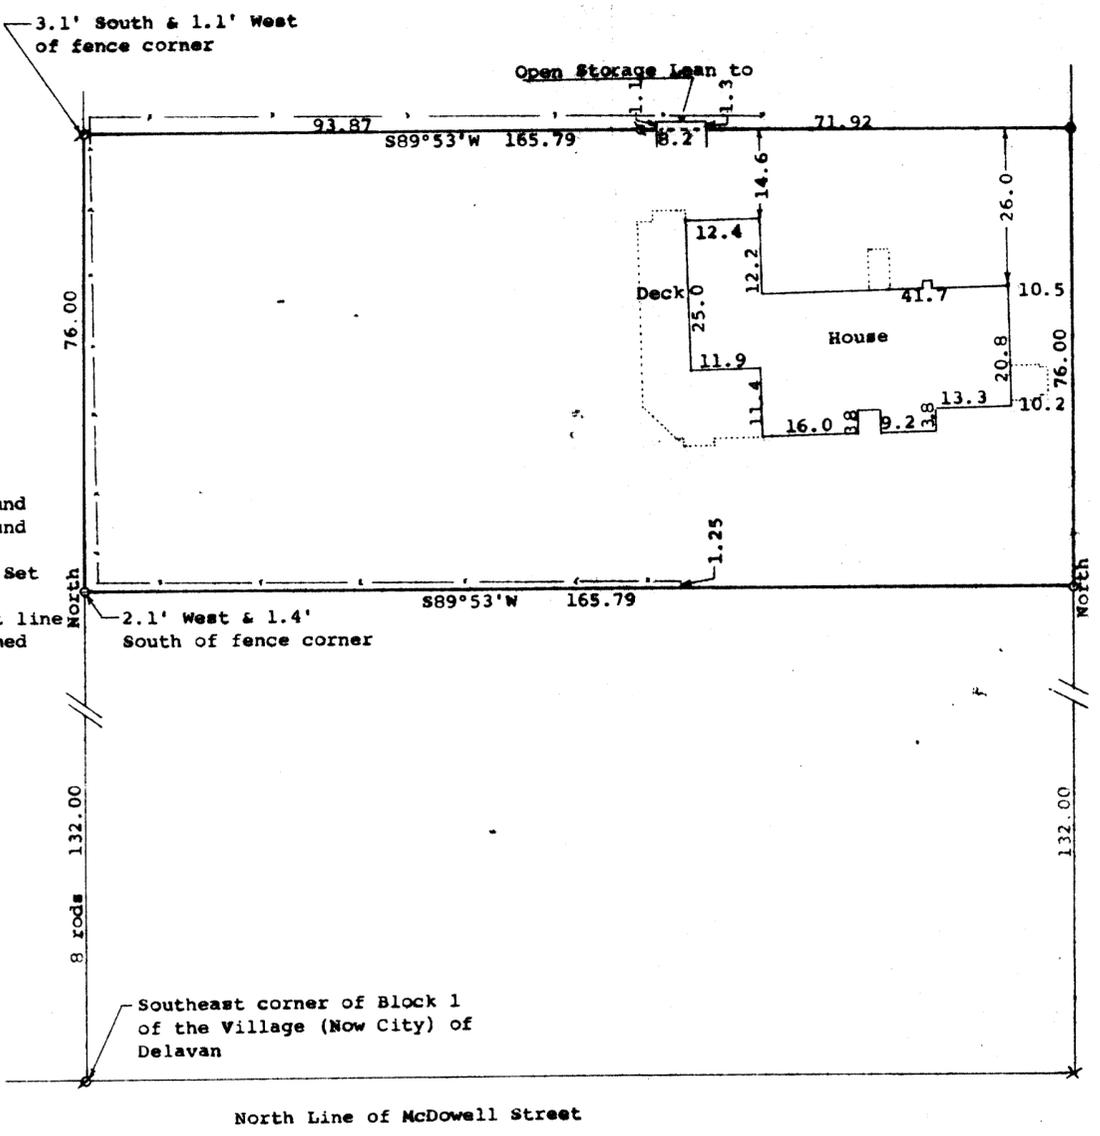

Scale - 1" = 20'

• = Concrete Monument Found
 X = Cross in Concrete Found
 S = 3/4" Iron Pipe Found
 O = 3/4" X 24" Iron Pipe Set
 --- = Fence Line

Bearings referenced to the west line of Fourth Street with the assumed bearing of North

Survey ordered by:
 Cristi Lee Schramski
 210 North 4th Street
 Delavan, WI 53115

Q = 1" Iron Pipe Found

STATE OF WISCONSIN) ss
 COUNTY OF WALWORTH)

I, George T. Dunham, Surveyor, certify that I have surveyed the property described as follows:

A parcel of land located in the Northeast 1/4 of Section 18, T 2 N, R 16 E, City of Delavan, Walworth County, Wisconsin, described as follows: Commencing at the southeast corner of Block 1 of the Original Plat of the Village (Now City) of Delavan; thence North 8 rods to the place of beginning; thence East 10 rods; thence North 76.00 feet; thence West 10 rods; thence South 76.00 feet to the place of beginning.

and that the plat shown hereon is a correct representation thereof and shows the size and location of the property, its exterior boundaries, the location of all visible structures and dimensions of all principal buildings thereon, boundary fences, apparent easements, roadways and visible encroachments, if any, and that I have surveyed the property hereon described, according to the of official records, to the best of my knowledge and belief.

March 19, 1991

George T. Dunham
 George T. Dunham, Surveyor

