


DUNHAM SURVEYING, S. C.
SURVEYING & SUBDIVIDING
DELAVER, WISCONSIN 53115



EIGHTH

STREET

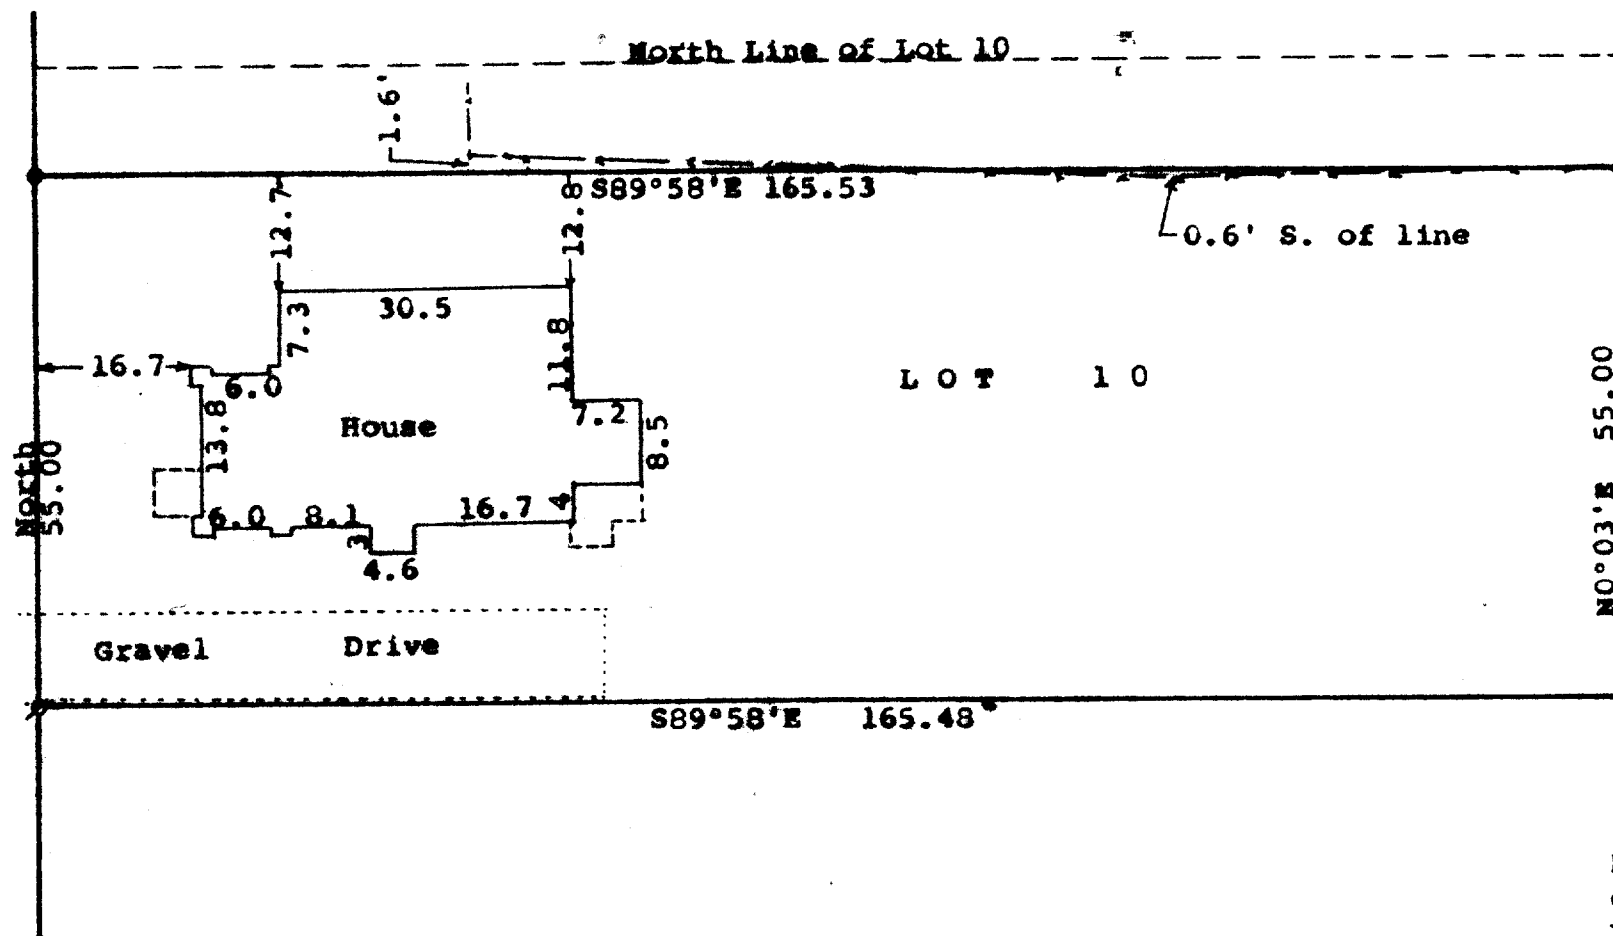

Scale - 1" = 20'
● = 1 1/4" Iron Pipe Found
○ = 1" Iron Pipe Found
○ = 3/4" Iron Pipe Found
Bearings referenced to the east line of Eighth Street with the assumed bearing of North
Survey ordered by:
RE/MAX Lake Geneva
18 West Geneva Street
P.O. Box 955
Williams Bay, WI 53191
--- = Fence Line

STATE OF WISCONSIN)
COUNTY OF WALWORTH)

I, George T. Dunham, Surveyor, certify that I have surveyed the property described as follows:

The South 55.00 feet of Lot 10 in Block 20 of Passage, Aram, and Downie Addition to the City of Delavan, Walworth County, Wisconsin,

and that plat shown hereon is a correct representation thereof and shows the size and location of the property, its exterior boundaries, the location of all visible structures and dimensions of all principal buildings thereon, boundary fences, apparent easements, roadways and visible encroachments, if any, and that I have surveyed the property hereon described, according to the official records, to the best of my knowledge and belief.

May 9, 1991

George T. Dunham
George T. Dunham, Surveyor

