


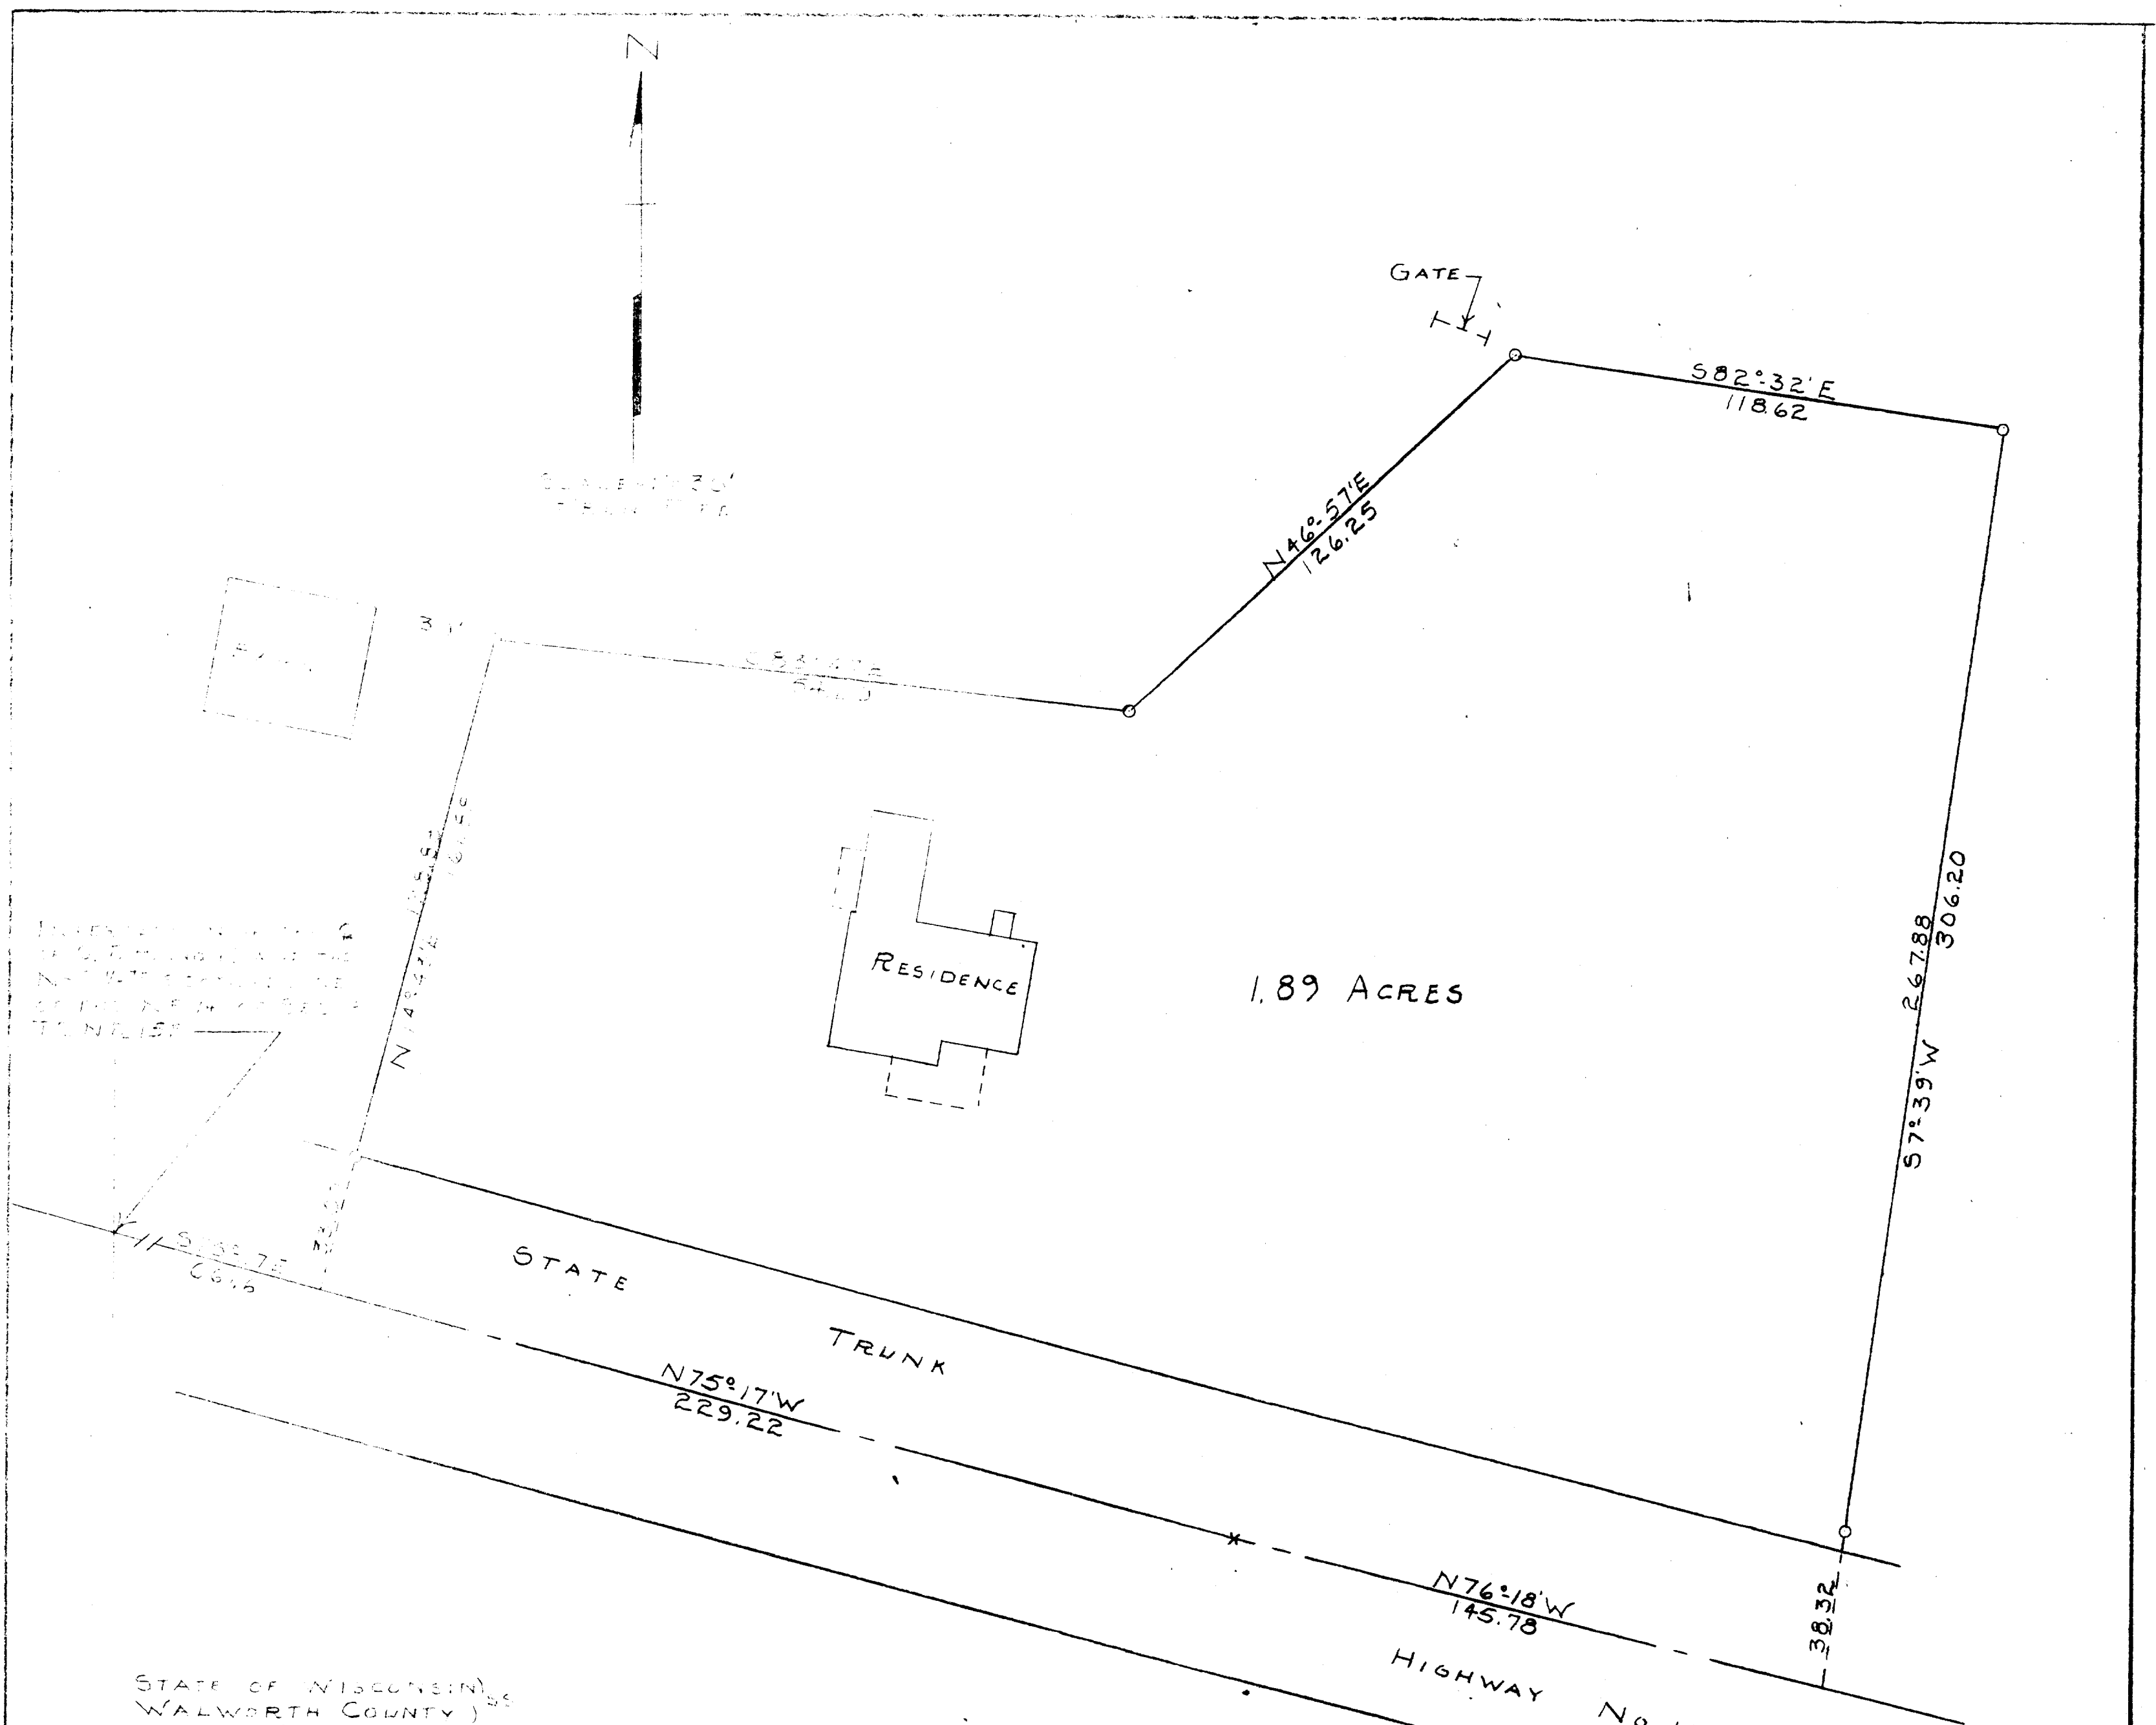

STATE OF WISCONSIN)
WALWORTH COUNTY)

I, GEORGE T. DUNHAM, DO HEREBY CERTIFY THAT I HAVE SURVEYED THE PROPERTY DESCRIBED AS FOLLOWS:

A PARCEL OF LAND LOCATED IN THE NE 1/4 OF SECTION 13, T2N, R15E OF THE 4TH P.M., WALWORTH COUNTY, WISCONSIN, DESCRIBED AS FOLLOWS, TO-WIT: COMMENCING AT THE INTERSECTION OF THE CENTERLINE OF STATE TRUNK HIGHWAY NO. 11 AND THE NORTH-SOUTH 1/8TH SECTION LINE OF THE NORTHEAST 1/4 OF SAID SECTION 13; THENCE S 75° 17' E ALONG THE CENTERLINE OF SAID HIGHWAY 661.6 FEET TO THE PLACE OF BEGINNING; THENCE N 14° 43' E 161.88 FEET; THENCE S 83° 47' E 154.20 FEET; THENCE N 46° 57' E 126.25 FEET; THENCE S 82° 32' E 118.62 FEET; THENCE S 7° 39' W 306.20 FEET TO THE CENTERLINE OF STATE TRUNK HIGHWAY NO. 11; THENCE NORTHWESTERLY ALONG THE CURVE OF SAID CENTERLINE TO A POINT LOCATED N 76° 18' W 145.78 FEET FROM THE LAST MENTIONED POINT; THENCE N 75° 17' W ALONG THE CENTERLINE OF SAID HIGHWAY 229.22 FEET TO THE PLACE OF BEGINNING CONTAINING 1.89 ACRES OF LAND MORE OR LESS. AND THAT THE PLAT SHOWN ABOVE IS A CORRECT REPRESENTATION OF THE PROPERTY LINES SO SURVEYED.

Nov. 20, 1959

George T. Dunham
GEORGE T. DUNHAM
WIS. LAND SURVEYOR REG NO 306
DELAVER, WISCONSIN