


DUNHAM SURVEYING, S.C.
SURVEYING & SUBDIVISION
DELAVER, WISCONSIN 53115

SYCAMORE

STREET

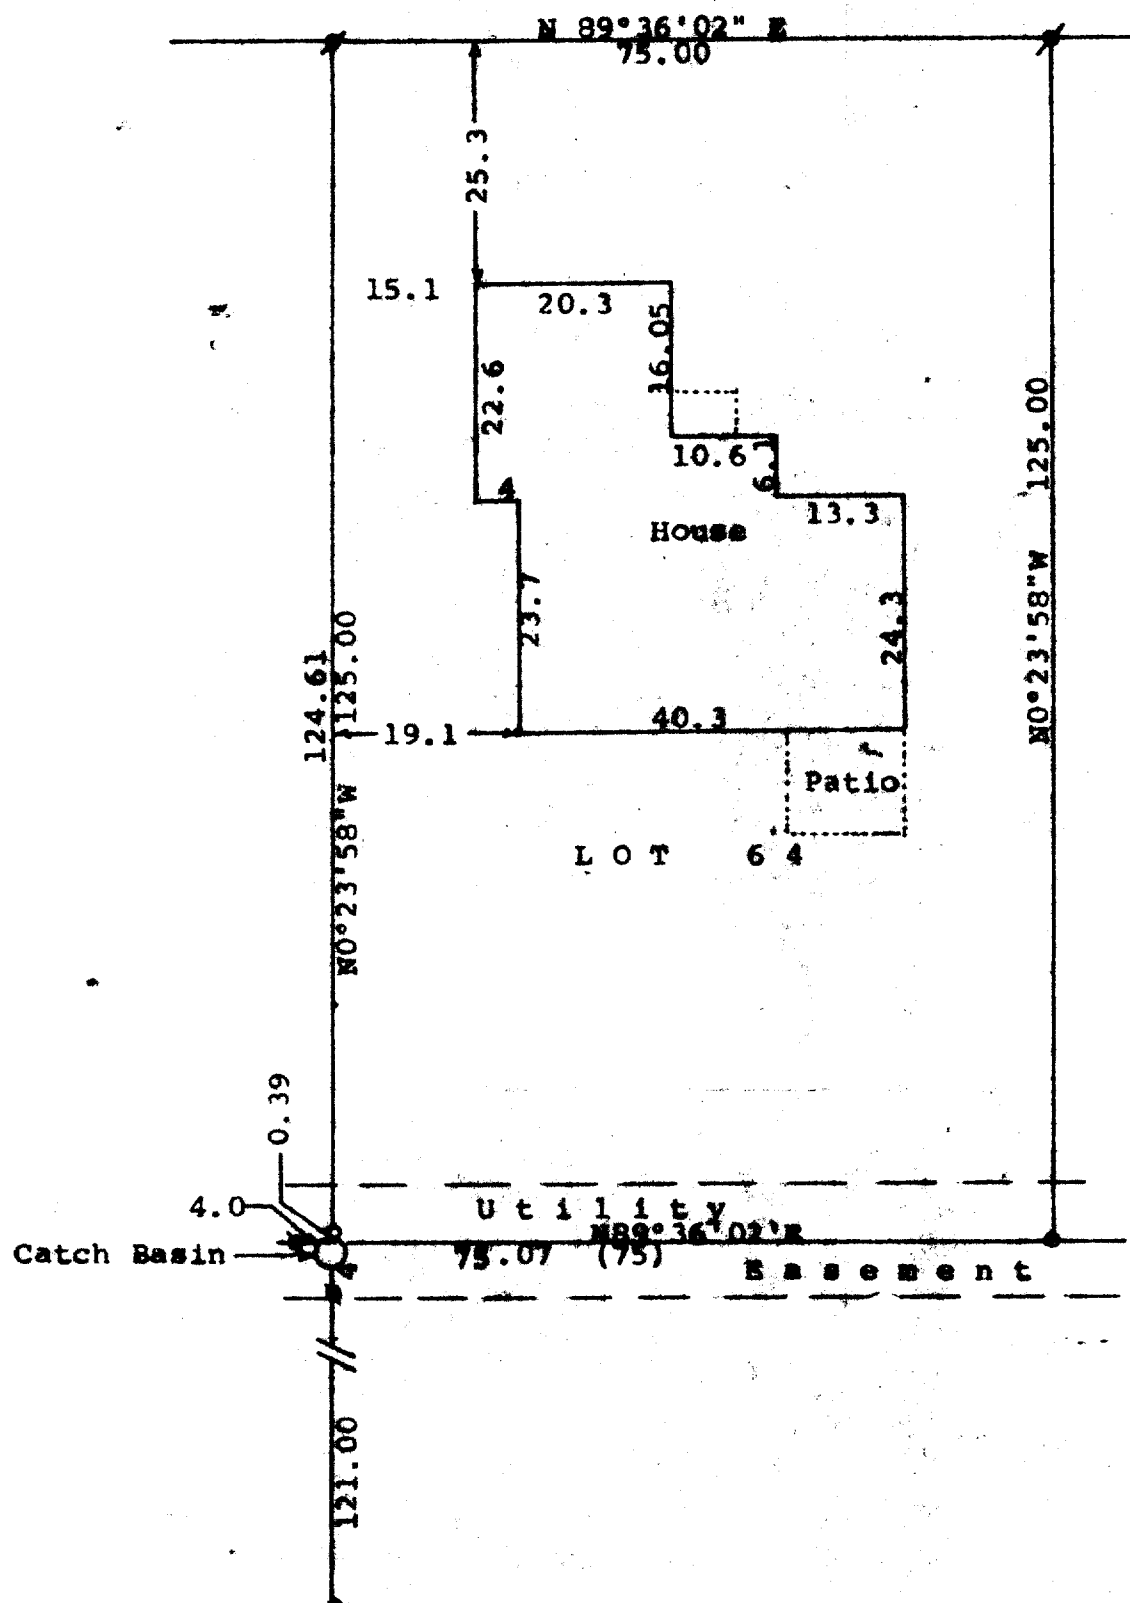

N

Scale - 1" = 20'

- = 5/8" Dia. Iron Rod Found
- = 1" Iron Pipe Found
- ▲ = 3/4" Iron Pipe Found
- = 3/4" X 24" Iron Pipe Set

Bearings are those shown of the recorded plat of Turtle Creek

Survey ordered by: Arleigh Aschebrook
433 Turtle Creek Drive
Delavan, WI 53115

(0.00) = Recorded distance

STATE OF WISCONSIN)
COUNTY OF WALNORTH)

I, George T. Dunham, Surveyor, certify that I have surveyed the property described as follows:

Lot 64 of Turtle Creek, a subdivision located in the Southeast 1/4 of Section 13, T.2 N, R.15 E, City of Delavan, Walworth County, Wisconsin and that the plat shown hereon is a correct representation thereof and shows the size and location of the property, its exterior boundaries, the location of all visible structures and dimensions of all principal buildings thereon, boundary fences, apparent easements, roadways and visible encroachments, if any, and that I have surveyed the property hereon described according to the official records, to the best of my knowledge and belief.
October 24, 1990

George T. Dunham
George T. Dunham, Surveyor

