


DUNHAM SURVEYING, S.C.
SURVEYING & SUBDIVIDING
DELAVER, WISCONSIN 53115

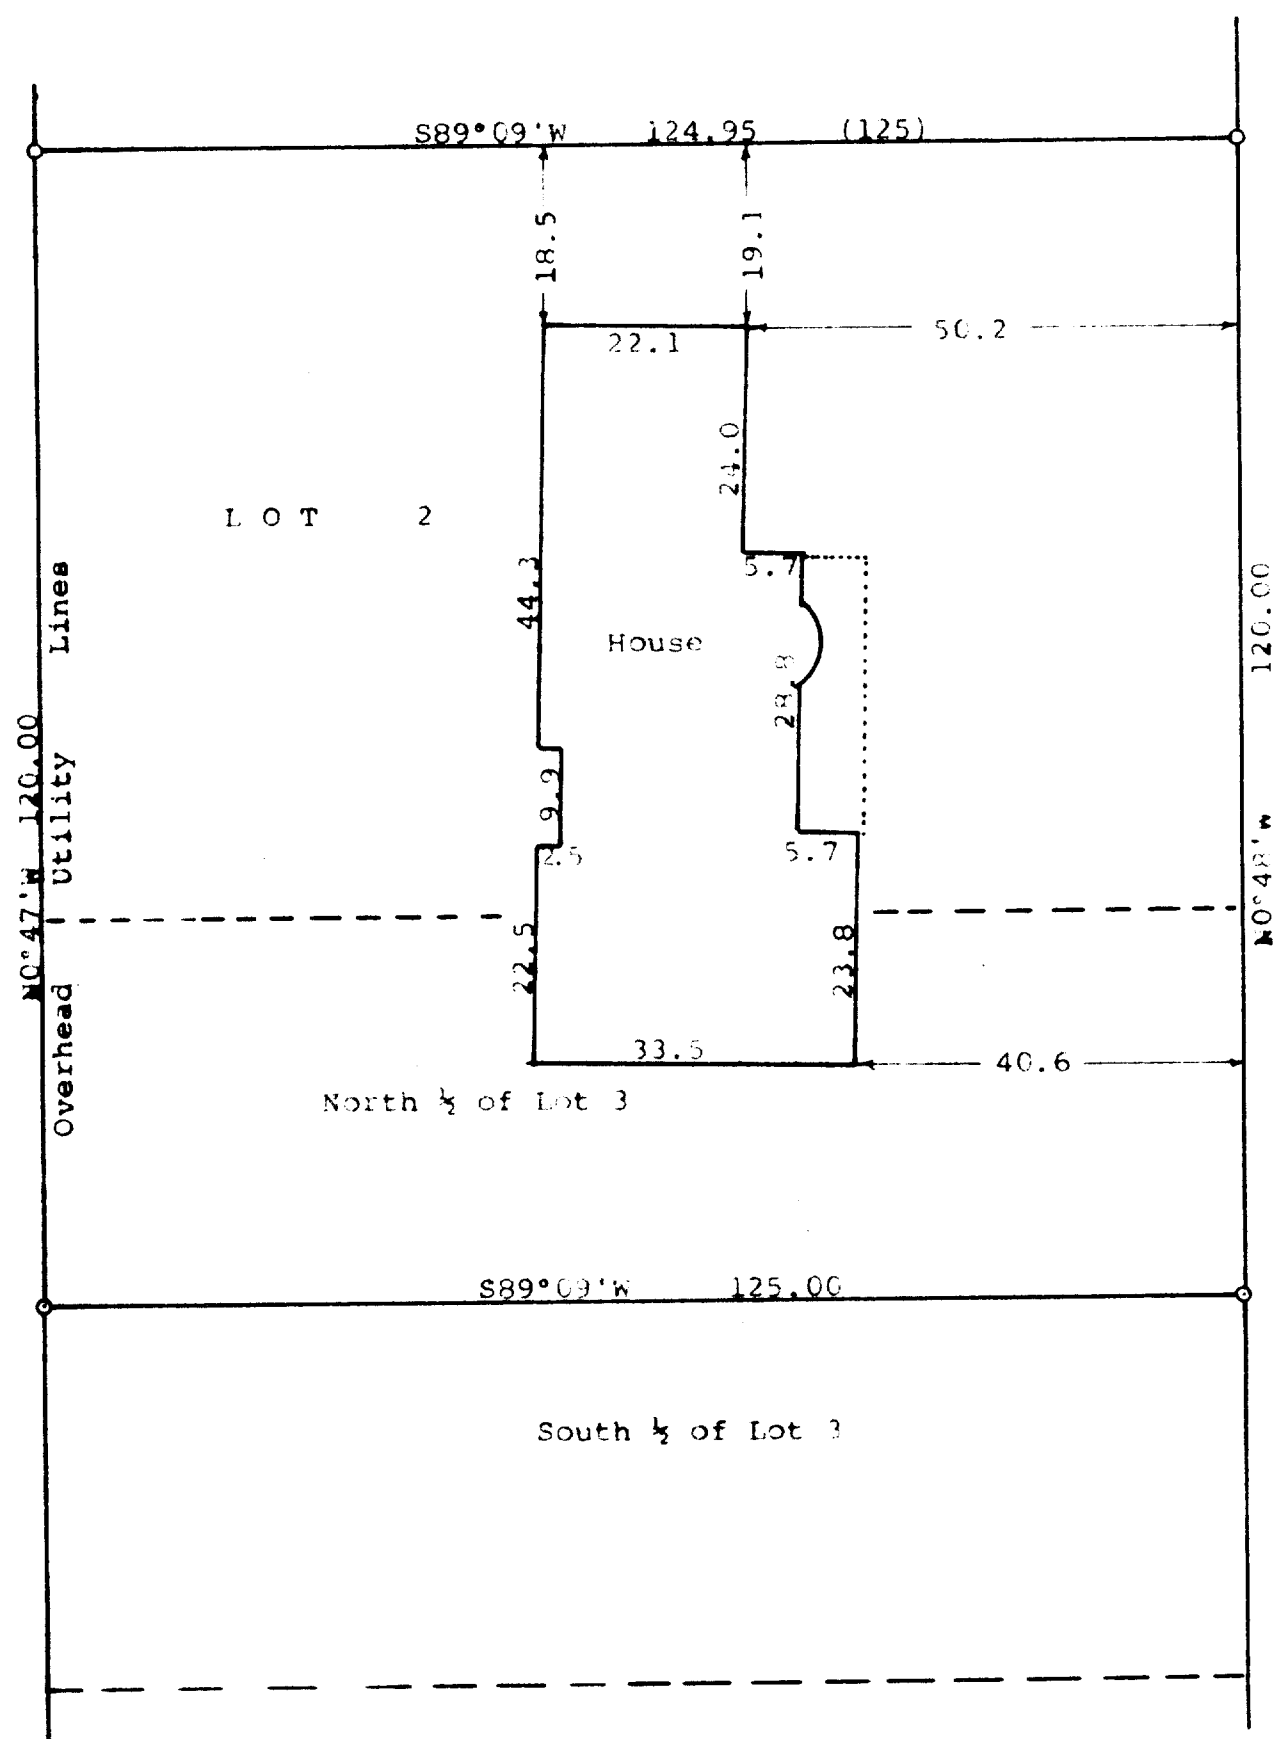

Scale - 1" = 20'
o = 1" Iron Pipe Found
(0.00) = recorded distance
Bearings referenced to the recorded bearing
of N0°48'W along the west line of Tyrell
Avenue.
Survey ordered by:
Dennis Positano
608 Tyrell Avenue
Delavan, WI 53115

STATE OF WISCONSIN) SS
COUNTY OF WALWORTH)

I, George T. Dunham, Surveyor, certify that I have surveyed the
property described as follows:

Lot 2 and the North 1/4 of Lot 3, located in Block 5 of Allynhurst
Subdivision located in the City of Delavan, Walworth County,
Wisconsin.

and that the plat shown hereon is a correct representation thereof and shows
the size and location of the property, its exterior boundaries, the location
of all visible structures and dimensions of all principal buildings thereon,
boundary fences, apparent easements, roadways and visible encroachments, if
any, and that I have surveyed the property hereon described, according to the
official records, to the best of my knowledge and belief.

May 8, 1991

George T. Dunham
George T. Dunham, Surveyor

