


ABELL
SURVEYING & MAPPING
DELAVER, WISCONSIN 53115
414-728-6737

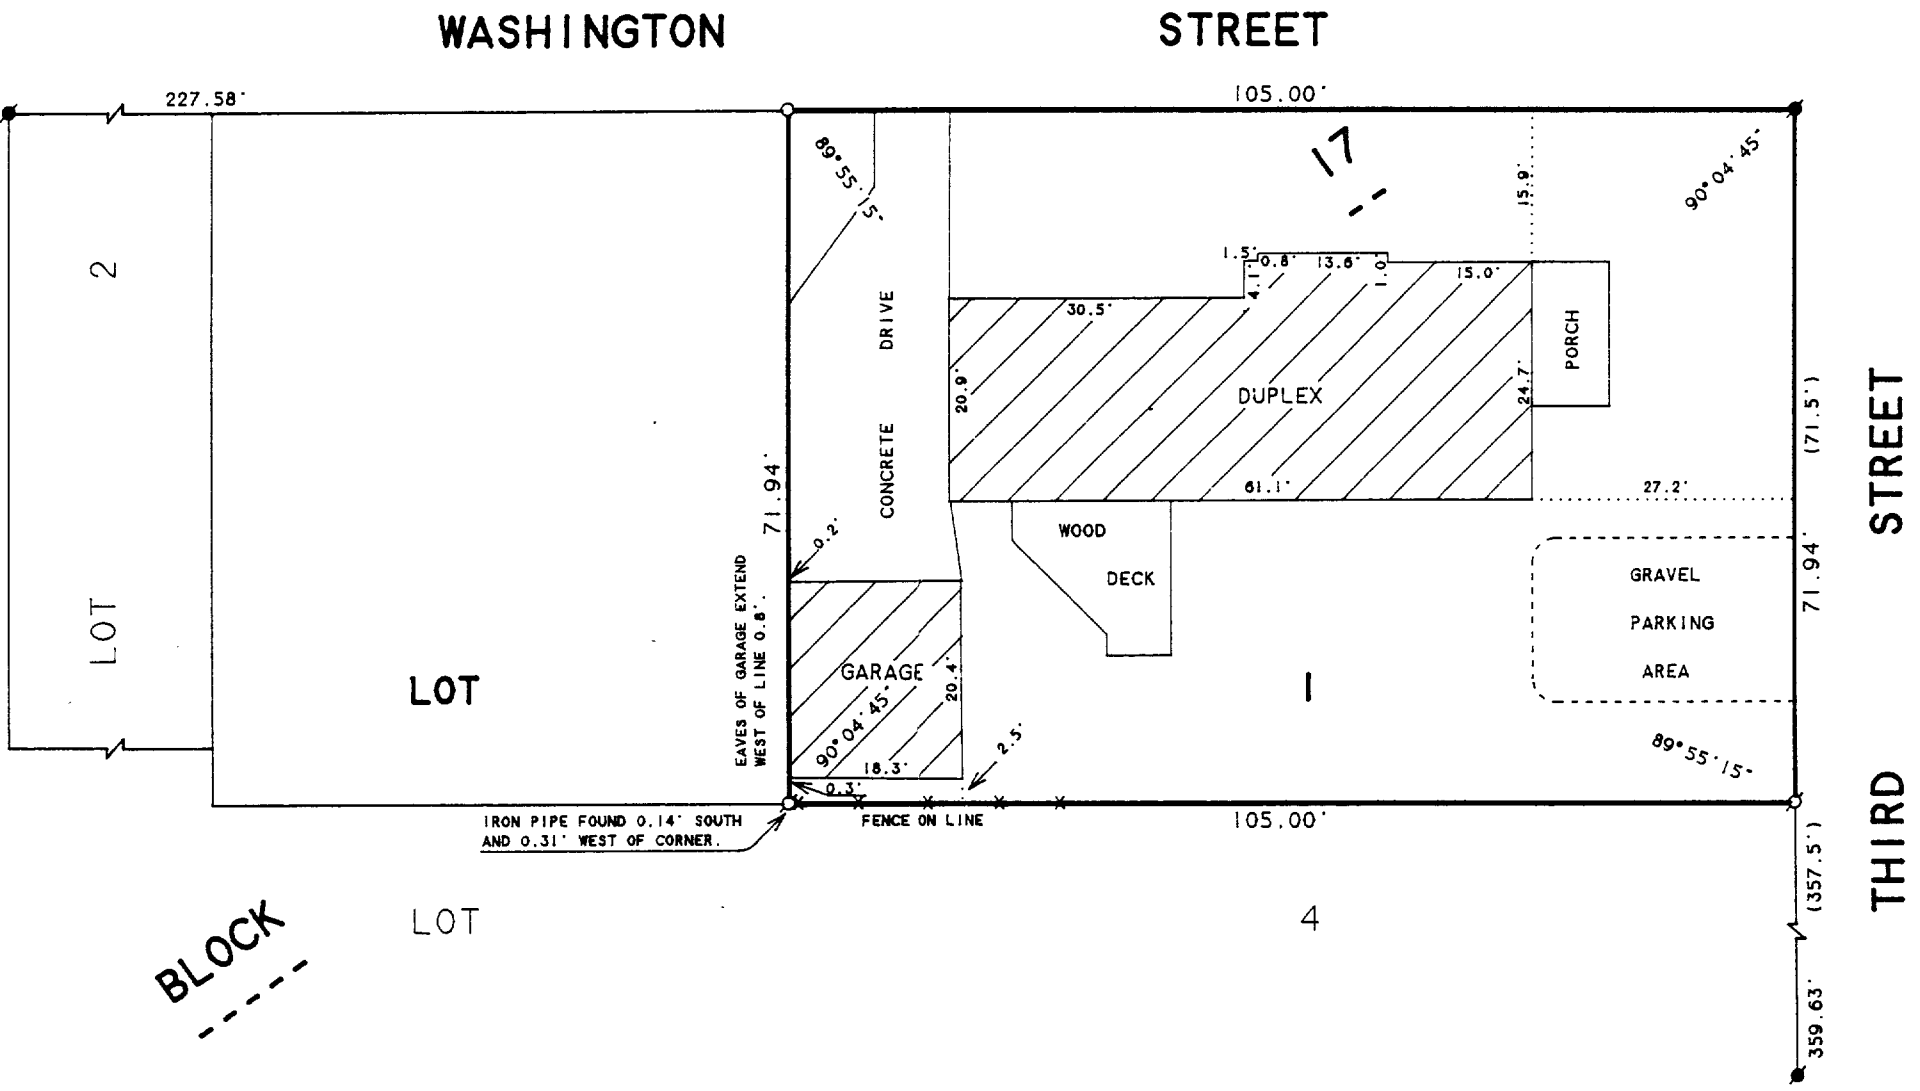


SCALE 1"=20'
LEGEND

- - IRON PIPE FOUND
- - CONCRETE MONUMENT FOUND
- ⊙ - IRON PIPE SET
- ✕ - CHAIN LINK FENCE
- () - RECORDED AS

PLAT OF SURVEY OF

THE EAST 105 FEET OF LOT 1, BLOCK 17, OF THE
ORIGINAL PLAT OF THE CITY OF DELAVER, WALWORTH
COUNTY, WISCONSIN.

ORDERED BY: JOHN BOUMENOT
P.O. BOX 653
DELAVER, WI. 53115

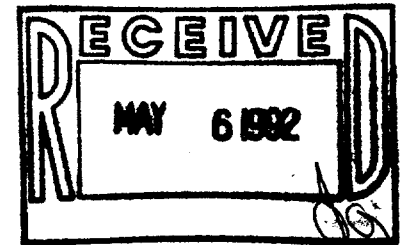

I, DAVID F. ABELL, DO HEREBY CERTIFY THAT I HAVE SURVEYED THE PROPERTY HEREON
DESCRIBED ACCORDING TO THE OFFICIAL RECORDS AND THAT THE PLAT HEREON IS A
CORRECT REPRESENTATION OF THE PROPERTY LINES TO THE BEST OF MY KNOWLEDGE AND
BELIEF.

David F. Abell

DAVID F. ABELL
WISCONSIN REGISTERED LAND SURVEYOR, S-1596

January 6, 1992

DATE: January 6, 1992 JOB NUMBER - 91226
NOTE: THIS IS NOT A CERTIFIED COPY UNLESS SEALED.

002-1157

XOP-176